

RAMSEY COUNTY
LOAN & TRUST COMPANY'S
SUBDIVISION NUMBER 5

This plat document is an UNOFFICIAL copy of a Subdivision Plat or Registered Land Survey and is made available for information purposes only.




To obtain an official copy please contact the Ramsey County Recorder's Office.

STATE OF MINNESOTA, 1886.
County of Ramsey.
Office of the Registrar of Deeds.
This is to certify that the within instrument was filed for Record in this Office, at St. Paul, on the 1st day of April, A. D. 1886, at 4:30 o'clock P. M., and that the same is duly recorded in Book 1 of 1886 pages 22.
R. C. Wiley, Registrar of Deeds.
By _____ Deputy.

22

April 1st 1886
Taxes paid
James O'Brien
Co Auditor
Per J. P. Dingelby Deputy

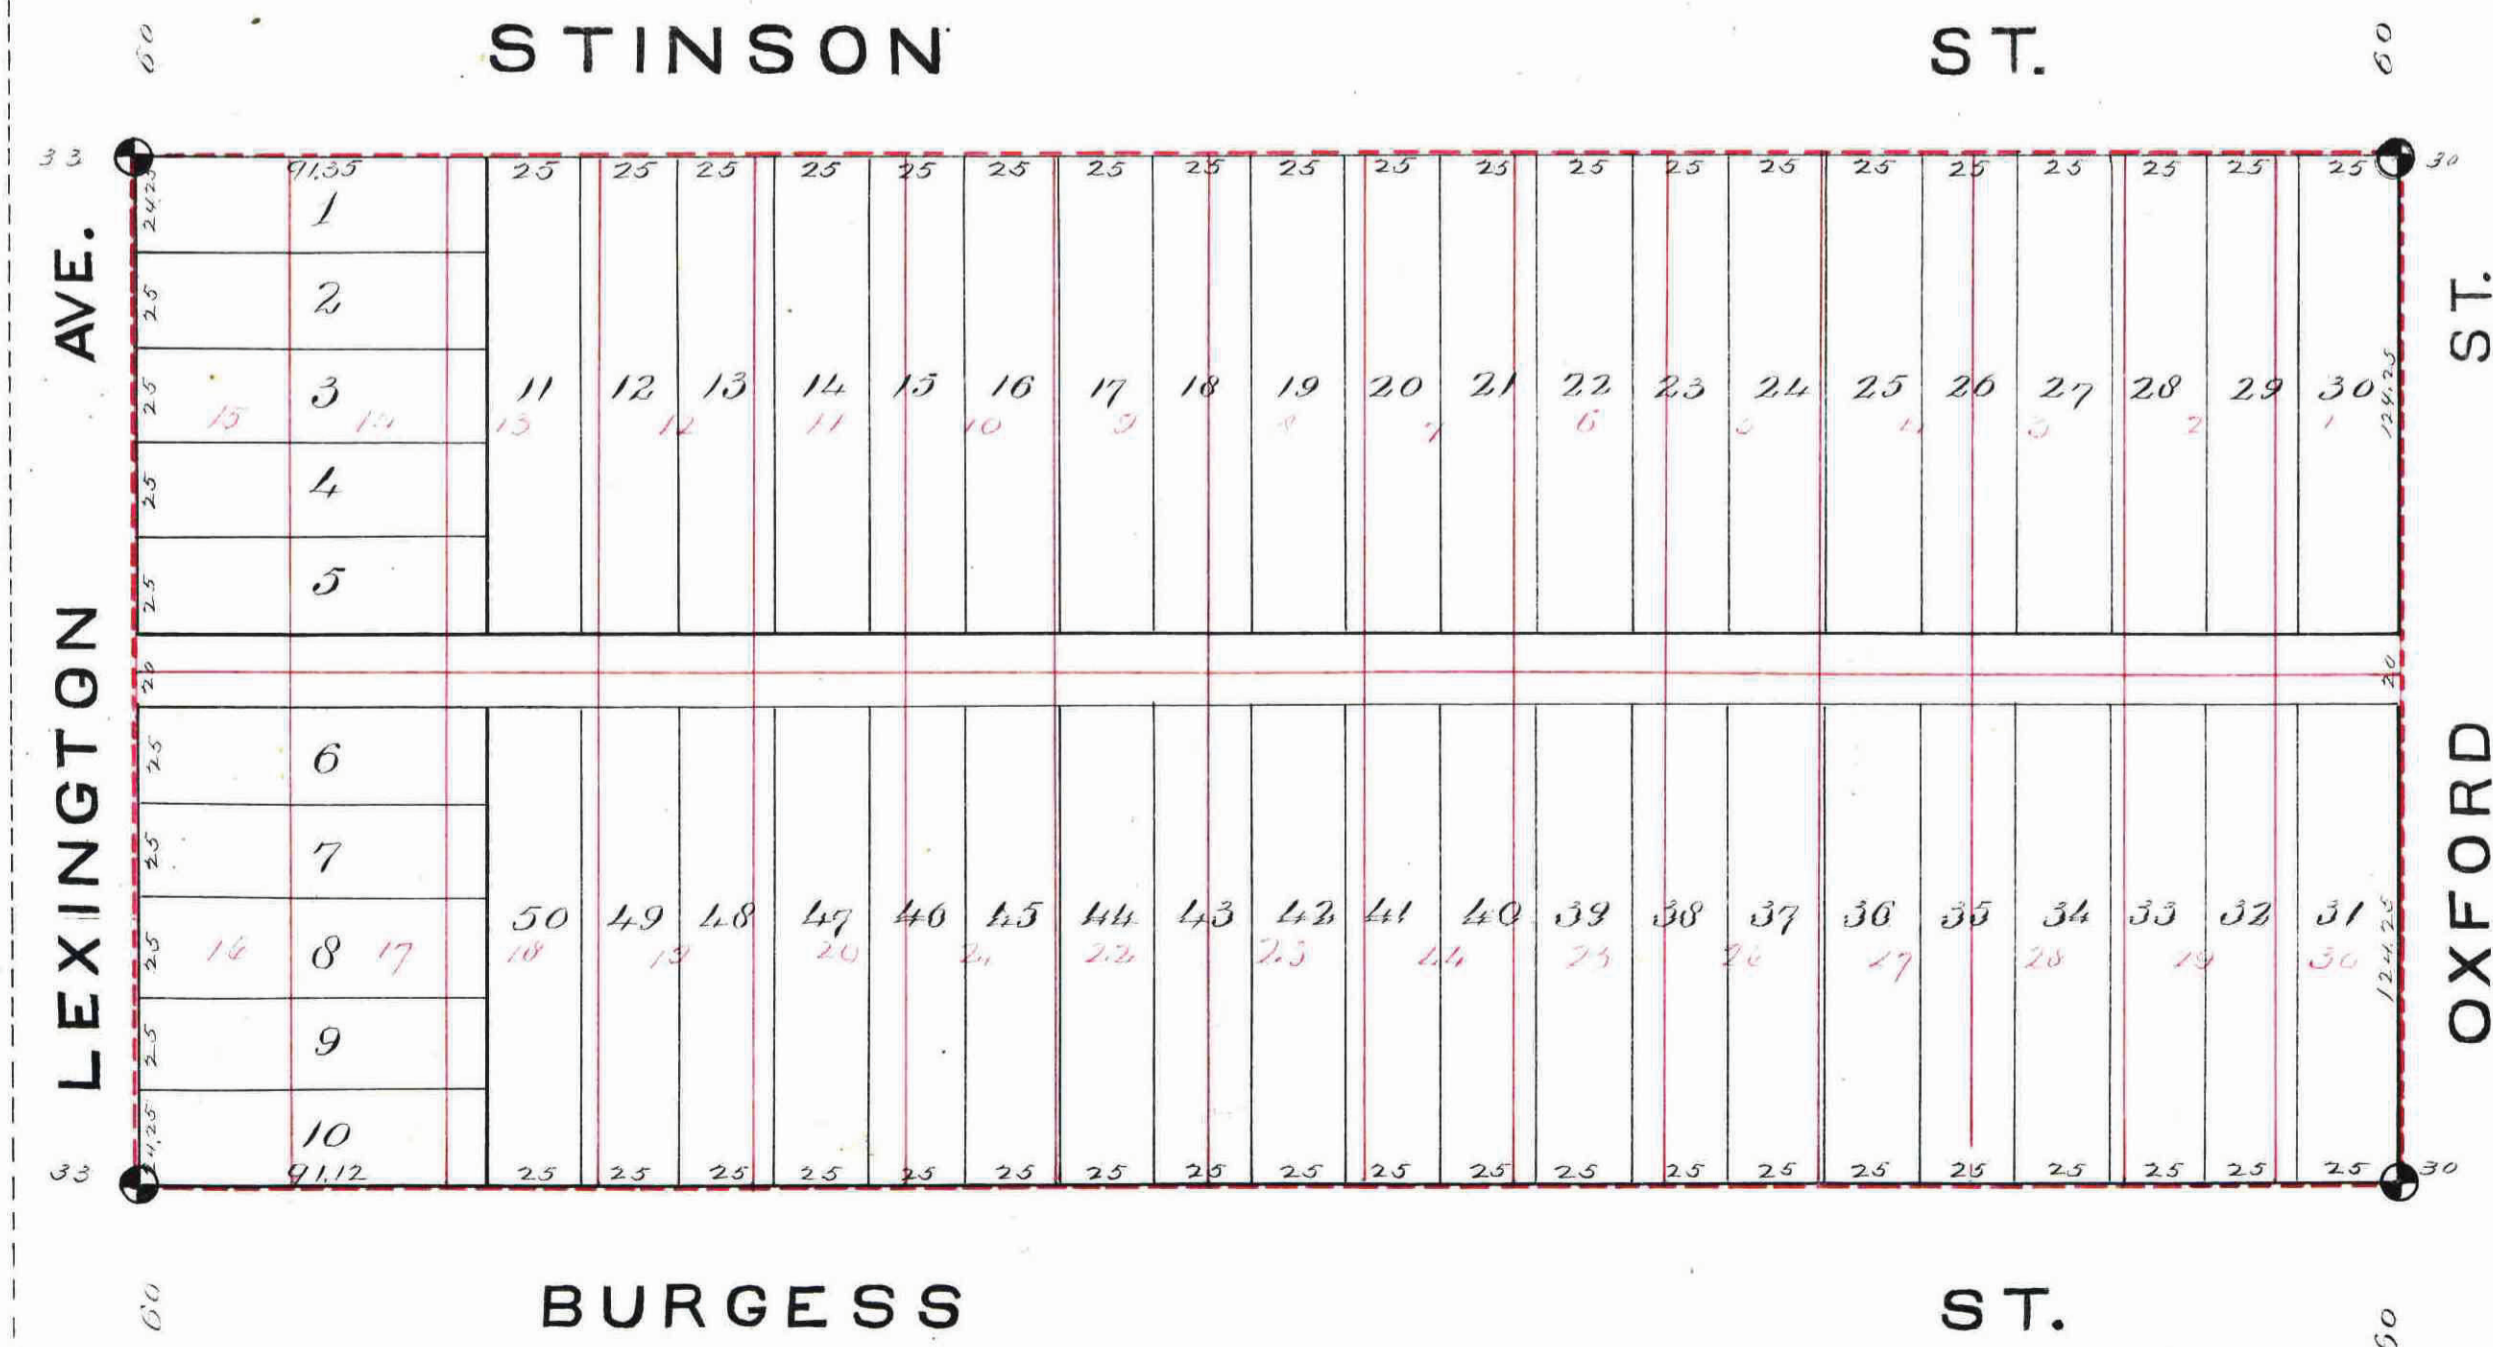

We certify that we have surveyed and plotted the property described on this plat as Ramsey County Loan and Trust Company's Subdivision number 5. That there are iron monuments at the corners as shown on this plat - that this is a correct plat of said survey.
Hawley and Newell
Civil Engineers.

State of Minnesota } s.s.
County of Ramsey }
On the 24th day of March 1886 personally came before me J. B. Hawley of the firm of Hawley and Newell to me well known, and acknowledged that he executed the above certificate as his own free act and deed for and in behalf of said firm -
J. B. Hawley
Notary Public Ramsey County, Minnesota.

This is to certify that the Ramsey County Loan and Trust Company the proprietor of Ramsons Division Number 5, has caused the same to be surveyed and plotted and hereafter known as Ramsey County Loan and Trust Company Subdivision Number 5, and we hereby dedicate to the public and for the public use forever the alley as hereon indicated -
Signed and sealed on the 23rd day of March 1886 by A. V. Topley President,
In the presence of
Jas. McDonald }
G. Englund }
and by C. A. Stinson Secretary.

State of Minnesota } s.s.
County of Ramsey }
On the 23rd day of March 1886 personally appeared before me, A. V. Topley, and C. A. Stinson to me personally known, who being duly sworn each did say that they are the president and secretary of the Ramsey County Loan and Trust Company, a corporation of the State of Minnesota, and grantor in the foregoing certificate, that the seal affixed to said instrument is the corporate seal of said corporation, and that said instrument was signed and sealed in behalf of said corporation and by authority of the Board of Directors, and that said A. V. Topley and C. A. Stinson acknowledge said instrument to be the free act and deed of said corporation.
Jas. McDonald
Notary Public Ramsey County, Minnesota.

Approved by the Plat Commission on the 24th day of March 1886.
C. A. Stinson } Plat Commission
J. P. Peterson }
Jas. Starkey }
Examined and Approved on the day of March 27th 1886
R. W. Rundlett
Approved by the Common Council on the 27th day of April 1886.
COUNTY TREASURER,
ST. PAUL, MINN.
APR 1 1886
1886 PAID.
City Clerk