

25

**TUTTLES REARRANGEMENT**  
 OF  
**BLOCKS 10 11 13 AND PART OF BLOCK 4**  
 JACKSON AND BIDWELLS ADDITION TO WEST ST PAUL  
 SURVEYED BY  
 FORBES & LAWSON 357 JACKSON ST

We hereby certify to having surveyed and platted the property as described on this map as blocks 10, 11, 13 and part of block 4, Jackson and Bidwells addition to West St Paul, and have placed iron monuments at the corners of each and every block as shown in this map and the same is correct.

Chas A Forbes  
Forbes & Lawson  
 Surveyors

State of Minnesota }  
 County of Ramsey } On this 14<sup>th</sup> day of June, A.D. 1886 personally appeared before the undersigned Chas A Forbes of the firm of Forbes and Lawson, to me well known and acknowledged that they executed the foregoing certificate as their own free act and deed.

W. L. Barbeau  
 Notary Public  
 Ramsey Co Minn.

This is to certify that James Tuttle proprietor of blocks 10, 11, 13 & lots 3, 4 & 5 of block 4 Jackson and Bidwells addition to West St Paul has caused the same to be surveyed and platted, and hereafter known as Tuttle's rearrangement of blocks 10, 11, 13 and part of block 4 Jackson and Bidwells addition to West St Paul as shown by this plat, and hereby dedicates to the public and for the public use forever all the streets and avenues as herein indicated.

Witness our hand and seal this 15<sup>th</sup> day of June, 1886.  
James Tuttle  
W. L. Barbeau

State of Minnesota }  
 County of Ramsey } On this 15<sup>th</sup> day of June, A.D. 1886, personally came before me, the undersigned, James Tuttle to me well known and he acknowledged that he executed the foregoing certificate for the uses and purposes therein expressed.

W. L. Barbeau  
 Notary Public  
 Ramsey Co. Minn.


Accepted and approved this 15<sup>th</sup> day of June A.D. 1886  
J. P. Starkey } Plat Commissioners

I hereby recommend the acceptance of the within plat by the Common Council  
W. W. Arnold  
 City Engineer

Accepted by the common council of the city of St Paul on the 17<sup>th</sup> day of June 1886  
W. W. Arnold  
 City Clerk

Taxes June 21 1886  
James O'Brien  
 County Auditor  
 Ramsey Co Minn.

Assessments \_\_\_\_\_  
 \_\_\_\_\_  
 City Treasurer  
 St Paul Minn.  
J. A. Archibald

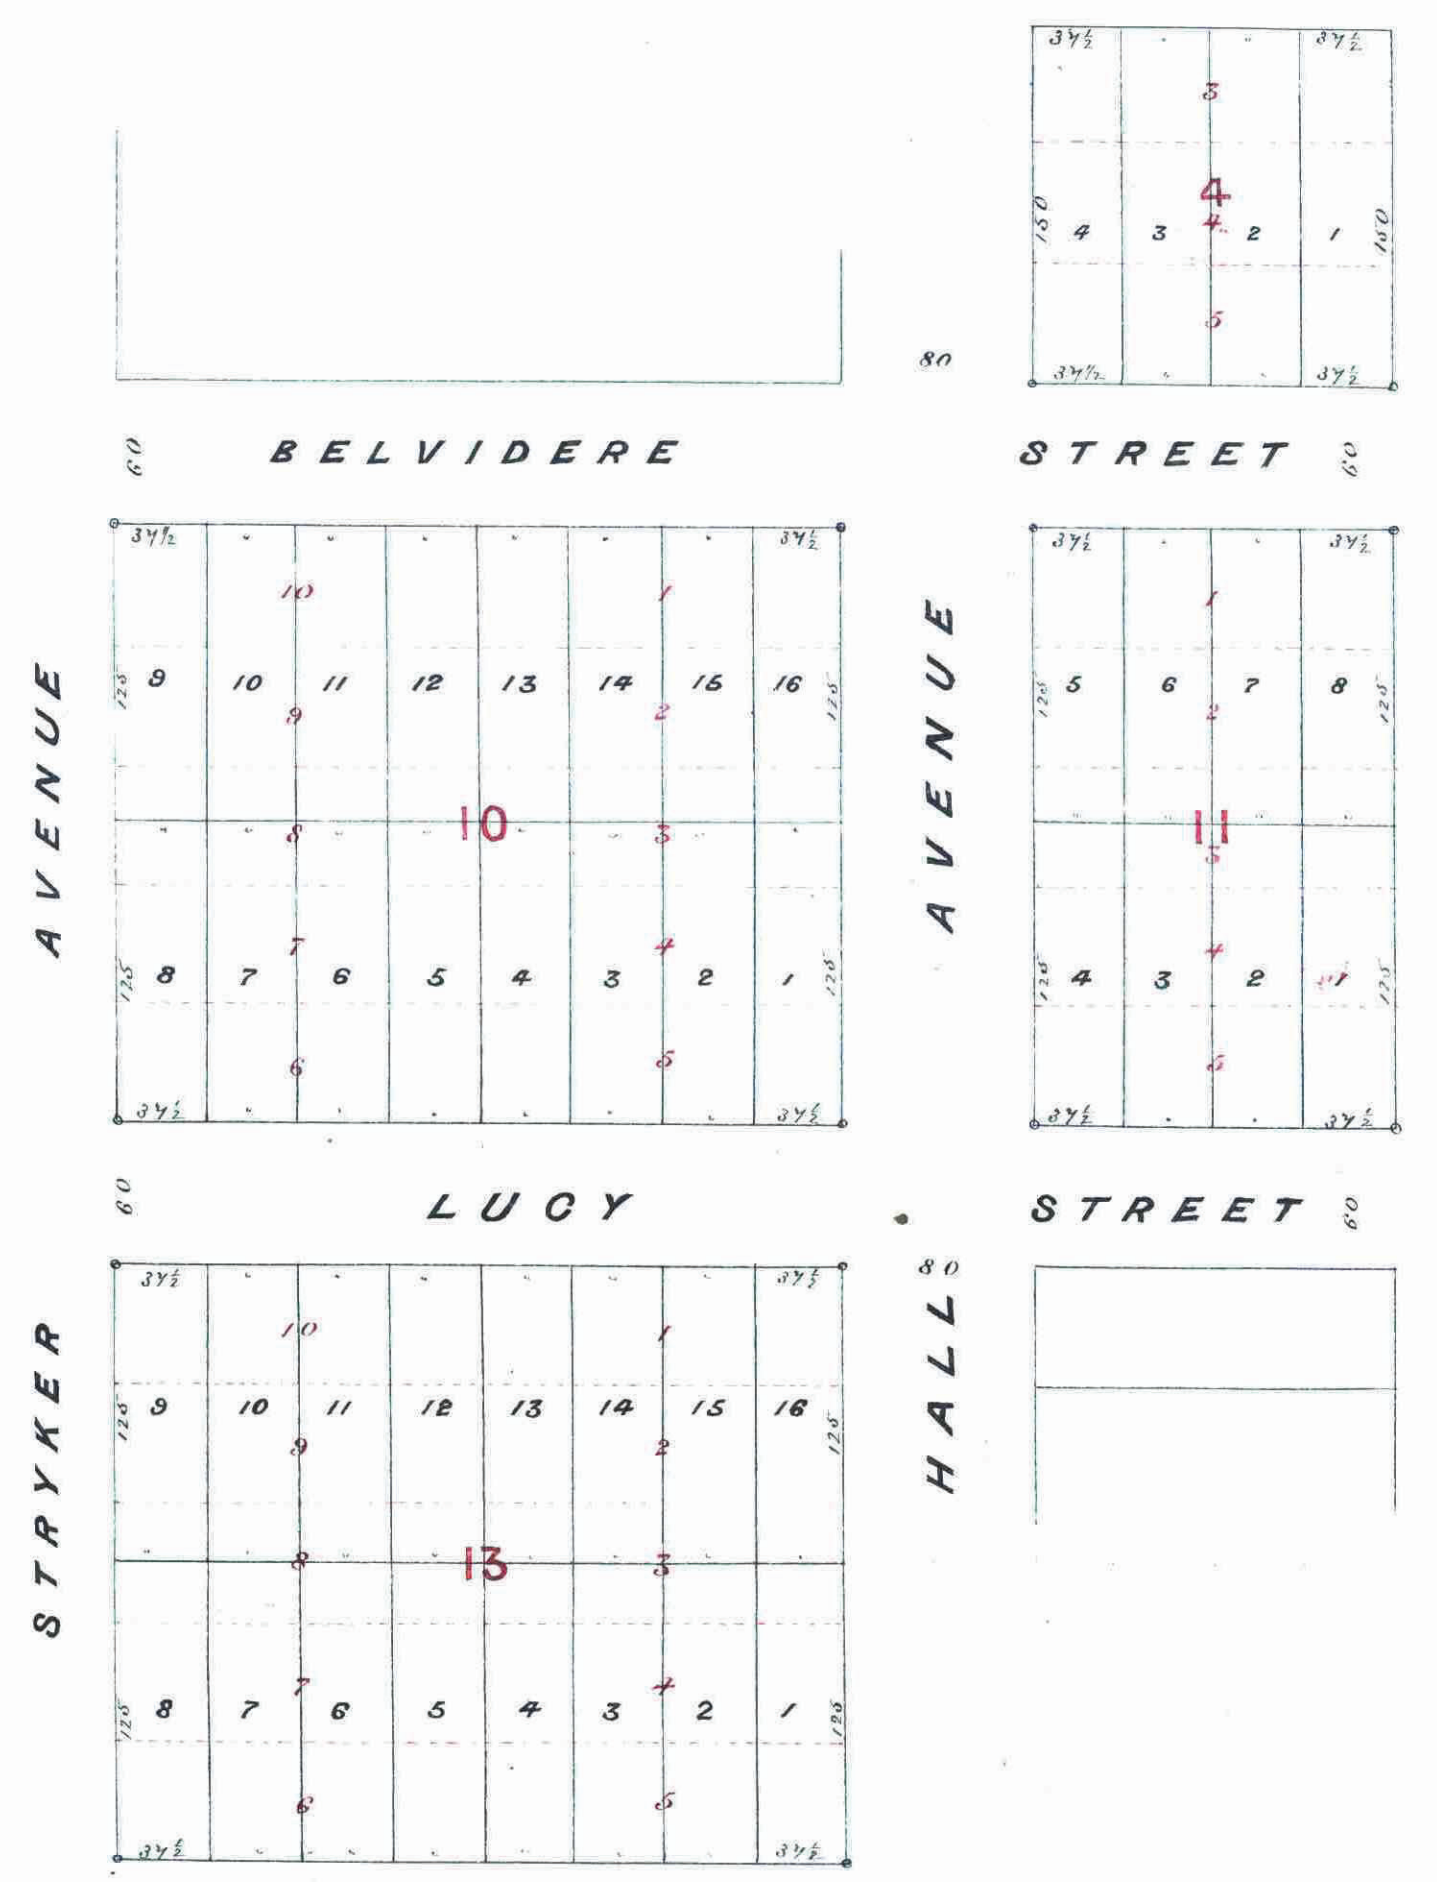

NOTE - Iron monuments.

STATE OF MINNESOTA, ss.  
 County of Ramsey, ss.  
 I, John C. Register, Register of Deeds.  
 This is to certify that the within instrument was filed for Record in this office at St Paul, on the 24<sup>th</sup> day of June, A.D. 1886 at 2:30 P.M., and that the same was recorded in Book No. 2 of \_\_\_\_\_ page 25.  
John C. Register  
 Register of Deeds.

This plat document is an UNOFFICIAL copy of a Subdivision Plat or Registered Land Survey and is made available for information purposes only.  
 To obtain an official copy please contact the Ramsey County Recorder's Office.