


22

WILLIAMS'

REARRANGEMENT OF BLOCK 17
OF WOODBURY & CASE'S ADDITION
TO WEST ST. PAUL.

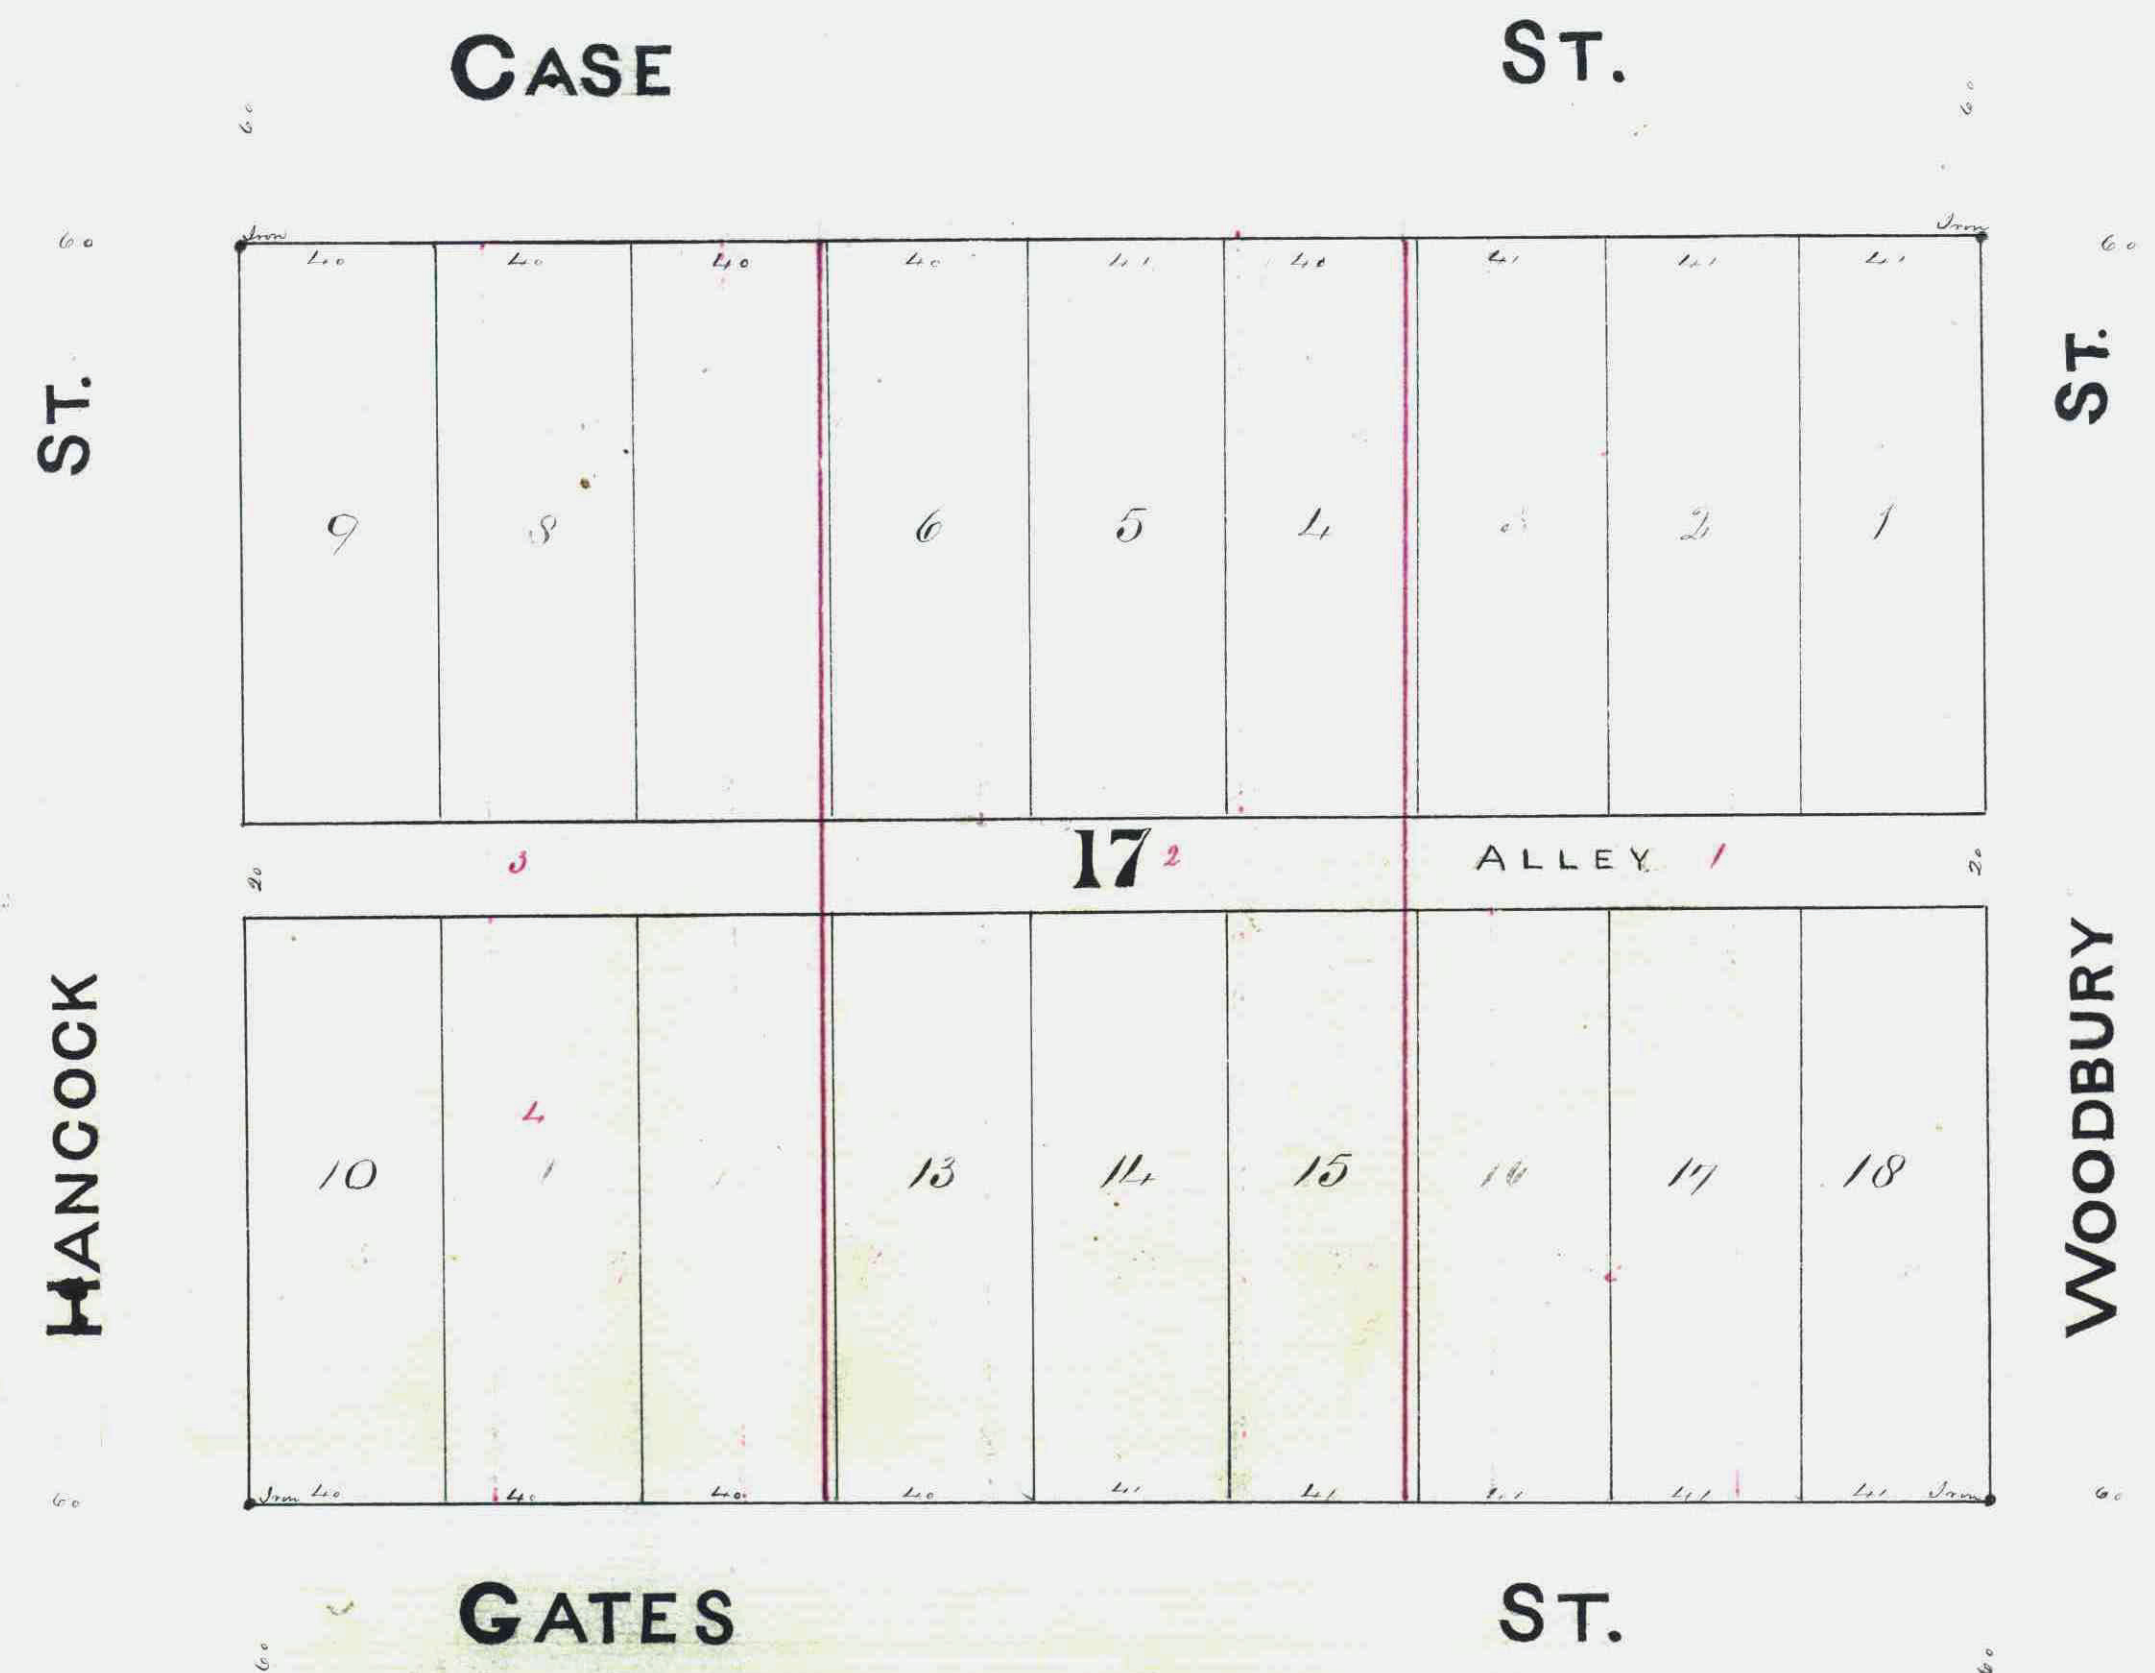

This plat document is an UNOFFICIAL copy of a Subdivision Plat or Registered Land Survey and is made available for information purposes only.

To obtain an official copy please contact the Ramsey County Recorder's Office.



The undersigned owner of Block 17 of Woodbury & Case's Addition to West Saint Paul Minnesota do hereby certify to having caused the same to be surveyed and platted as Williams rearrangement of Block 17 of Woodbury and Case's Addition to West Saint Paul Minnesota, as herein and hereon indicated, and to have been a party to the same and to have been an attorney.

In witness whereof have this 27th day of August 1883 set my hand and seal at Saint Paul, Minnesota.

In the presence of
 J. J. McCarly
 J. J. McCarly
 Ramsey County ss
 State of Minnesota

Robert A. Williams
 By J. A. Williams
 His attorney in fact

On this 27th day of August 1883 personally appeared before me [Name] to me known to be the identical person who executed the foregoing certificate, and acknowledged the same to be his free act and deed.


Notary Public
 Henry [Name]

I certify to having surveyed and platted the property described in this map as Rearrangement of Block 17 Woodbury and Case's Addition to Saint Paul Minnesota and have placed iron monuments at the corners as shown on this map and the same is correct.

J. B. Hawley
 Surveyor

Approved this 27th day of August 1883
 J. J. McCarly
 Notary Public

Plat Commission
 [Signature]

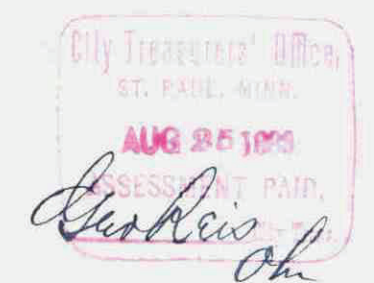

Lines and figures in red ink show original rearrangement and number of lots.

STATE OF MINNESOTA, ss.
 County of Ramsey,
 OFFICE OF THE REGISTER OF DEEDS.
 This is to certify that the within instrument was filed for Record in this office, at St. Paul, on the 27th day of August, D. 1883 at 12 o'clock P.M., and that the same was duly recorded in Book 22 of Maps

[Signature]
 Register of Deeds

Office of City Clerk,
 St. Paul, Minnesota
 Accepted by the Comm. Council this 27th day of August 1883
 [Signature]
 City Clerk

I do hereby certify that I have examined the above plat and recommend its approval.
 Aug 27 1883
 W. A. [Signature]

James paid and transfer entered this 15 day of August 1883
 J. J. McCarly
 Co. Secy
 Dean
 Spf.