


# SUBDIVISION OF LOT 36, COMO VILLAS.

STATE OF MINNESOTA, ss.  
County of Ramsey,  
Office of the Register of Deeds.  
This is to certify that the within instrument was filed for Record in this Office, at St. Paul, on the 12th day of April, A. D. 1887, at 4 o'clock P. M., and that the same was duly recorded in Book 6 of the records, pages 13.

By *J. S. Sewall*  
Register of Deeds.

This plat document is an UNOFFICIAL copy of a Subdivision Plat or Registered Land Survey and is made available for information purposes only.

To obtain an official copy please contact the Ramsey County Recorder's Office.

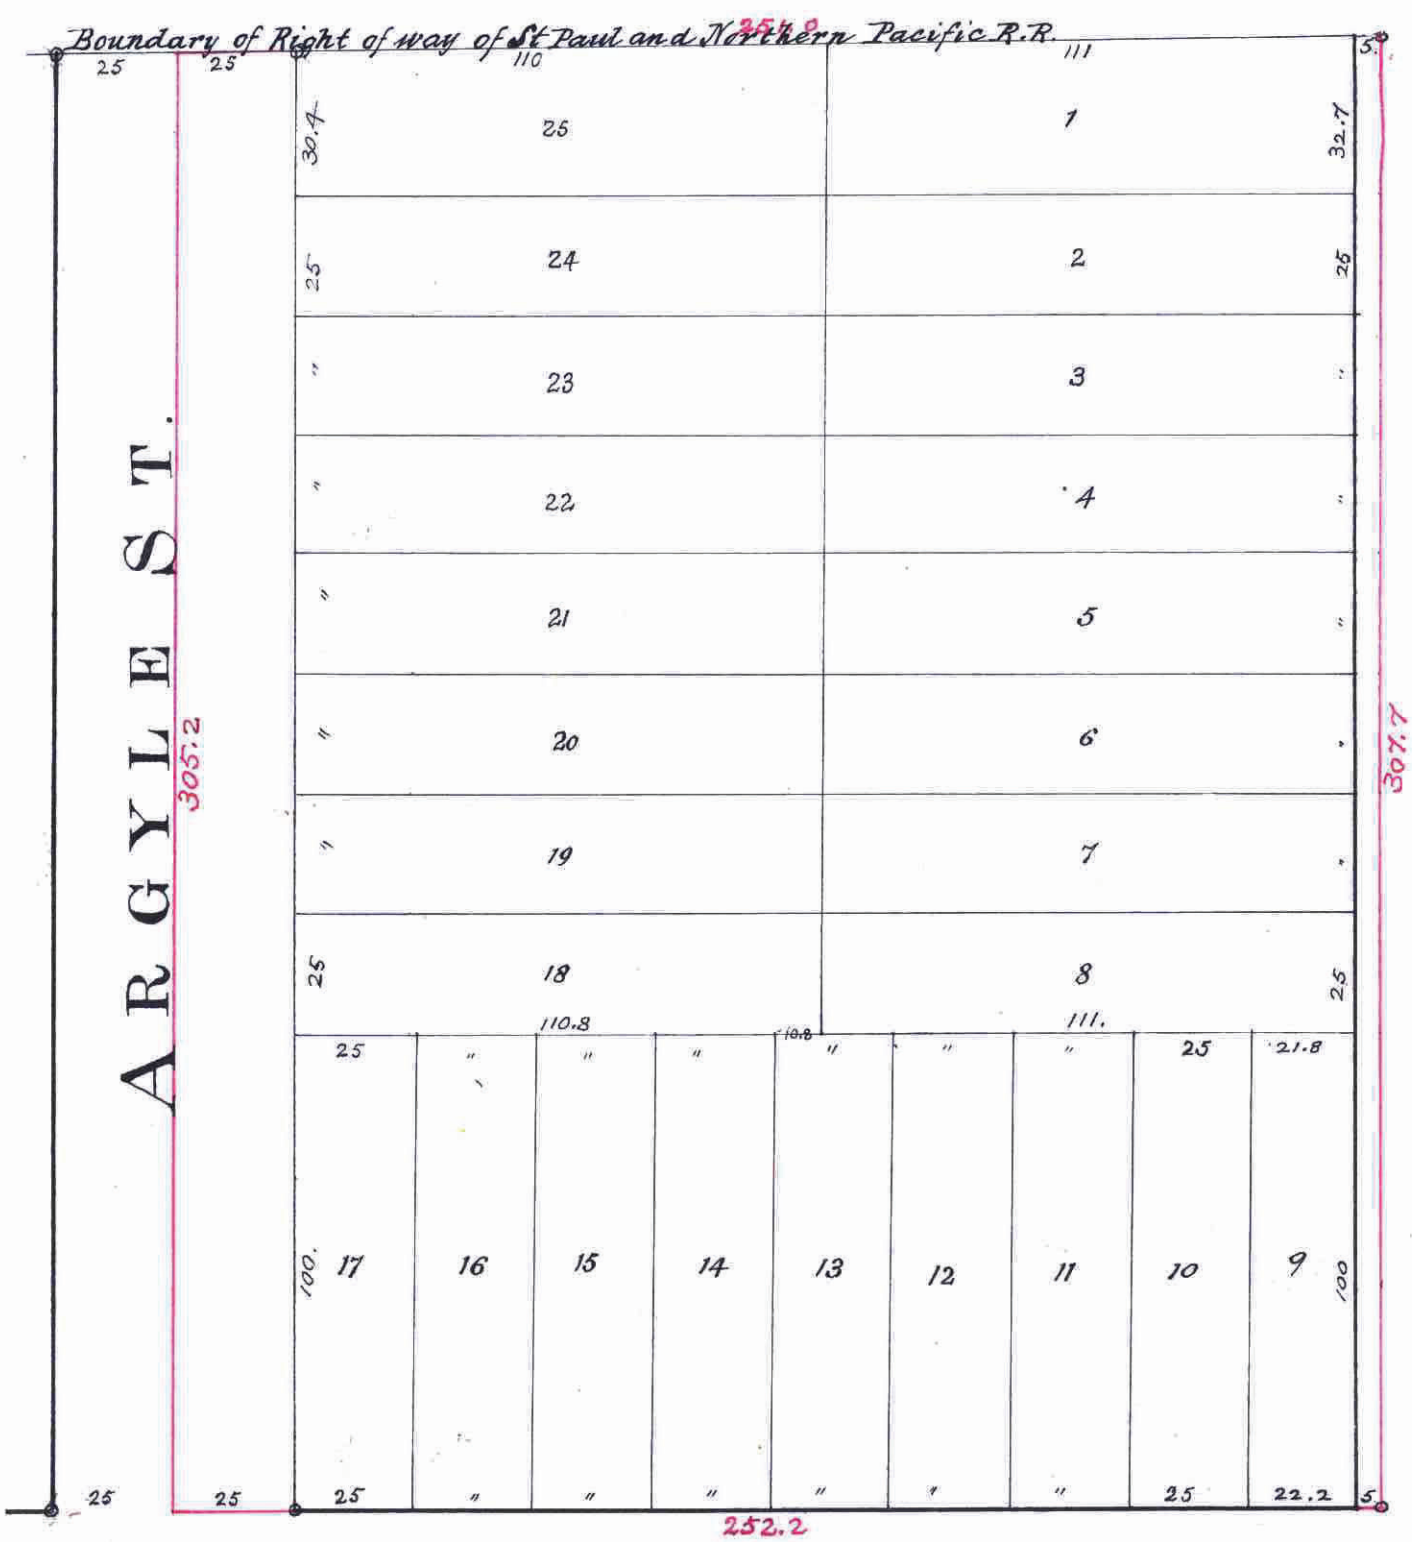

O R C H A R D S T.

C H A T S W O R T H S T.

I certify that I surveyed and platted the property described on this map, and placed iron monuments as shown on this map, and that the same is correct.

*J. S. Sewall* Surveyor.

State of Minnesota,  
County of Ramsey. } On this tenth day of March 1887, personally appeared before me - J. S. Sewall, to me well known, and acknowledged that he executed the foregoing certificate as his own free act and deed.

*La Fayette Shaw*  
Notary Public,  
Ramsey Co., Minn.

This is to certify that we, Lyman D. Hodge, and Mary G. Hodge, proprietors of Lot 36 of Como Villas, have caused the same to be surveyed and platted, to be hereafter known as Subdivision of Lot 36 of Como Villas, as shown by this plat, and hereby dedicate to the public for public use forever, all the streets herein indicated.

Witness our hands and seals, this twenty fifth day of March 1887.

In presence of  
*La Fayette Shaw*  
*Edward W. Cummings*

*Lyman D. Hodge* Seal  
*Mary G. Hodge* Seal

State of Minnesota,  
County of Ramsey. } On this twenty fifth day of March, 1887, personally came before me - Lyman D. Hodge and Mary G. Hodge, his wife, to me well known, and acknowledged that they executed the foregoing certificate for the uses and purposes therein expressed.

*La Fayette Shaw*  
Notary Public,  
Ramsey County, Minn.

I hereby recommend the acceptance of the within plat by the common council.

*City Engineer.*

Accepted and approved this 29<sup>th</sup> day of March 1887.

*L. P. Bloom*  
*W. Starkey*  
*Wm. R. ...* } Plat Commissioners.

CITY TREASURER'S OFFICE  
ST. PAUL, MINN.  
MAR 28 1887  
ASSESSMENTS PAID  
*George Res*  
CITY TREAS.

CITY OF ST. PAUL  
COUNTY TREASURER  
MAR 28 1887  
1887 TAX PAID  
P. A. ...

Accepted by the common council of the city of St. Paul, the 27th day of April 1887.

*Moral ...*  
City Clerk.

Taxes paid this 12<sup>th</sup> day of April, A. D. 1887.

*M. F. Kain*  
Auditor  
*A. Harroun*