


# DAVERN'S REARRANGEMENT OF BLOCKS 4.5 & 6. OF LEXINGTON PARK PLAT 10.

164119  
STATE OF MINNESOTA, ss.  
County of Ramsey,  
Office of the Register of Deeds.  
This is to certify that the within instrument  
was filed for record in this office at St. Paul,  
on the 30 day of September  
A. D. 1892 at 10 o'clock A. M., and that the  
same was duly recorded in Book...  
of... Pages...  
By...  
Deputy.

This plat document  
is an UNOFFICIAL  
copy of a  
Subdivision Plat or  
Registered Land Survey  
and is made available for  
information purposes only.  
To obtain an official copy  
please contact the Ramsey  
County Recorder's Office.



SCALE 100 FT.,  
SAULEZ & SAULEZ  
SURVEYORS  
PLAT 7.

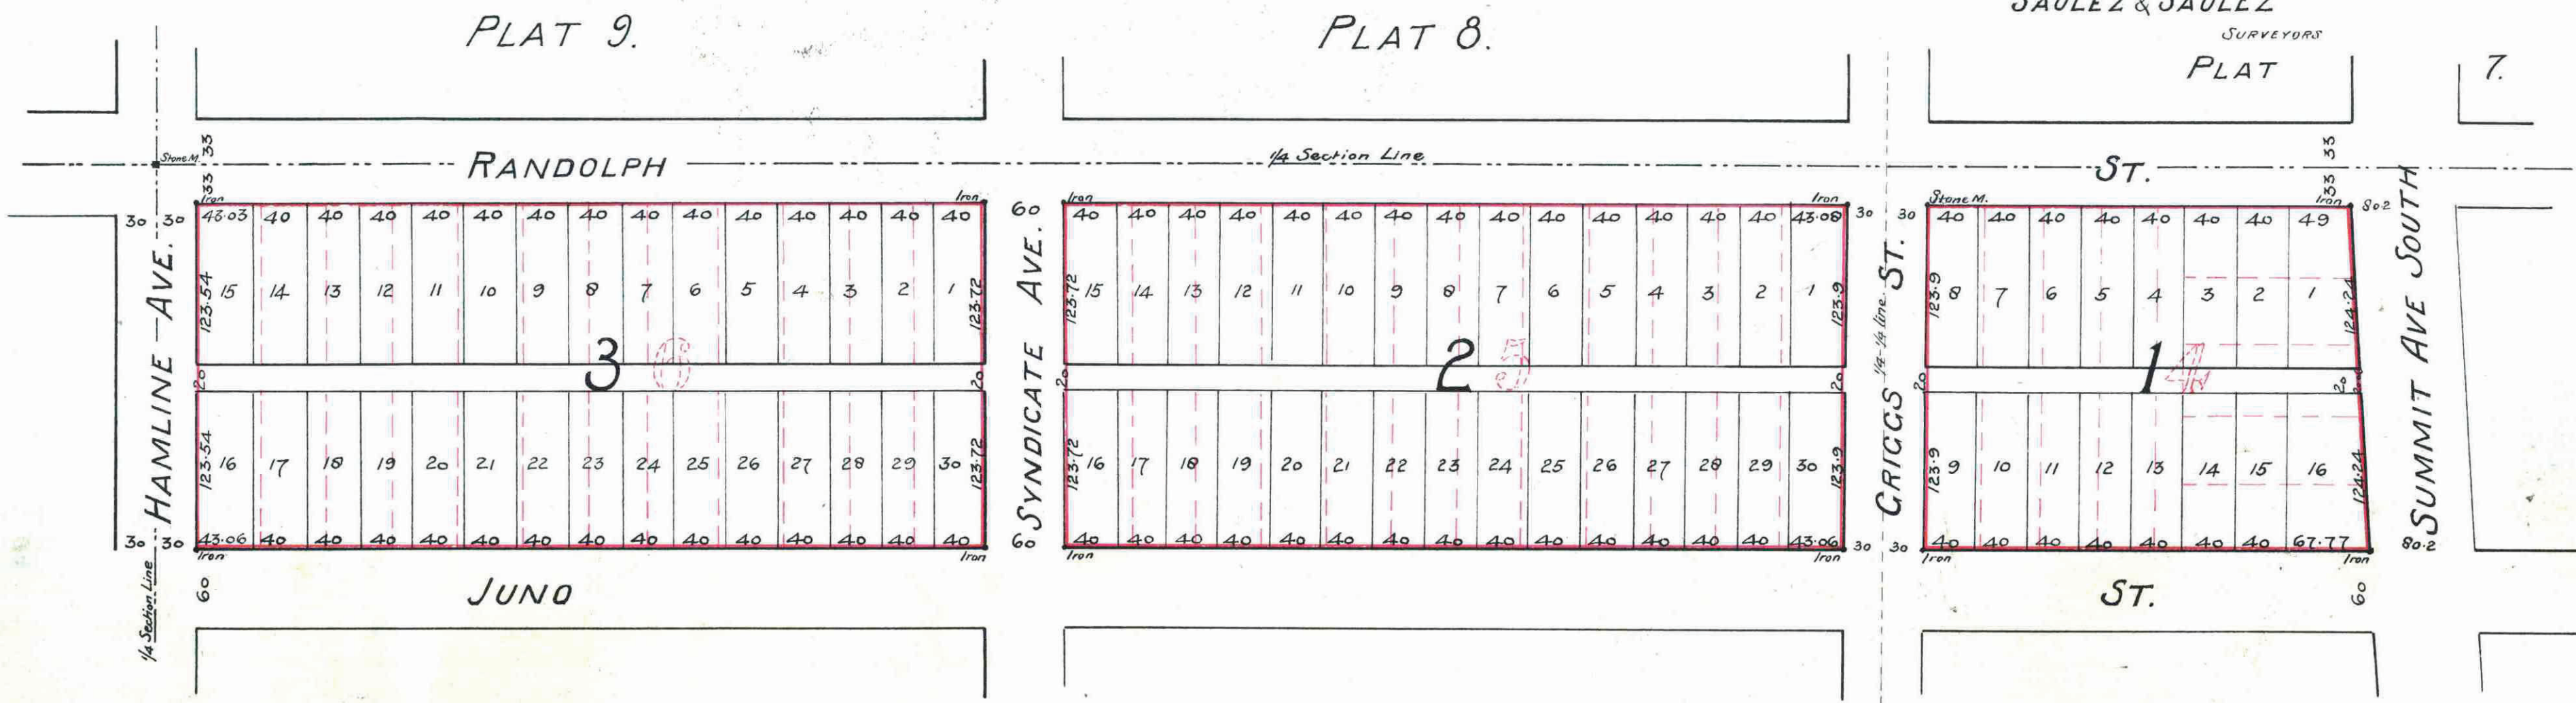

This is to certify that William B. Geery (bachelor)..... proprietor of Blocks 4, 5 & 6 of Lexing-  
ton Park Plat 10 Ramsey Co Minn has caused the same to be surveyed and platted, and hereafter  
known as "Davern's Rearrangement of Blocks 4, 5 & 6 of Lexington Park Plat 10" as shown by this plat,  
and hereby dedicate to the public, and for the public use forever, the streets avenues and alleys as  
herein indicated

Witness my hand and seal this 1<sup>st</sup> day of September A.D. 1892  
In presence of  
Mr. E. Hall  
H. L. Saulez }  
William B. Geery (Seal)

State of Minnesota } ss. On this 1<sup>st</sup> day of September, A.D. 1892, personally came before me  
County of Ramsey } the undersigned William B. Geery (bachelor)..... to me well known and he acknowledged that  
he executed the foregoing certificate for the uses and purposes therein expressed as his own free act  
and deed

Mr. E. Hall  
Notary Public  
Ramsey Co. Minn.

We hereby certify to having surveyed and platted the property as described on this plat or map  
as "Davern's Rearrangement of Blocks 4, 5 & 6 of Lexington Park Plat 10" and have placed iron  
monuments at the corners of each and every Block as shown on this map, and the same is correct

Saulez Saulez  
Surveyors

State of Minnesota } ss. On this 23<sup>rd</sup> day of August A.D. 1892 before me personally appeared  
County of Ramsey } Harry L. Saulez to me known to be a member of the firm of 'Saulez & Saulez' and the person who exe-  
cuted the foregoing certificate in behalf of 'Saulez & Saulez' and he acknowledged that he executed  
the same as the free act and deed of said 'Saulez & Saulez'



Mr. E. Hall  
Notary Public  
Ramsey Co. Minn.

Accepted by the Common Council of the City of St Paul on the 22 day of Sept - A.D. 1892.

Just City Clerk.

Accepted and approved this 30<sup>th</sup> day of September, A.D. 1892.

W. J. ... } Plat Commissioners  
City Engineer

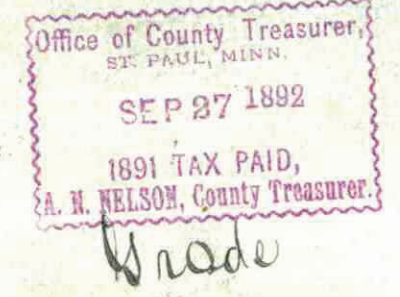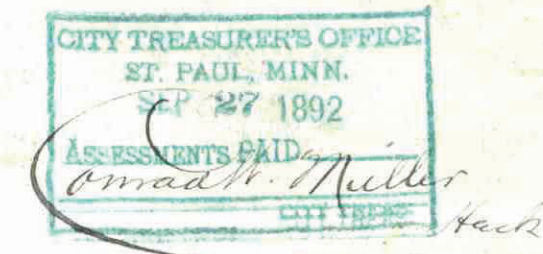

Taxes Paid and Transfer Entered,  
SEP 29 1892  
M. E. ... County Auditor.