

Taxes Paid and Transfer Entered
MAR 12 1888
M. F. EADY, Notary Public
Per

WASHBURN'S Re-arrangement of Block 18 2ND ADDITION MERRIAM PARK

City of St. Paul
Minn.


Taxes Paid and Transfer Entered
MAR 12 1888
M. F. EADY, Notary Public
Per *M. F. Eady*

Scale 1 INCH = 60 FEET

I hereby certify to having surveyed and platted the property as described on this map as WASHBURN'S RE-ARRANGEMENT OF BLOCK 18, 2ND ADDITION MERRIAM PARK, ST. PAUL, and have placed iron monuments at the corners of each and every block as shown on this map, and the same is correct.
Charles A. Forbes
Surveyor.

Accepted and approved this third day of March A. D. 1888
J. P. Fallon
Ed. Spratley
R. W. Rundlett
Plat Commissioners.

Accepted in the Common Council of the City of St. Paul, on the 6th day of March 1888.
W. A. Sundquist
City Clerk.

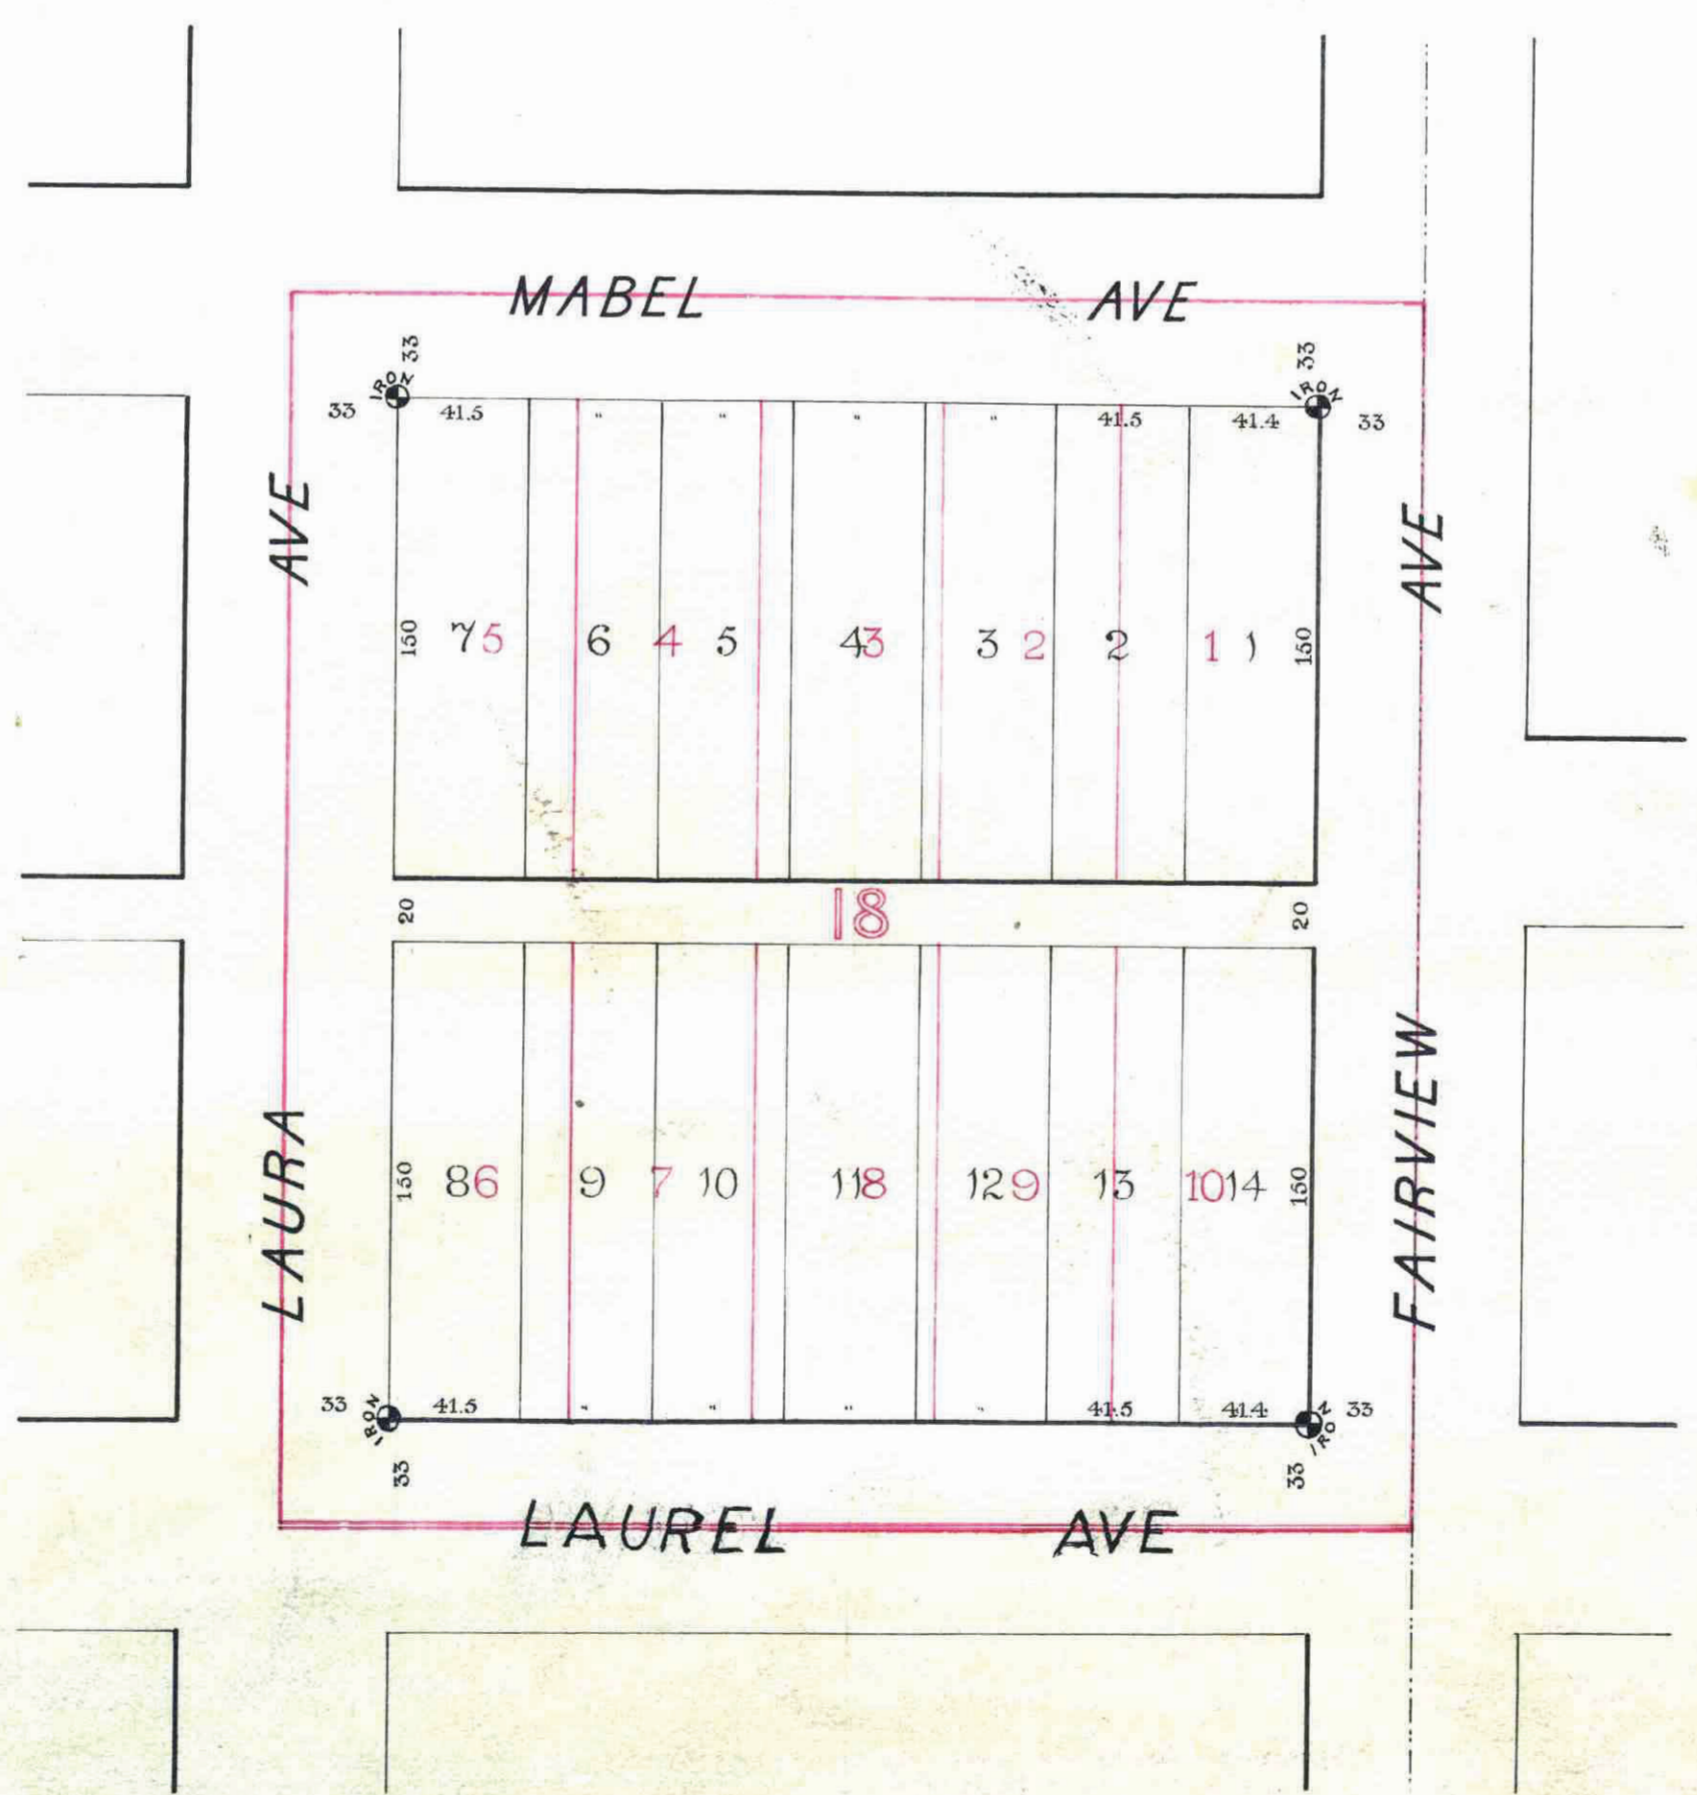

STATE OF MINNESOTA, } ss.
County of Ramsey, }
On this 27th day of February A. D. 1888, personally appeared before the undersigned, CHARLES A. FORBES, to me well known, and acknowledged that he executed the foregoing Certificate as his own free act and deed.
Edmond J. Good
Notary Public, Ramsey Co., Minn.

This is to certify that J. L. Washburn & Alma Patten Washburn his wife, proprietors of WASHBURN'S RE-ARRANGEMENT OF BLOCK 18, 2ND ADDITION MERRIAM PARK, CITY OF ST. PAUL, MINN., have caused the same to be surveyed and platted, and hereafter known as Washburn's Re-arrangement of Block 18, 2nd Addition Merriam Park City of St. Paul as shown by this plat, and hereby dedicate to the public, and for the public use forever, all the Streets, Avenues, Alleys, Parks and Boulevards, as herein indicated.
Witness our hands and seals, this Twenty ninth day of February 1888.
In presence of
Chas. J. Shoemaker
Lorin Leray
J. L. Washburn
Alma Patten Washburn

State of Minnesota }
County of Blue Earth }
On this Twenty ninth day of February A. D. 1888, personally came before me, the undersigned, J. L. Washburn and Alma Patten Washburn his wife, to me well known, and they acknowledged that they executed the foregoing Certificate for the uses and purposes therein expressed.
Lorin Leray
Notary Public,
Blue Earth County, Minn.

STATE OF MINNESOTA, } ss.
County of Ramsey, }
Office of the Register of Deeds.
This is to certify that the within instrument was filed for Record in this Office, at St. Paul, on the 13th day of March A. D. 1888, at 11:40 o'clock, and that the same is recorded in Book 11 of Deeds, at page 22.
W. J. [Signature]
Register of Deeds.

This plat document is an UNOFFICIAL copy of a Subdivision Plat or Registered Land Survey and is made available for information purposes only.
To obtain an official copy please contact the Ramsey County Recorder's Office.

CITY TREASURER'S OFFICE
ST. PAUL, MINN.
MAR 5 1888
ASSESSMENTS PAID
[Signature]
CITY TREAS.