


CARPENTER'S REARRANGEMENT OF PART OF RIDGEWOOD PARK RAMSEY CO. MINN.

Scale 200 ft - 1 in
- Iron Monuments.

Elmer & Morrison
Surveyors

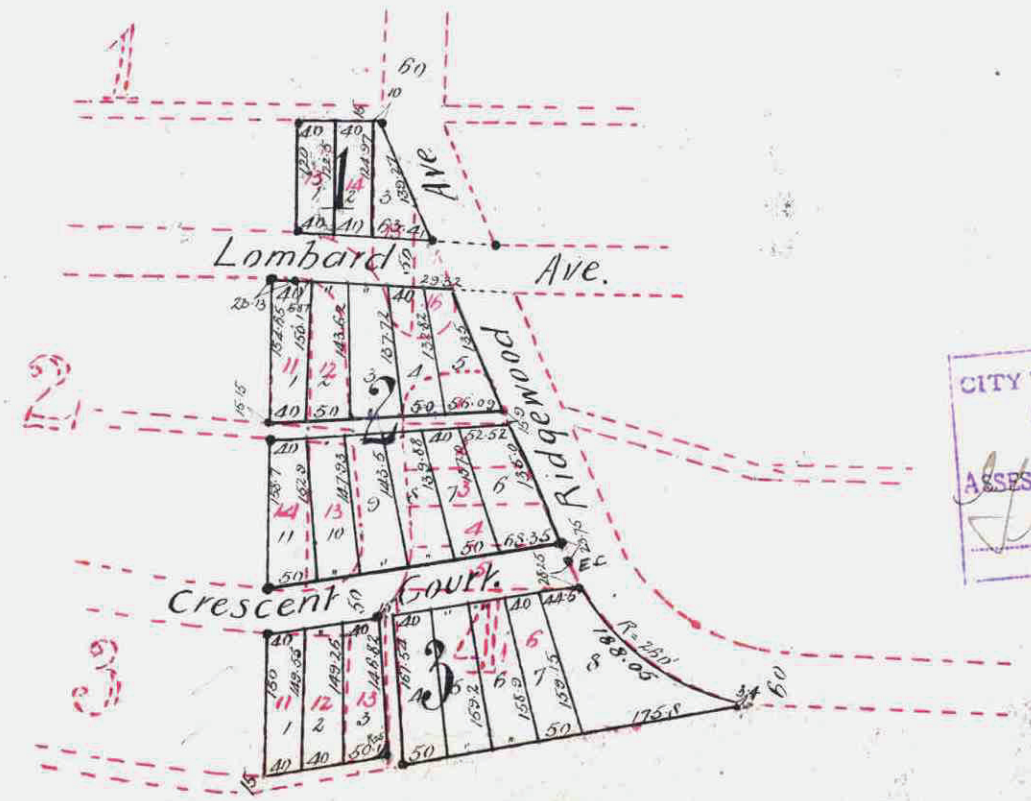

CITY TREASURER'S OFFICE
ST. PAUL, MINN.
DEC 22 1888
ASSESSMENTS PAID
Hebert
CITY TREAS.

CITY TREASURER'S OFFICE
ST. PAUL, MINN.
SEP 15 1888
ASSESSMENTS PAID
Wm. Field
CITY TREAS.

STATE OF MINNESOTA,)
County of Ramsey)
Office of the Register of Deeds.
This is to certify that the within
instrument was filed for Record
in this Office, at St. Paul, on the
12th day of September, A. D.
1888, at 10 o'clock A. M. and
that the same was duly recorded in
Book 2, at 2 o'clock P. M.
Page 116.

This plat document
is an UNOFFICIAL
copy of a
Subdivision Plat or
Registered Land Survey
and is made available for
information purposes only.
To obtain an official copy
please contact the Ramsey
County Recorder's Office.

This is to certify that Warren Carpenter, (Bachelor) proprietor of lots 12, 14, 15 & 16 Block 1; lots 11, 12, 13 & 14 Block 2, lots 11, 12 & 13 Block 3, & all of Block 4, Ridgewood Park Addition to the City of St. Paul Ramsey Co. Minn., has caused the same to be rearranged & platted, & the same known as "Carpenter's Rearrangement of part of Ridgewood Park Ramsey Co. Minn." as shown by this plat, & hereby dedicate to the public, and for the public use forever the avenues and alleys as herein indicated
Witness my hand and seal this 12th day of September 1888
Warren Carpenter (Seal)

In presence of
Geo. B. Evans
H. L. Taylor
State of Minnesota
County of Ramsey }

On this 12th day of September A.D. 1888, personally came before me the undersigned George B. Evans, to me well known and he acknowledged that he executed the foregoing Certificate for the uses and purposes therein expressed as his own free act & deed.

George B. Evans Notary Public
Ramsey Co. Minn.
Accepted by the Common Council of the City of St. Paul on the 18th day of Dec 1888
Thos. A. Reuder act
Clerk
Re. J. H. Hillman
Deputy

We hereby certify to having surveyed and platted the property as described on this map as "Carpenter's Rearrangement of part of Ridgewood Park Ramsey Co. Minn." and have placed iron monuments at the block corners as shown on this map and the same is correct.

Elmer & Morrison
Surveyors

State of Minnesota
Ramsey County }
On this 4th day of September, A.D. 1888 before me personally appeared Howard W. Elmer to me known to be a member of the firm of Elmer & Morrison, and the person who executed the foregoing Certificate in behalf of Elmer & Morrison and he acknowledged that he executed the same as the free act and deed of said Elmer & Morrison.

Charles H. Taylor
Notary Public
Ramsey Co. Minn.

Accepted and approved this 12th day of September A.D. 1888
L. P. Folsom
Wm. A. Farkey
Wm. A. Fauschke
L. W. Hummel } Plat Commissioners

OFFICE OF
COUNTY TREASURER
ST. PAUL, MINN.
SEP 12 1888
TAX PAID
A. W. H. Treas.

Taxes Paid and Transfer Entered
DEC 22 1888
M. F. KAIN, County Auditor.
Per *M. F. Kain*