


— REARRANGEMENT —
— OF —
LOTS 33 & 34.
MANITOU ISLAND.
— MINNESOTA —
Scale 50 ft. = 1 in. *Saulze & Saulze*
Surveyors.

144923
STATE OF MINNESOTA, ss.
County of Ramsey,
Office of the Register of Deeds.
This is to certify that the within instrument was filed for record in this office at St. Paul, on the 21st day of *July*, A. D. 1891, at 10 o'clock P. M., and that the same was duly recorded in Book *16* of *100* Pages.
Wm. H. Reed
Register of Deeds.
By *Wm. H. Reed* Deputy.

This plat document is an UNOFFICIAL copy of a Subdivision Plat or Registered Land Survey and is made available for information purposes only.
To obtain an official copy please contact the Ramsey County Recorder's Office.

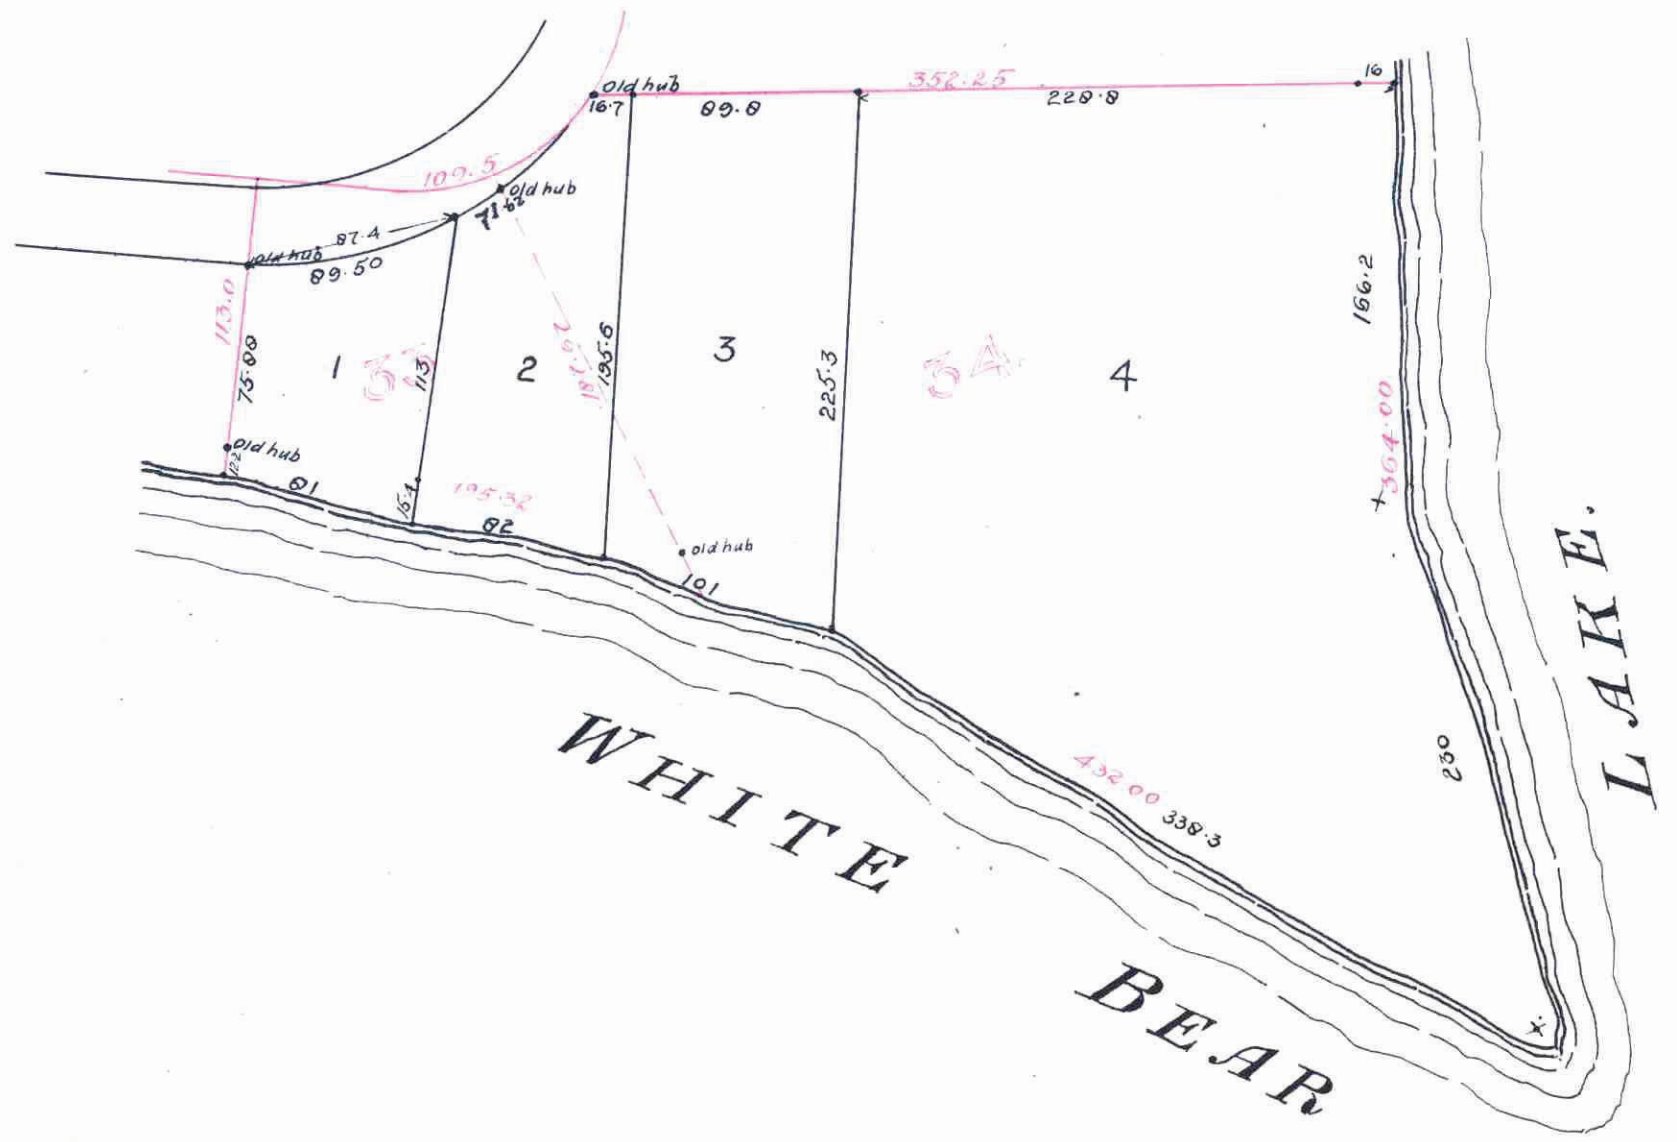

St Paul Minn Aug 29th 1891.
I hereby certify that I have made the necessary surveys to determine the accuracy of the annexed plat and find that the monuments for the guidance of future surveys as shown on this plat have been correctly placed; that the boundary lines of the land platted are correctly shown on said plat, and that the sizes of all fractions of lots are as given on said plat.
David S. Justice
County Surveyor
Ramsey County,
Minn.

This is to certify that Lena B. Clarke & Francis B. Clarke her husband, and Susie L. Morton & Walter S. Morton her husband, proprietors of lots Thirty Three (33) and Thirty Four (34) Manitou Island White Bear Lake Minnesota, have caused the same to be rearranged and platted, and hereafter known as "Rearrangement of Lots 33 & 34 Manitou Island White Bear Lake Minnesota." as shown by this plat.

Witness our hands and seals this 11th day of July A.D. 1891

In presence of
Philip H. Chagnier
Charles J. Brown

Lena B. Clarke (Seal)
Francis B. Clarke (Seal)
Susie L. Morton (Seal)
Walter S. Morton (Seal)

State of Minnesota } s.s. On this 11th day of July A.D. 1891 personally came before me the undersigned *Charles J. Brown*, Notary Public, County of Ramsey, Minnesota, to me well known, and they acknowledged that they executed the foregoing certificate as their own free act and deed.

We hereby certify to having surveyed and platted the property as described on this map as rearrangement of Lots 33 & 34 Manitou Island White Bear Lake, Minnesota, and have placed hubs at the corners of each and every lot as shown on this map, and the same is correct

Saulze & Saulze
Surveyors.

State of Minnesota } s.s. On this 24th day of August A.D. 1891 before me personally appeared George C. Saulze, to me known to be a member of the firm of 'Saulze & Saulze', and the person who executed the foregoing certificate in behalf of 'Saulze & Saulze', and he acknowledged that he executed the same as the free act and deed of said 'Saulze & Saulze'

Frederick G. Ingerson
Notary Public
Ramsey Co., Minn.

Accepted and approved this 14 day of September A.D. 1891

W. A. Brown
William C. Benton } Plat Commissioners
City Engineer

Accepted by the Common Council of the City of St. Paul on the 14 day of September A.D. 1891
City Clerk

Office of County Treasurer,
St. Paul, Minn.
SEP 13 1891
1890 TAX PAID.
A. B. H. H. H., County Treasurer.
Grude

Taxes Paid and Transfer Entered,
SEP 19 1891
M. F. KAIN, County Auditor,
Per *Grude*