


# IRVINE PLACE RE-ARRANGEMENT.

JOHN B. IRVINE, SURVEYOR,

DECEMBER, 1918

Scale 10ft. per inch.

AUDITORS SUBDIVISION NO 31.

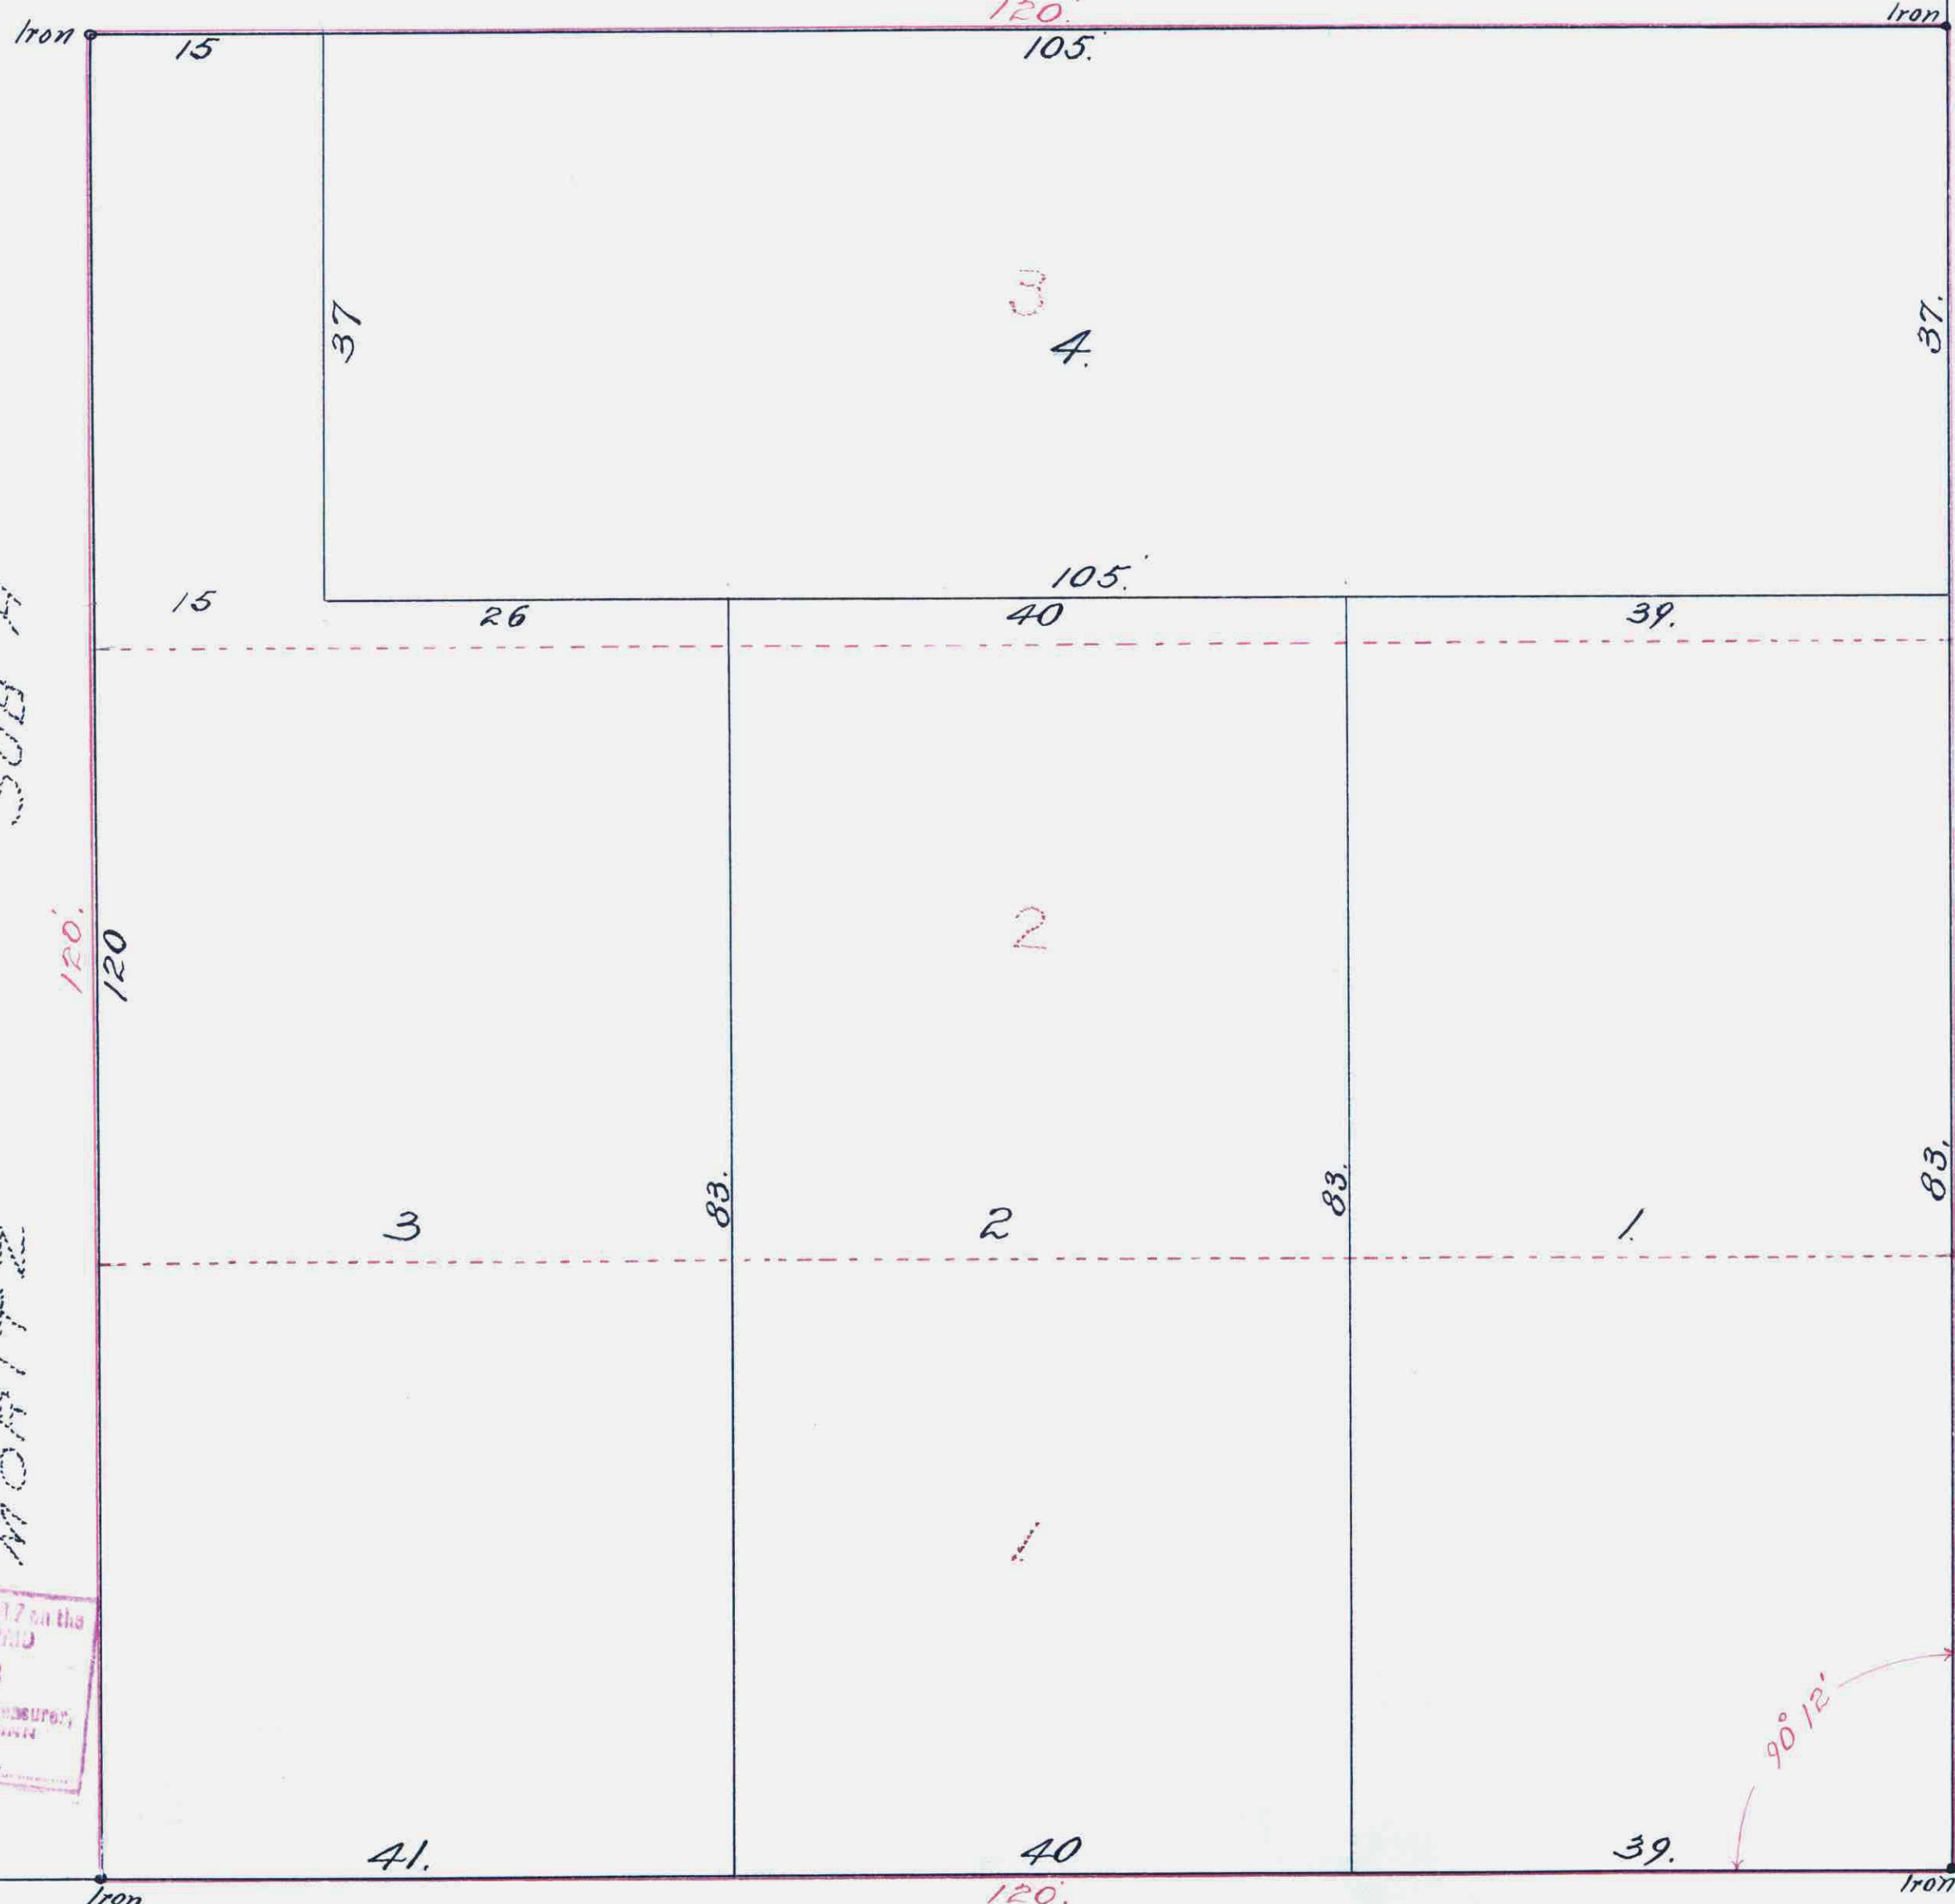

STATE OF MINNESOTA,  
County of Ramsey,  
Office of the Register of Deeds  
This is to certify that the within instrument  
was filed for record to the office of St. Paul,  
on the 21<sup>st</sup> day of December  
A. D. 1918, at 10 o'clock A. M. and that the  
same was duly recorded in the  
of Survey Plat Free  
7  
Register of Deeds.  
Deputy.

This plat document is an UNOFFICIAL copy of a Subdivision Plat or Registered Land Survey and is made available for information purposes only.

To obtain an official copy please contact the Ramsey County Recorder's Office.

I hereby certify to having surveyed and platted the property as described on this map as Irvine Place Re-arrangement and have placed iron monuments at the corners thereof as shown on this map and the same is correct.

John B. Irvine, Surveyor.

State of Minnesota } On this 14<sup>th</sup> day of December, A.D. 1918,  
County of Ramsey } personally appeared before me the undersigned  
John B. Irvine, to me well known and acknowledged  
that he executed the foregoing certificate as his own free act and deed.

F. L. Brown

Notary Public  
My Commission Expires 7/1/1923 Ramsey County, Minnesota.

TAXES PAID  
AND TRANSFER ENTERED  
DEC 27 1918  
GEO. L. HES, COUNTY AUDITOR  
Rugstad

This is to certify that Sarah M. Irvine and John B. Irvine her husband owners of lots one, two and three Irvine Place, have caused the same to be surveyed and re-arranged and hereafter known as Irvine Place, Re-arrangement as shown by this plat and hereby dedicate to the public and for public use forever all the streets, avenues or alleys as herem indicated. Witness our hands and seals this 14<sup>th</sup> day of December A. D. 1918.

In presence of  
F. L. Brown } Sarah M. Irvine  
A. J. Hodgins } John B. Irvine

State of Minnesota } On this 14<sup>th</sup> day of December A.D. 1918 personally  
County of Ramsey } came before me the undersigned Sarah M. Irvine  
and John B. Irvine, her husband to me well known and they acknowledged  
that they executed the foregoing certificate as their own free act and deed.

F. L. Brown

Notary Public.  
My Commission Expires 7/1/1923 Ramsey County, Minnesota.

Accepted and Approved this 16<sup>th</sup> day of December A.D. 1918.

George W. Leuce }  
Charles H. Morrison } Plat Commissioners  
Jas. W. Jordan }  
M. J. Cross } Commissioners of Public Works

Accepted by the Council this 18<sup>th</sup> day of December A.D. 1918.

Approved December 18<sup>th</sup> /1918  
John J. Farney City Clerk.

541609

Taxes for the year of 1917 on the lands described within this  
DEC 27 1918  
C. C. Conner

IGLEHART

Ave. 66

P. F. - 23732

Schneider

57.  
66