

AUDITOR'S SUBDIVISION

200525 88

NO. 21

St. Paul Minn.

SCALE 40 FEET PER INCH.

Surveyed by Gates A. Johnson Jr.
December 1900.

I hereby certify to having surveyed and platted the property as described on this map as AUDITOR'S SUBDIVISION No. 21 ST. PAUL MINN. and have placed monuments at the corners as hereon indicated and the same as correct.
Gates A. Johnson Jr.
County Surveyor
Ramsey Co. Minn.

State of Minnesota } ss
County of Ramsey } On this 8 day of December A.D. 1900 before me the undersigned personally appeared GATES A. JOHNSON JR. to me well known and acknowledged that he executed the foregoing certificate as his own free act and deed.

J. H. Bauger
Notary Public
Ramsey Co. Minn.

State of Minnesota } ss
County of Ramsey } I, W. R. JOHNSON County Auditor of the County of Ramsey State aforesaid do hereby certify that in compliance with and according to the provisions of Section 1626, General Statutes of 1894, I have caused all that part of the S 1/2 of Lot 9 Bedwell's Add. to West St. Paul lying East of Gorman Ave. to be surveyed and platted and hereafter known as Auditor's Subdivision No. 21 ST. PAUL MINN. as shown on this plat.

Witness my hand and seal this 27 day of Dec. A.D. 1900.

In presence of
J. H. Bauger }
County Auditor.


State of Minnesota } ss
County of Ramsey } On this 27 day of Dec. A.D. 1900 before me the undersigned personally appeared W. R. JOHNSON to me well known and acknowledged that he executed the foregoing certificate as his own free act and deed.

J. H. Bauger
Notary Public
Ramsey Co. Minn.

Accepted and approved this 5th day of June A.D. 1901

W. A. Jones }
J. H. Hoffman } Plat
O. Clauson } Commissioners
City Engineer.

Accepted by the Common Council of the City of St. Paul on the 18 day of June A.D. 1901
City Clerk.

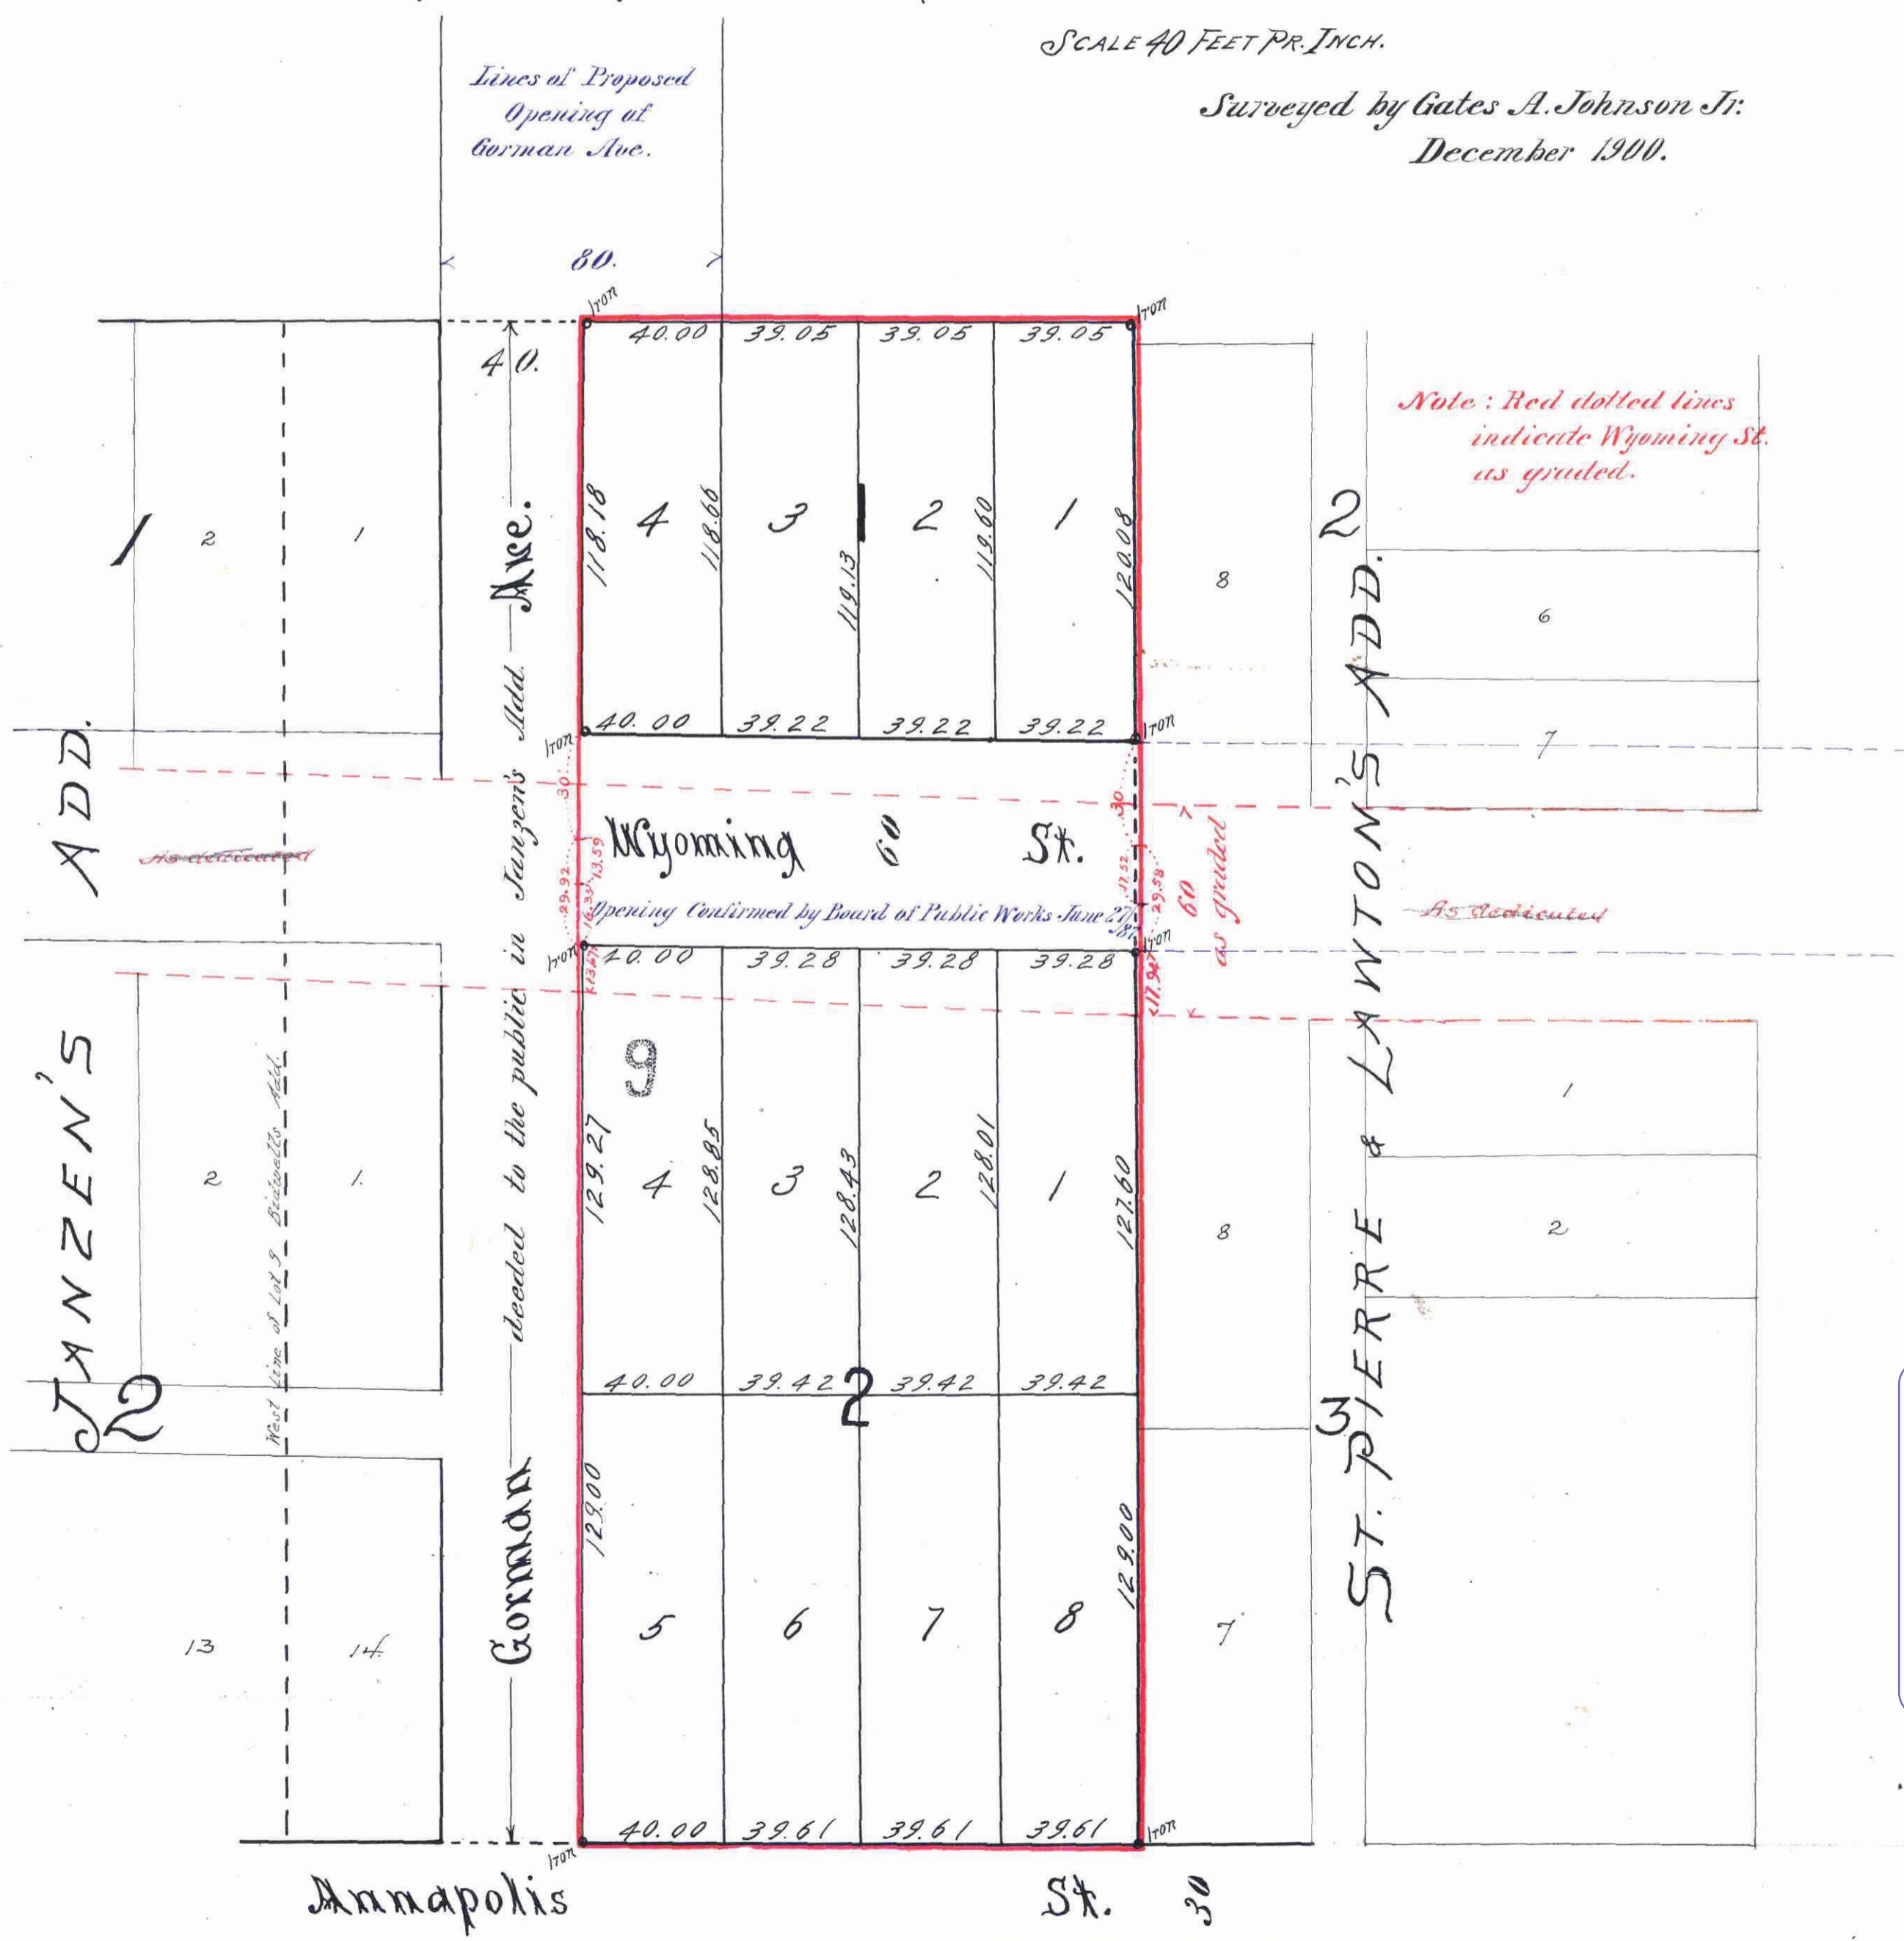


This plat document is an UNOFFICIAL copy of a Subdivision Plat or Registered Land Survey and is made available for information purposes only.
To obtain an official copy please contact the Ramsey County Recorder's Office.

STATE OF MINNESOTA } ss
County of Ramsey }
Office of the Register of Deeds
This is to certify that the within instrument was filed for record in this office at St. Paul, on the 2nd day of July A. D. 1901, at 3:20 o'clock P. M. and that the same was duly recorded in Book 18 of Town Plat Page 13
M. J. Fitzgerald
Register of Deeds.
By _____ Deputy.