LEMKE'S ADDITION

ST. PAUL, MINN.

Scale 1" to 60'

Jens Pedersen
Surveyor

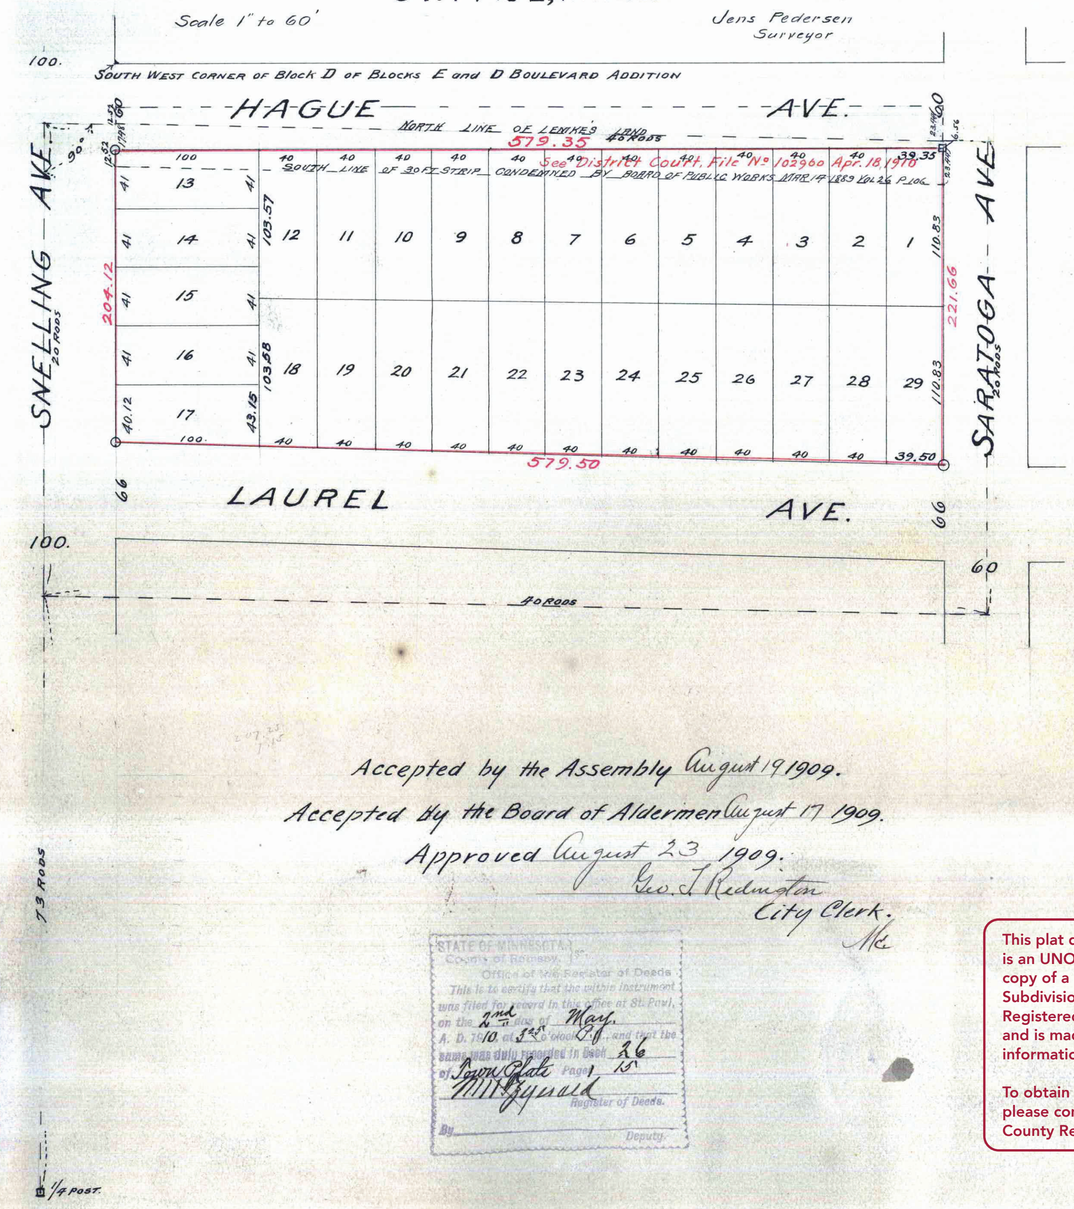

Accepted by the Assembly August 19 1909.

Accepted by the Board of Aldermen August 17 1909.

Approved August 23 1909.

Geo. T. Redington
City Clerk.

STATE OF MINNESOTA }ss
County of Ramsey }
Office of the Register of Deeds
This is to certify that the within instrument was filed for record in this office at St. Paul, on the 2nd day of May A. D. 1910 at 12 o'clock M., and that the same was duly recorded in Book 26 of Town Plats Page 15
Wm Eyvald
Register of Deeds.
By _____ Deputy.

Taxes for the year 1909 on the lands described within paid.
APR 27 1910
ST. PAUL, MINN.
JESSE FOX, County Treasurer.

This plat document is an UNOFFICIAL copy of a Subdivision Plat or Registered Land Survey and is made available for information purposes only.

To obtain an official copy please contact the Ramsey County Recorder's Office.

RAMSEY COUNTY

383211

I hereby certify to having surveyed and platted the property as described on this map as LEMKE'S ADDITION and have placed iron monuments at the corners of the block, as shown on this map and the same is correct.

Jens Pedersen
SURVEYOR.

STATE OF MINNESOTA }ss
COUNTY OF RAMSEY } On this 8th day of July A.D. 1909, personally came before me the undersigned JENS PEDERSEN, to me well known and acknowledged that he executed the foregoing Certificate as his own free act and deed.

D J Bronewold
Notary Public, Ramsey Co. Minn.
My Commission expires July 15-1909

This is to Certify that Ernst F. Lemke and Ulricke Lemke his wife, are the owners of all that part lying North of Laurel Ave of the following described Five Acre Tract; Commencing on the Center line of Snelling Ave. (73) Seventy three Rods North of the S.W. Corner of the N.W. quarter of Sec. 3, T. 28, R. 23; being the point of beginning; thence East Forty (40) Rods, thence North (20) Twenty Rods; thence West Forty (40) Rods, thence South Twenty (20) Rods to the place of beginning, except parts taken for streets, have caused the same to be surveyed and platted and hereafter known as LEMKE'S ADDITION, St. Paul, Minn. as shown on this map, and hereby dedicate to the public and for the public use forever, all the streets, avenues and alleys as herein indicated

Witness our hands and seals this 8th day of July A.D. 1909.

In Presence of
W M Chapin
D J Bronewold

Ernst F. Lemke
Ulrike Lemke

State of Minnesota. }
County of Ramsey. } ss. On this 8th day of July 1909, personally appeared before me the undersigned Ernst F. Lemke and Ulricke Lemke his wife, to me well known and acknowledged that they executed the foregoing certificate as their own free act and deed.

D J Bronewold
Notary Public, Ramsey Co. Minn.
My Commission expires July 15th 1909

Accepted and Approved this 13th day of August A.D. 1909.

C. Dittman
Jas. W. Jordan } Plat Commissioners.
L. W. Rundlett — City Engineer.

Taxes for the year 1909 on the lands described within paid.
APR 27 1910
ST. PAUL, MINN.
JESSE FOX, County Treasurer.

TAXES PAID
AND TRANSFER ENTERED
APR 28 1910
EDW. S. KRAMER, Co. Auditor,
By _____ Deputy.

CITY TREASURER'S OFFICE,
ST. PAUL, MINN.
MAY 2- 1910
Assessment of $1.75 Collected.
Per _____