


CARDOZO'S REARRANGEMENT

Scale 1" to 50'

ST. PAUL, MINN.

Jens Pederson
Surveyor

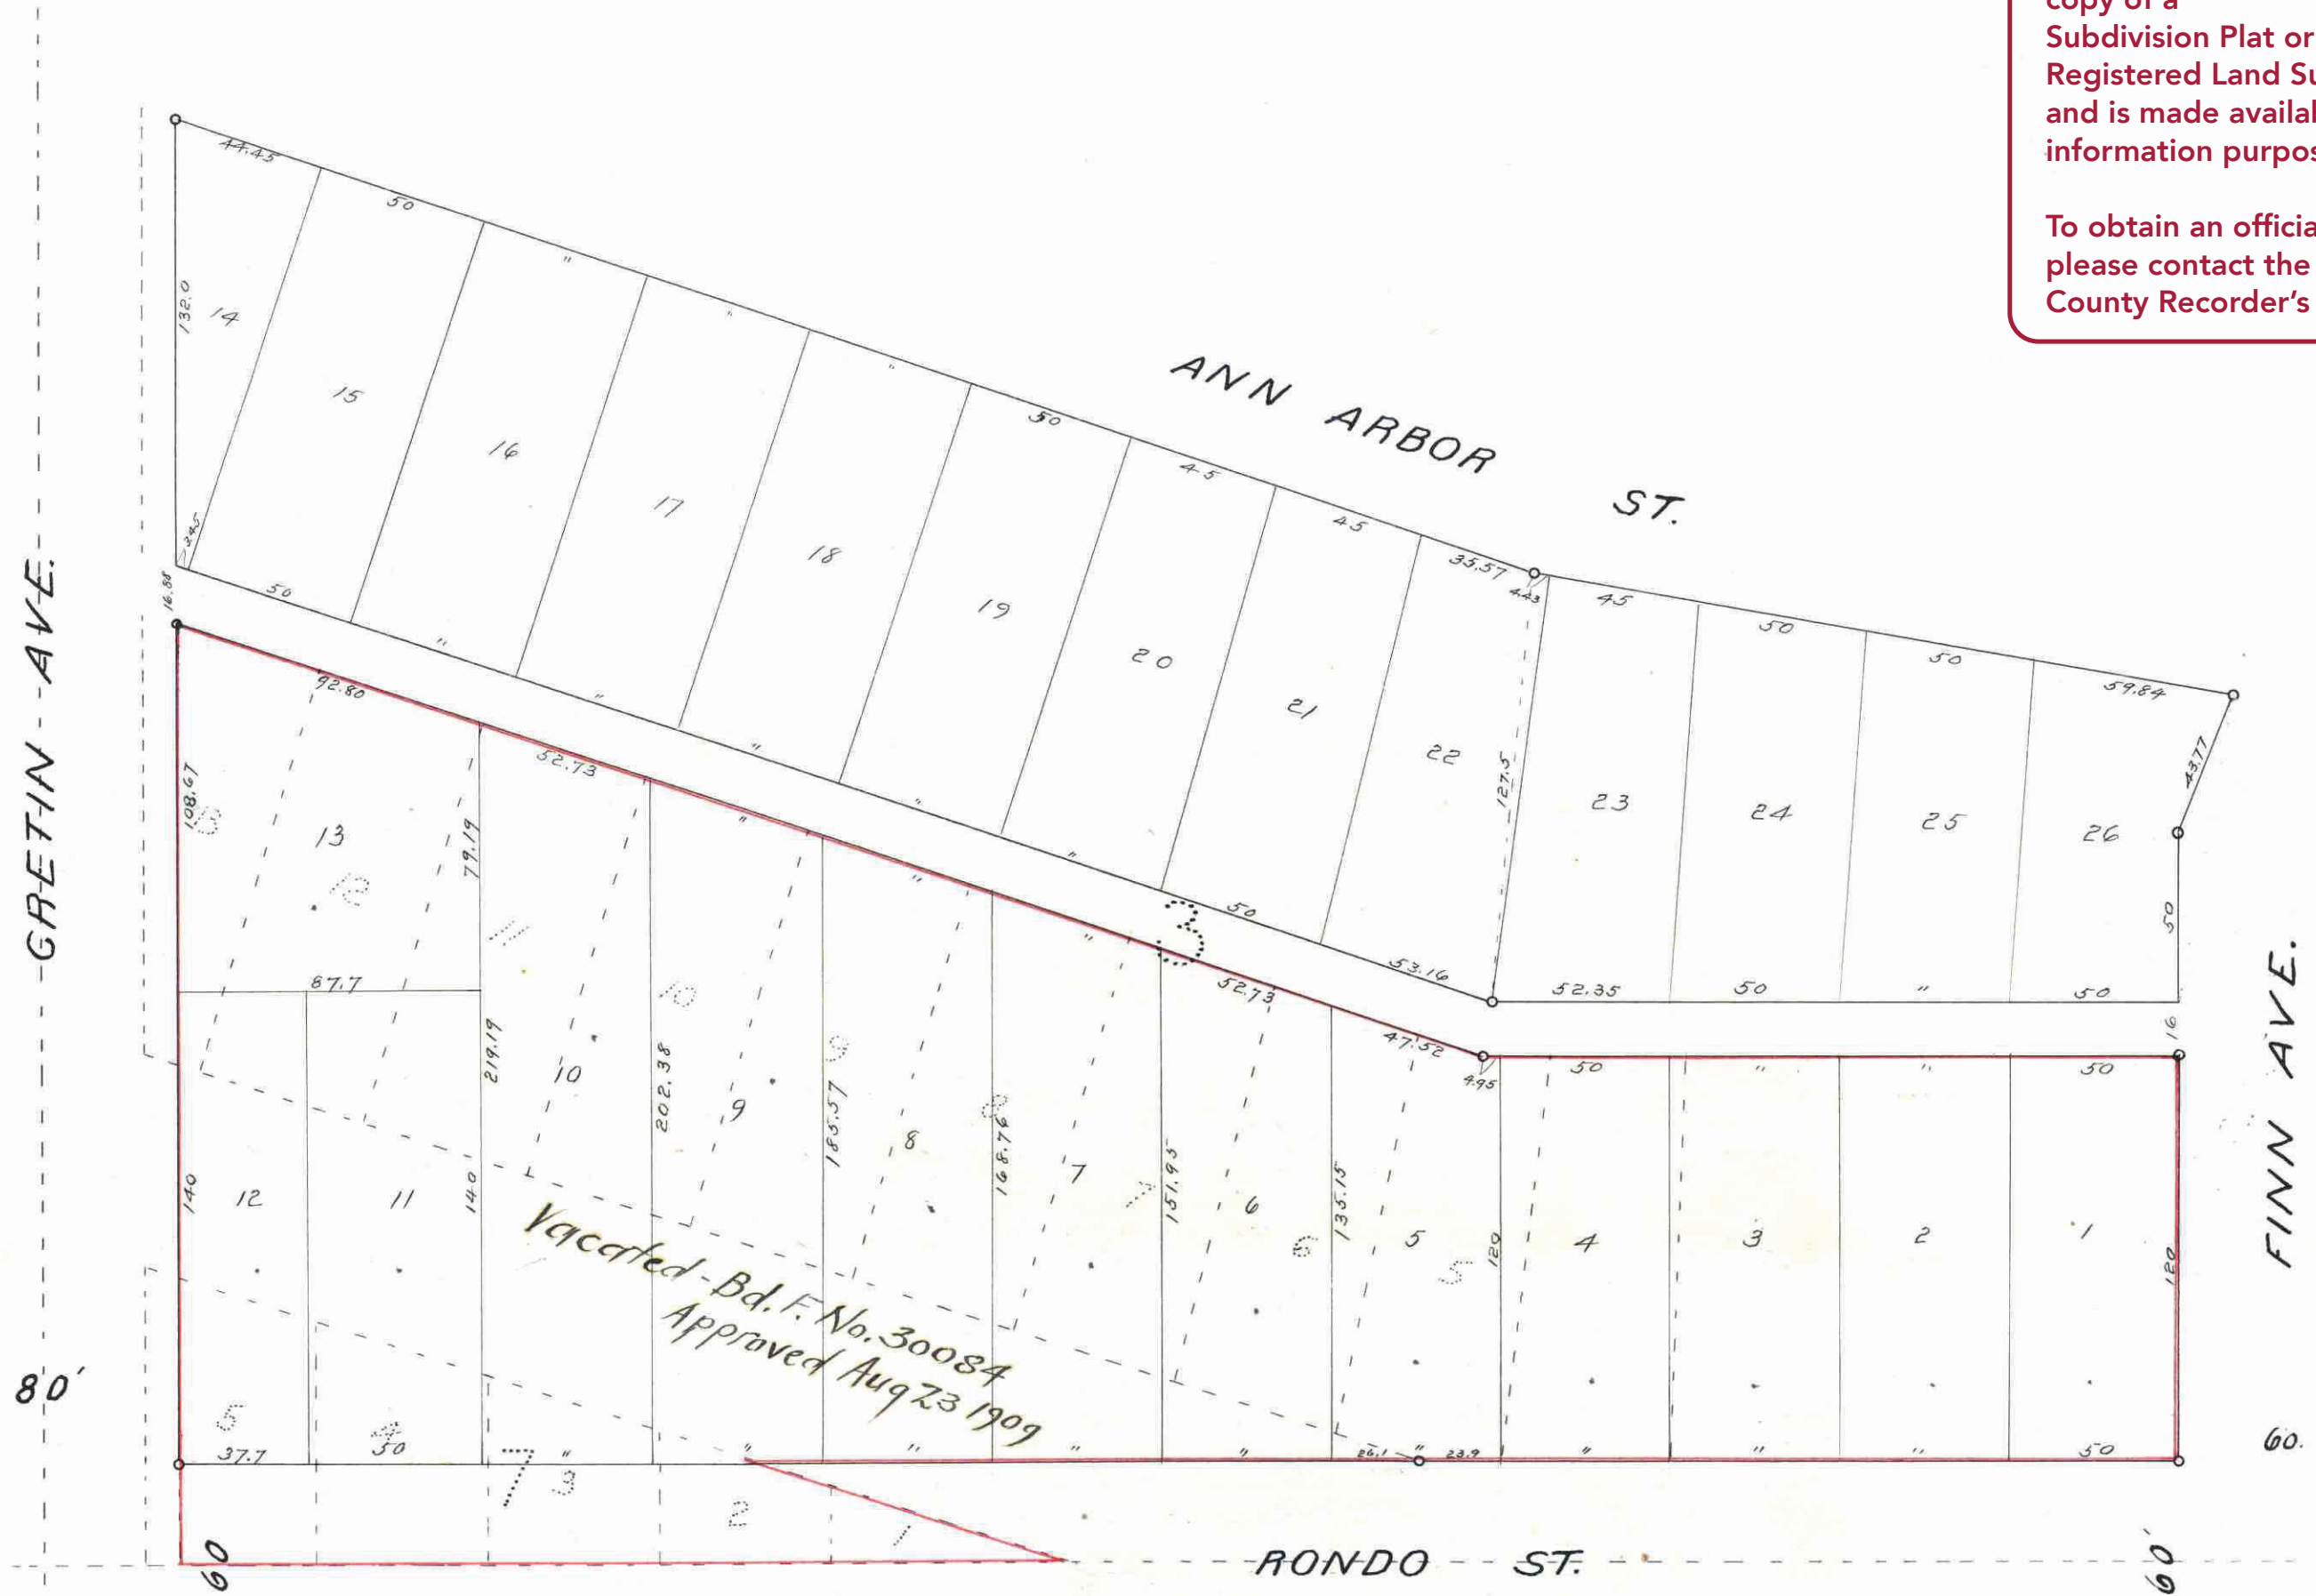

This plat document is an UNOFFICIAL copy of a Subdivision Plat or Registered Land Survey and is made available for information purposes only.

To obtain an official copy please contact the Ramsey County Recorder's Office.

I hereby certify to having surveyed and plotted the property as described on this map as "Cardozo's Re-arrangement" and have placed iron monuments at the corners of each and every block, as shown on this map, and the same is correct.

Jens Pederson
Surveyor.

State of Minnesota }
County of Ramsey } ss.
On this 17 day of Dec. 1908 personally appeared before me, the undersigned, Jens Pederson, to me well known, and acknowledged that he executed the foregoing certificate as his own free act and deed.

Notary Public, Ramsey County, Minn.
My commission expires Oct. 28 19

This is to certify that Jennie N. Cardozo and Phineas N. Cardozo, her husband, F. Dora Constantine and Trica Constantine, her husband, Louis Le Roy Constantine and Caddie L. Constantine, his wife, Helen R. Constantine, unmarried, and Theo. N. Espe, unmarried, proprietors of Block 7 and lots 1 to 13 inclusive of Block 3 of Capital Addition, have caused the same to be surveyed and plotted and hereafter known as "Cardozo's Re-arrangement" as shown by this plat; and hereby dedicate to the public, and for the public use forever, all the streets and alleys as herein indicated.

Witness our hands and seals this 10 day of November 1908.

In presence of
Lanetta N. Cardozo }
Phineas N. Cardozo }
H. V. Constantine }
H. A. Campbell }
H. A. Campbell }
H. A. Campbell }
State of Minnesota } ss.
County of Ramsey }

F. Dora Constantine
Trica Constantine
Louis Le Roy Constantine
Caddie L. Constantine
Helen R. Constantine
Solomon Cohen
Mamie E. Cohen
Theo. N. Espe
By Sumner A. Fernsworth his Attorney in fact

On this 10 day of November 1908 personally appeared before me, the undersigned, Jennie N. Cardozo and Phineas N. Cardozo her husband, F. Dora Constantine and Trica Constantine her husband, Louis Le Roy Constantine and Caddie L. Constantine his wife, Solomon Cohen and Mamie E. Cohen his wife, Helen R. Constantine, unmarried, and Theo. N. Espe, unmarried, by Sumner A. Fernsworth, his attorney in fact, to me well known, and acknowledged that they executed the foregoing certificate as their own free act and deed.

H. A. Campbell
Notary Public, Ramsey County, Minn.
My commission expires January 1st 1914

State of Minnesota,
County of Ramsey,
Office of the Registrar of Titles.

This is to certify that the within instrument is a true and correct copy of the original plat of said Addition as filed of record in this office in Book 1 of City Plats page 10.

Witness my hand and official seal this 16th day of November A.D. 1909.

M. Sigurdson
Registrar of Titles.

DOCUMENT NUMBER 5584 Certificate Number 1725-1727-21337-4416-1720
Books 5 page 422 + 424 Book 7 page 57 Book 13 page 28 + Book 6 page 1

Accepted by the Assembly of 1909
" " Board of Aldermen 11/22/1909
Approved Oct 27 1909
J. J. Redington
City Clerk

Accepted and approved this 16th day of Sept 1909

J. J. Redington } Plat
J. W. Jordan } Commissioners
H. W. Simons } City Engineer

We hereby certify that this plat is a true and correct copy of an original plat of "Cardozo's Re-arrangement" this day accepted and approved by this commission. Dated Sept 16 1909

J. J. Redington } Plat
J. W. Jordan } Commissioners
H. W. Simons } City Engineer

Taxes for the year 1909 on the lands described within and paid

NOV 4 1909
PAUL BOSTON
County Treasurer

TAXES PAID AND TRANSFER ENTERED
NOV 5 1909
EDW. G. KRANMER, Co. Auditor,
By J. Swallow Deputy.

CITY TREASURER'S OFFICE,
ST. PAUL, MINN.
NOV 5 1909
Approved and Paid City Treasurer