


WALTON HEIGHTS

ST. PAUL MINN.

590310 168

Scale 80 feet per inch

CORR & HILL, CIVIL ENGINEERS

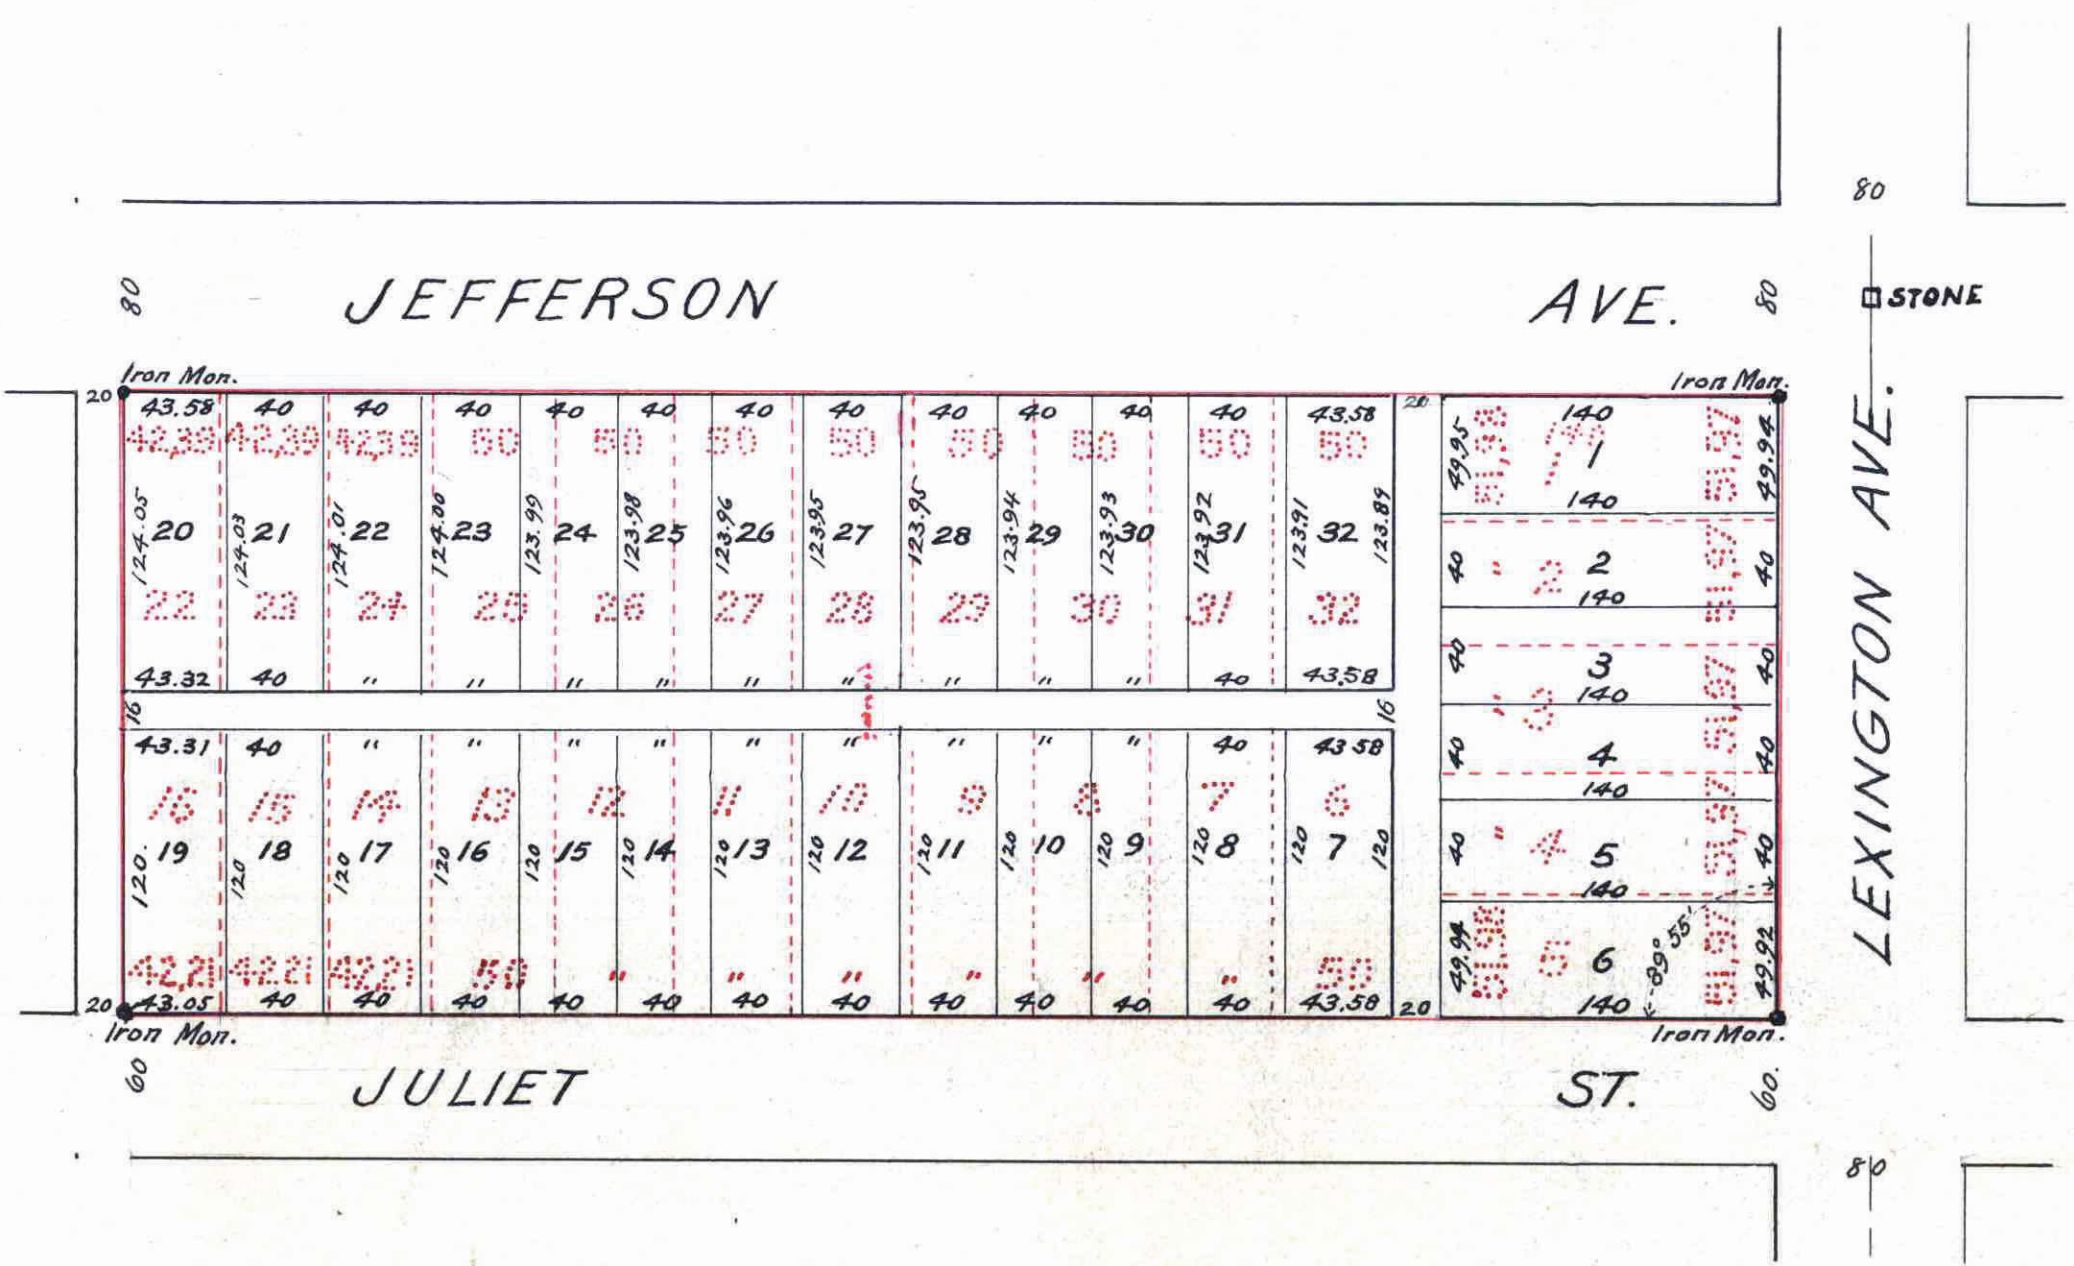

390310

I hereby certify to having surveyed and platted the property described on this map as WALTON HEIGHTS and have placed iron monuments at the corners of each and every block as shown on this map, and the same is correct.

James Corr
Surveyor.

STATE OF MINNESOTA }
County of Ramsey } ss. On this 28th day of May A.D. 1910 personally appeared before me, the undersigned, JAMES CORR, to me well known, and acknowledged that he executed the foregoing certificate as his own free act and deed.

Pray Walton
Notary Public

My Commission expires Sept 1 1914 Ramsey Co. Minn.

This is to certify that Allen McQuillan, Bachelor, Owner and proprietor of Lots 1 to 16 and 22 to 32, in Block 1, LEXINGTON PARK Plat 6. has caused the same to be resurveyed and replatted and hereafter known as WALTON HEIGHTS, as shown by this plat and hereby dedicates to the public, and for the public use forever, all the streets, avenues and alleys, as herein indicated.

Witness my hand and seal this 28th day of May A.D. 1910.

In presence of
James Corr
Pray Walton

Allen McQuillan

STATE OF MINNESOTA }
County of Ramsey } ss. On this 28th day of May A.D. 1910 personally came before me, the undersigned, Allen McQuillan, bachelor, to me well known and acknowledged that he executed the foregoing certificate as his own free act and deed.

James Corr
Notary Public

My Commission expires March 12 1914 Ramsey County Minn.

Accepted and Approved this 1st day of June A.D. 1910

John L. Jordan } Plat Commissioners.
John L. Jordan }
John L. Jordan City Engineer

Accepted by the Assembly June 2 1910

Accepted by the Board of Aldermen June 2 1910

Approved June 6 1910
Geo. S. Redington City Clerk.

This plat document is an UNOFFICIAL copy of a Subdivision Plat or Registered Land Survey and is made available for information purposes only.

To obtain an official copy please contact the Ramsey County Recorder's Office.

Taxes for the year 1909 on the lands described within paid.
JUN 8 - 1910
ST. PAUL, MINN.
JESSE PAUL, County Treasurer.
Per *J. J. Singer*

TAXES PAID AND TRANSFER ENTERED
JUN 9 1910
EDW. G. KRAMER, Co. Auditor.
By *W. H. Krammer* Deputy.

CITY TREASURER'S OFFICE,
ST. PAUL, MINN.
JUN 11 1910
Assessment PAID
S. A. PARKS WORTH, City Treas.
By *W. H. Krammer*

STATE OF MINNESOTA }
County of Ramsey } ss.
Office of the Register of Deeds.
This is to certify that the within instrument was filed for record in this office at St. Paul, on the 11th day of June, 1910, and that the same was duly recorded in Book 18 of said office.
James Blaine
Register of Deeds