


GODFREY'S RE.

Scale 1" to 40'

R. Holterhoff
Surveyor

439502

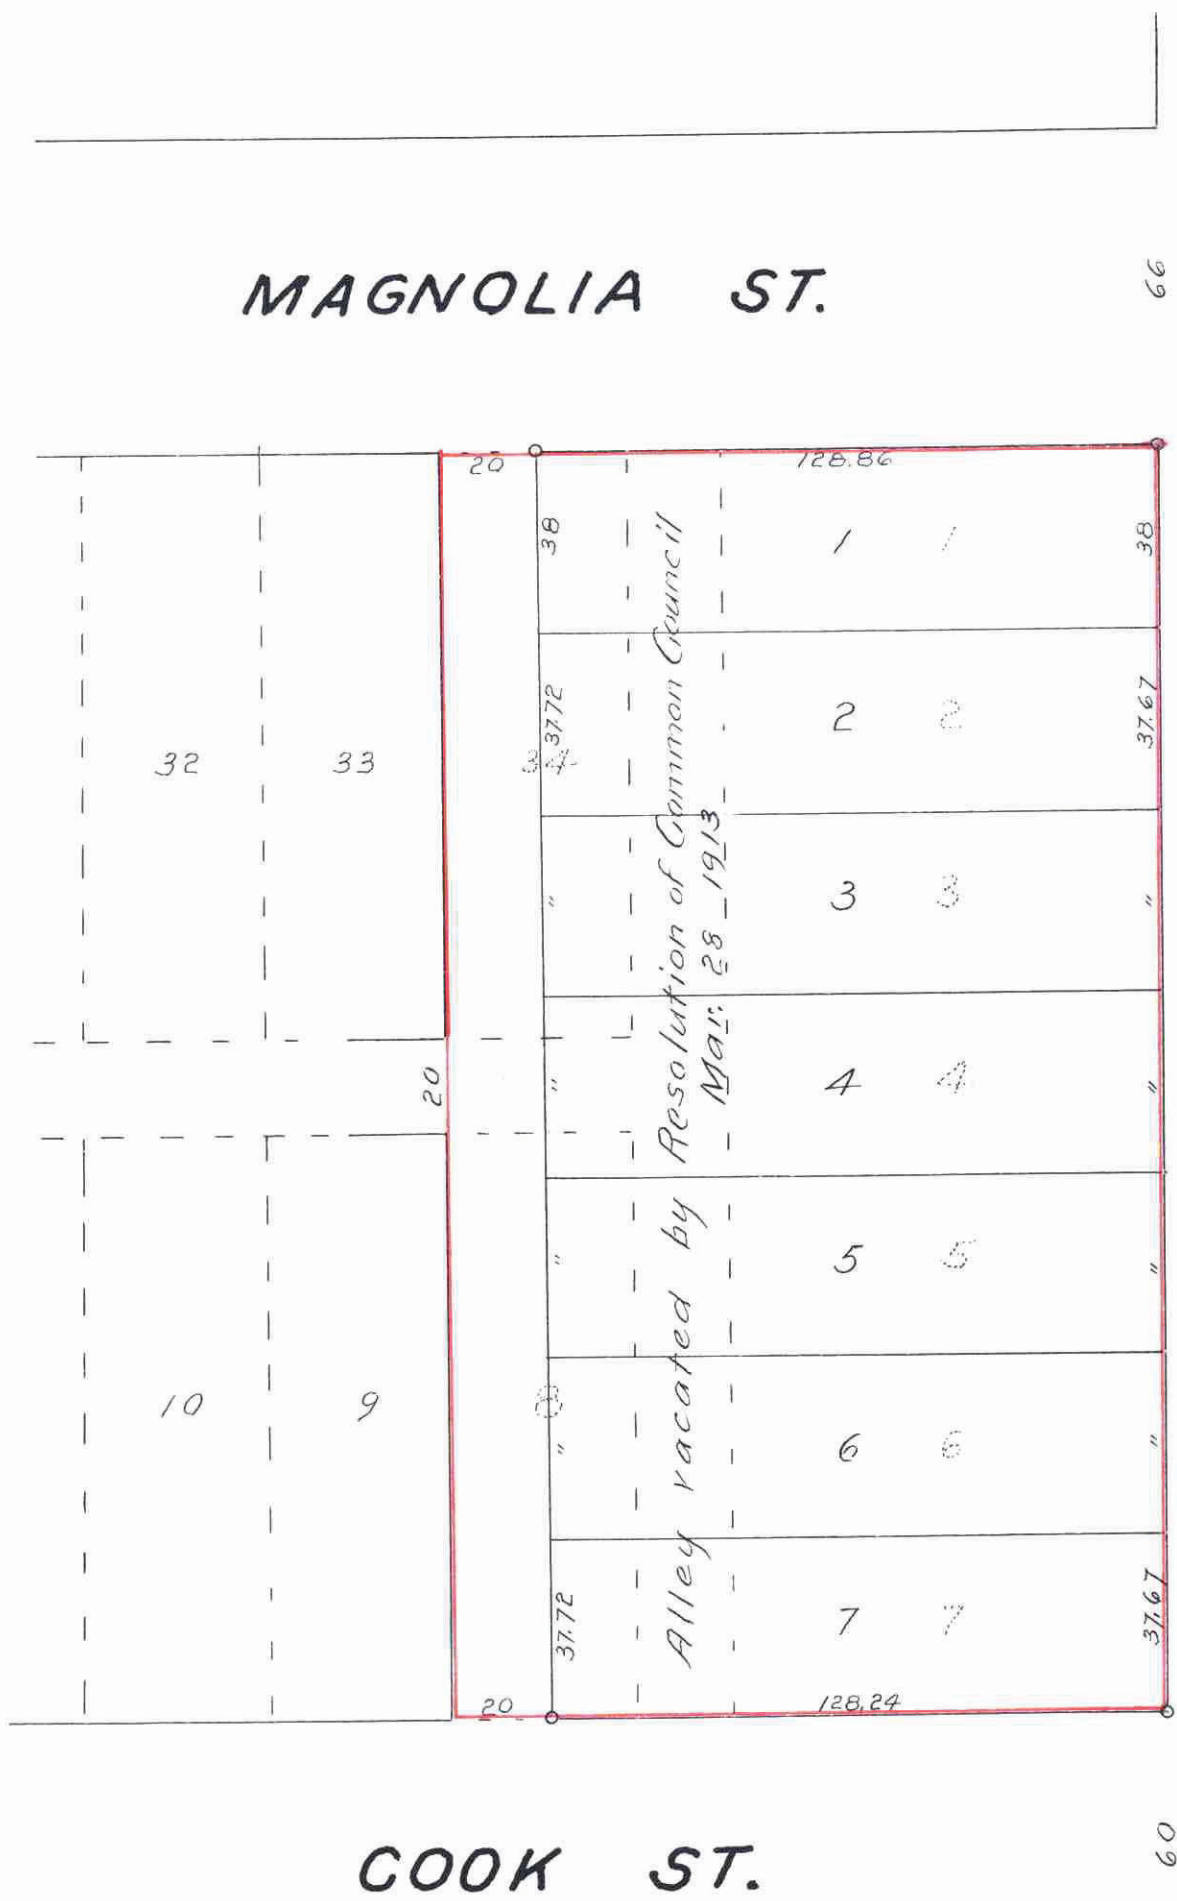

I hereby certify to having surveyed and
platted the property as described on this
map as GODFREY'S REARRANGEMENT, and
have placed iron monuments as shown,
and the same is correct.
R. Holterhoff
Surveyor.

State of Minnesota }
County of Ramsey }⁵⁵

On this 17th day of Dec. A.D. 1912
personally appeared before me, the undersigned, R.
Holterhoff, to me well known, and acknowledged that
he executed the foregoing certificate as his free act
and deed.

A. G. Moore
Notary Public, Ramsey Co. Minn.
My commission expires Oct. 27, 1919

This is to certify that Maud M. Godfrey, single, Anton Peterson, single, and John Alfred Johnson and
Hilda Christina Johnson his wife, proprietors of Lots 1, 2, 3, 4, 5, 6, 7, 8 and 34 of Windsor
Square, have caused the same to be surveyed and platted and heretter known as
GODFREY'S RE., as shown by this plat, and hereby dedicate to the public, for public
use forever, the alley as shown hereon.
Witness our hands and seals this 7th day of Dec. A.D. 1912.

In presence of
A. G. Moore
George H. Conrad
James Jordan

Maud M. Godfrey
Anton Peterson
John Alfred Johnson
Hilda Christina Johnson

State of Minnesota }
County of Ramsey }⁵⁵

On this 19th day of Dec. A.D. 1912, personally appeared before me,
the undersigned, Maud M. Godfrey, Anton Peterson, and John Alfred Johnson and
Hilda Christina Johnson his wife, to me well known, and acknowledged that they executed
the foregoing instrument as their free act and deed.

A. G. Moore
Notary Public, Ramsey Co. Minn.
My commission expires Oct. 27, 1919

Accepted and approved this 17th day of Dec. A.D. 1912
George H. Conrad
James Jordan } Plat Commissioners
Charles A. Bronson
O. Clausen City Engineer

Accepted by the Assembly, Dec. 19th 1912
" " " Board of Aldermen, Dec 17th 1912
Approved, Dec 23rd 1912
Geo. J. Redington
City Clerk.

CITY TREASURER'S OFFICE,
ST. PAUL, MINN.
MAY 16 1913
Assessment PAID
S. A. FAIRBURN, City Treas.
By *C. H. McDonald*

STATE OF MINNESOTA,
County of Ramsey, ss:
Office of the Register of Deeds.
This is to certify that the within instrument
was filed for record in this office at St. Paul,
on the 16th day of May
A. D. 1913, at 9³⁰ o'clock P. M., and that the
same was duly recorded in Book
of *Transcripts* Page *931*
M. J. Appert
Register of Deeds.
By _____ Deputy.

Taxes for the year 1912 on the
lands described within PAID
MAY 15 1913
FRANK J. OBST, Treasurer
RAMSEY COUNTY, MINN.

PAID
MAY 16 1913
JAMES J. RIES, COUNTY AUDITOR

This plat document
is an UNOFFICIAL
copy of a
Subdivision Plat or
Registered Land Survey
and is made available for
information purposes only.
To obtain an official copy
please contact the Ramsey
County Recorder's Office.

