

# RUETH'S REARRANGEMENT

20 feet = 1 inch.

Edward R. Schafer,  
Surveyor.

52

I hereby certify to having surveyed and platted the property as described on this map as RUETH'S REARRANGEMENT and have placed iron monuments at the corners of the block as shown on this map, and the same is correct.


Edward R. Schafer,  
Surveyor.

State of Minnesota } ss.  
County of Ramsey.

On this 17<sup>th</sup> day of Jan A.D. 1913,  
personally appeared before me the undersigned Edward R. Schafer, to me well known and acknowledged that he executed the foregoing certificate as his own free act and deed.

Silas C. Forman

Notary Public, Ramsey Co. Minn.  
My commission expires January 27<sup>th</sup> 1914.

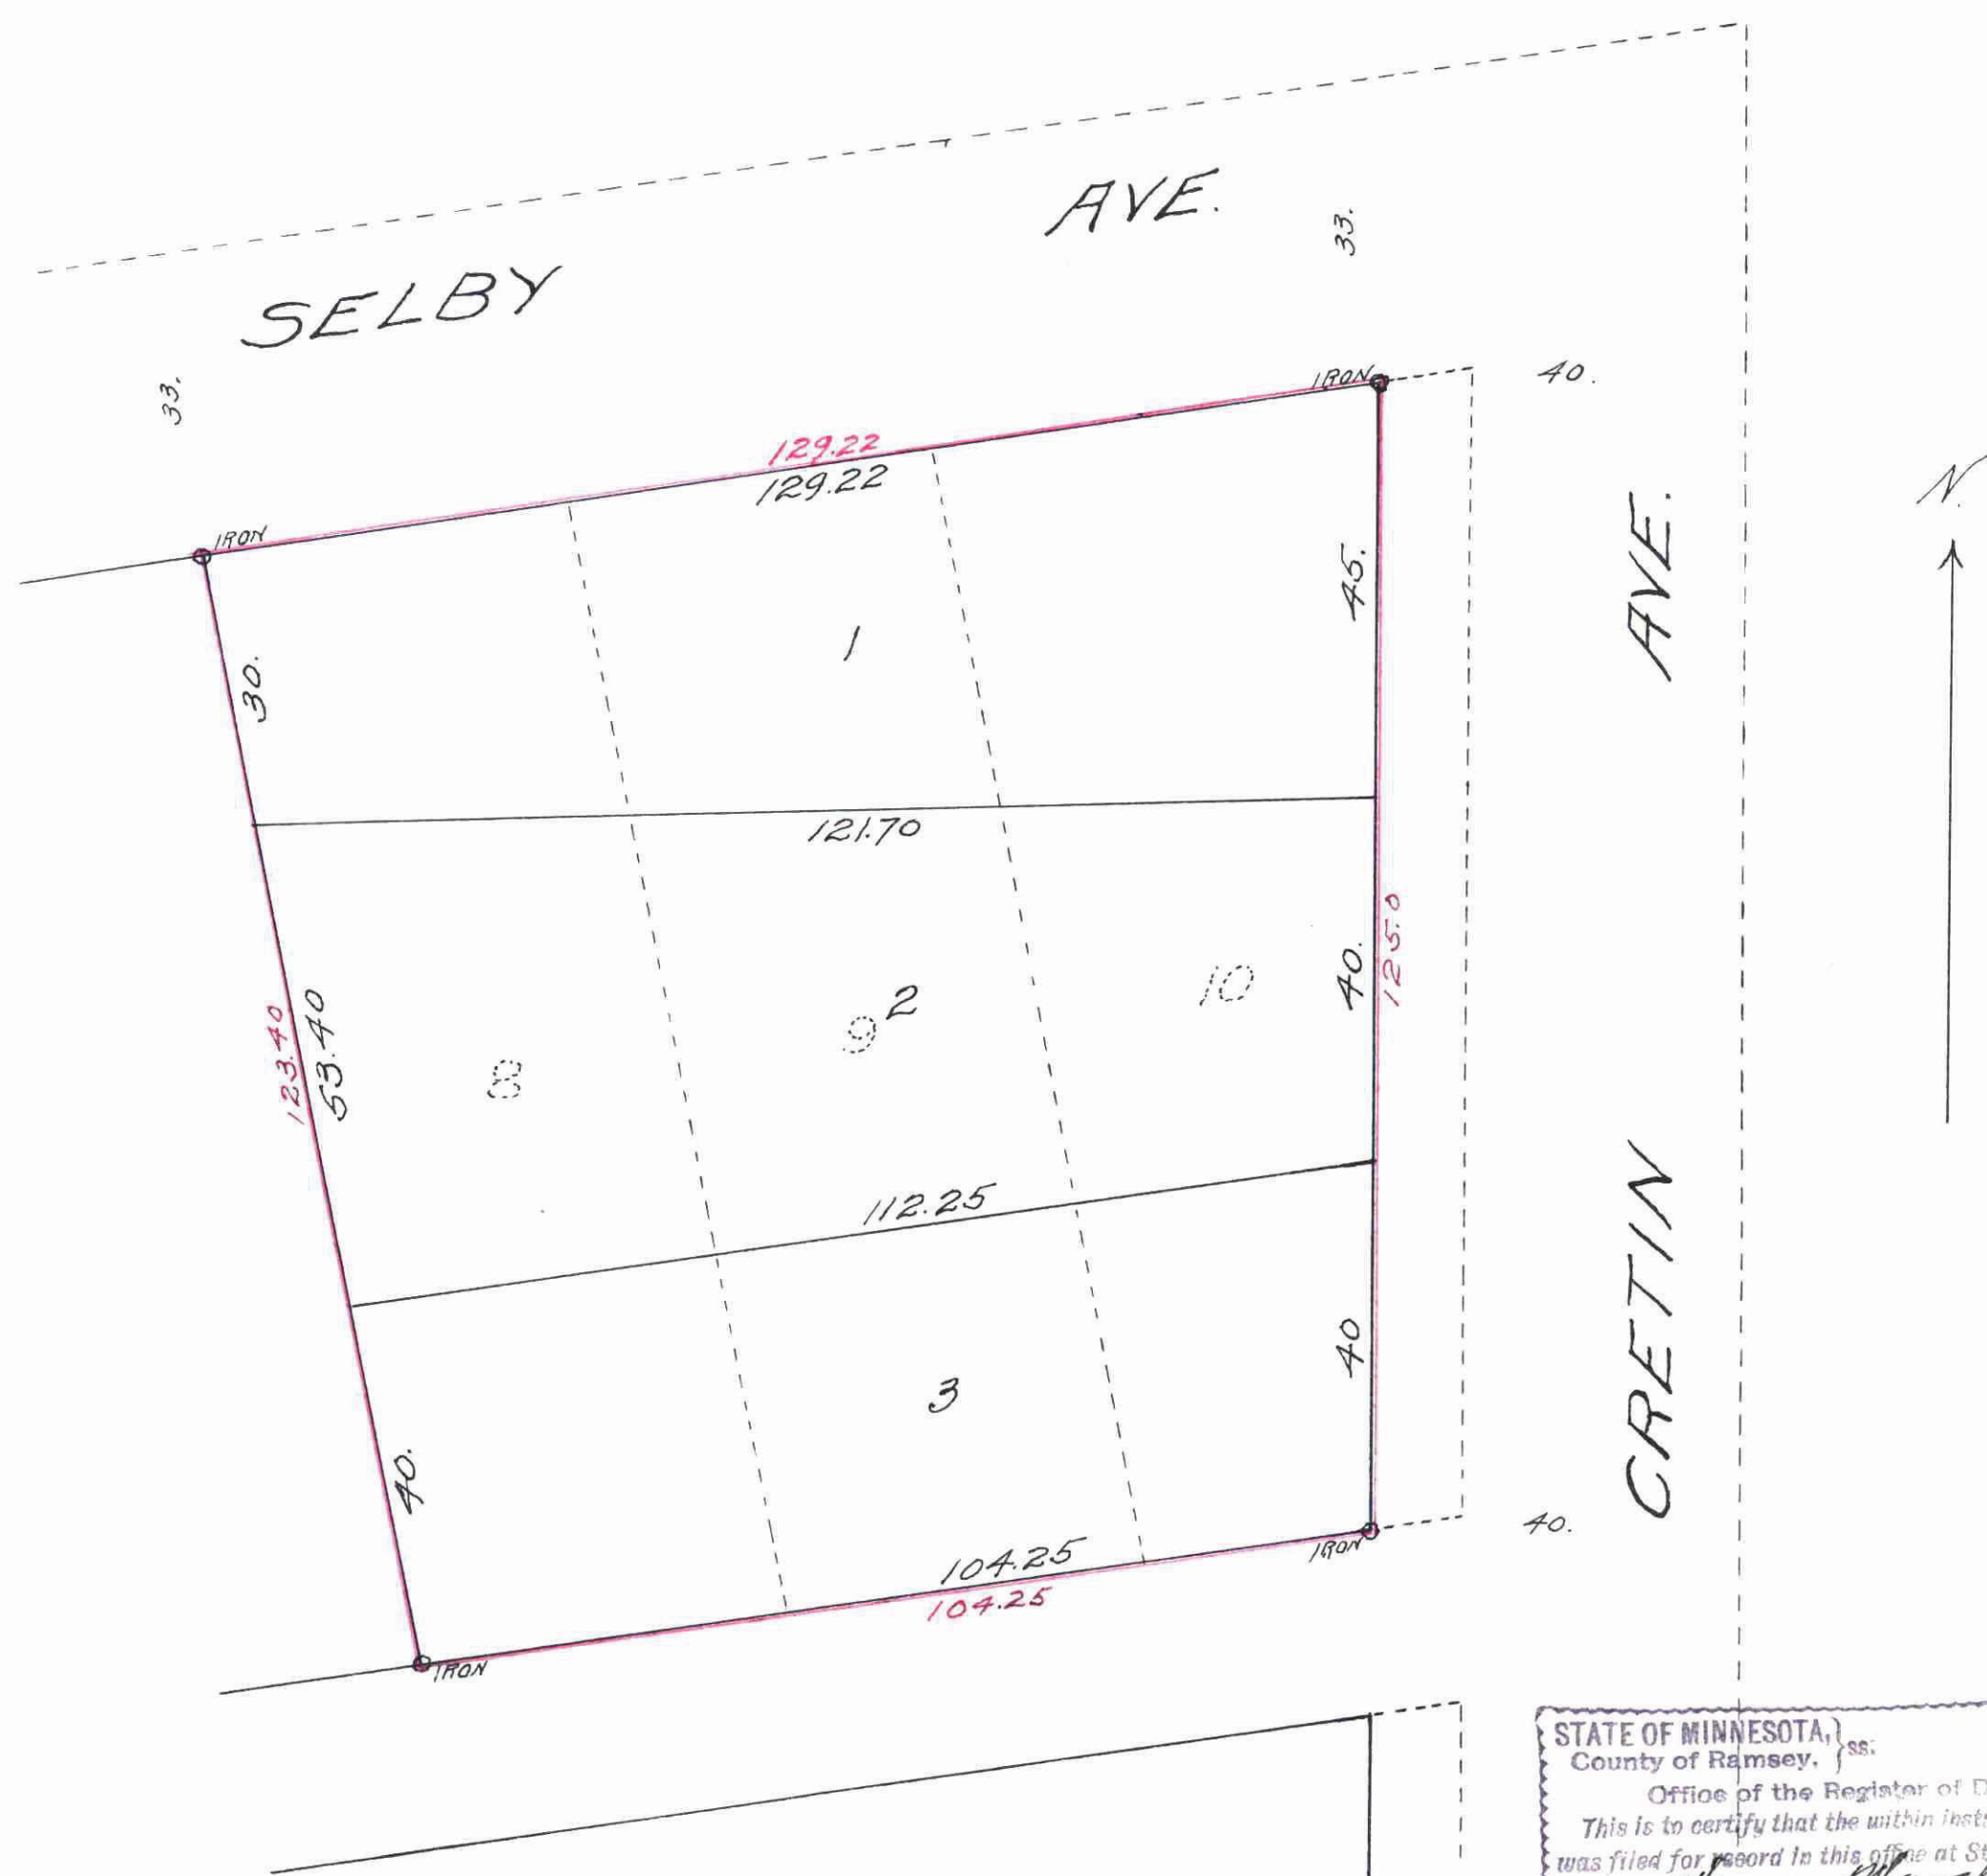

This is to certify that Fannie T. Rueth and Michael Rueth, her husband, and William G. Sleeth (unmarried) are the owners of Lots 8, 9, & 10, Block 57 Desnoyer Park, and Michael J. Dunn, the mortgagee of said property have caused the same to be surveyed and platted and hereafter known as "RUETH'S REARRANGEMENT" as shown on this map, and hereby dedicate to the public and for the public use forever all the streets, avenues, and alleys, as hereon indicated.

Witness our hands and seals this 18<sup>th</sup> day of Jan 1913.

In presence of  
M. E. Coan  
Eleanor Kistner

Fannie T. Rueth  
Michael Rueth  
William G. Sleeth  
Michael J. Dunn

State of Minnesota } ss.  
County of Ramsey.

On this 18<sup>th</sup> day of Jan A.D. 1913,  
personally appeared before me the undersigned Fannie T. Rueth and Michael Rueth, her husband and William G. Sleeth (unmarried) to me well known and acknowledged that they executed the foregoing certificate as their own free act and deed.

Notary Public Ramsey Co. Minn.  
My commission expires

State of Wisconsin } ss.  
County of Richland.

On this 2<sup>nd</sup> day of Jan A.D. 1913,  
personally appeared before me Michael J. Dunn, to me known to be one of the persons described in and who executed the foregoing certificate and acknowledged that he executed the same as his own free act and deed.

Notary Public Richland Co. Wis.  
My commission expires Oct 26, 1914

Accepted by the Assembly March 6<sup>th</sup> - 1913.

Accepted by the Board of Aldermen, March 4<sup>th</sup> - 1913.

Approved March 7<sup>th</sup> - 1913.  
Geo. J. Redington  
City Clerk.

Accepted and approved this 4<sup>th</sup> day of March A.D. 1913.

George H. Hendrick,  
Jas. B. Jordan }  
Charles W. Bronson } Plot Commissioners.  
Rocur Klausen }  
City Engineer.

STATE OF MINNESOTA, ss.  
County of Ramsey.  
Office of the Registrar of Deeds  
This is to certify that the within instrument was filed for record in this office at St. Paul, on the 17<sup>th</sup> day of March A. D. 1913, at 11:45 o'clock A.M., and that the same was duly recorded in Book 31 of Deeds, Page 6.  
M. J. Aggerud  
Registrar of Deeds.  
Deputy.

CITY TREASURER'S OFFICE,  
ST. PAUL, MINN.  
MAR 17 1913  
Assessment PAID  
S. A. FARNSWORTH, City Treas.  
By: G. Schneider

TAXES PAID  
AND TRANSFER ENTERED  
MAR 17 1913

GEO. J. REDINGTON, COUNTY AUDITOR  
BY: Silas C. Forman  
DEPUTY

For the year 1912 on the  
taxes paid within PAID  
MAR 17 1913  
GEO. J. REDINGTON, COUNTY AUDITOR  
BY: Silas C. Forman  
DEPUTY

FMGUST