


CITY BANK REARRANGEMENT.

ST. PAUL, MINN.
SCALE 10 FT. TO 1 IN.

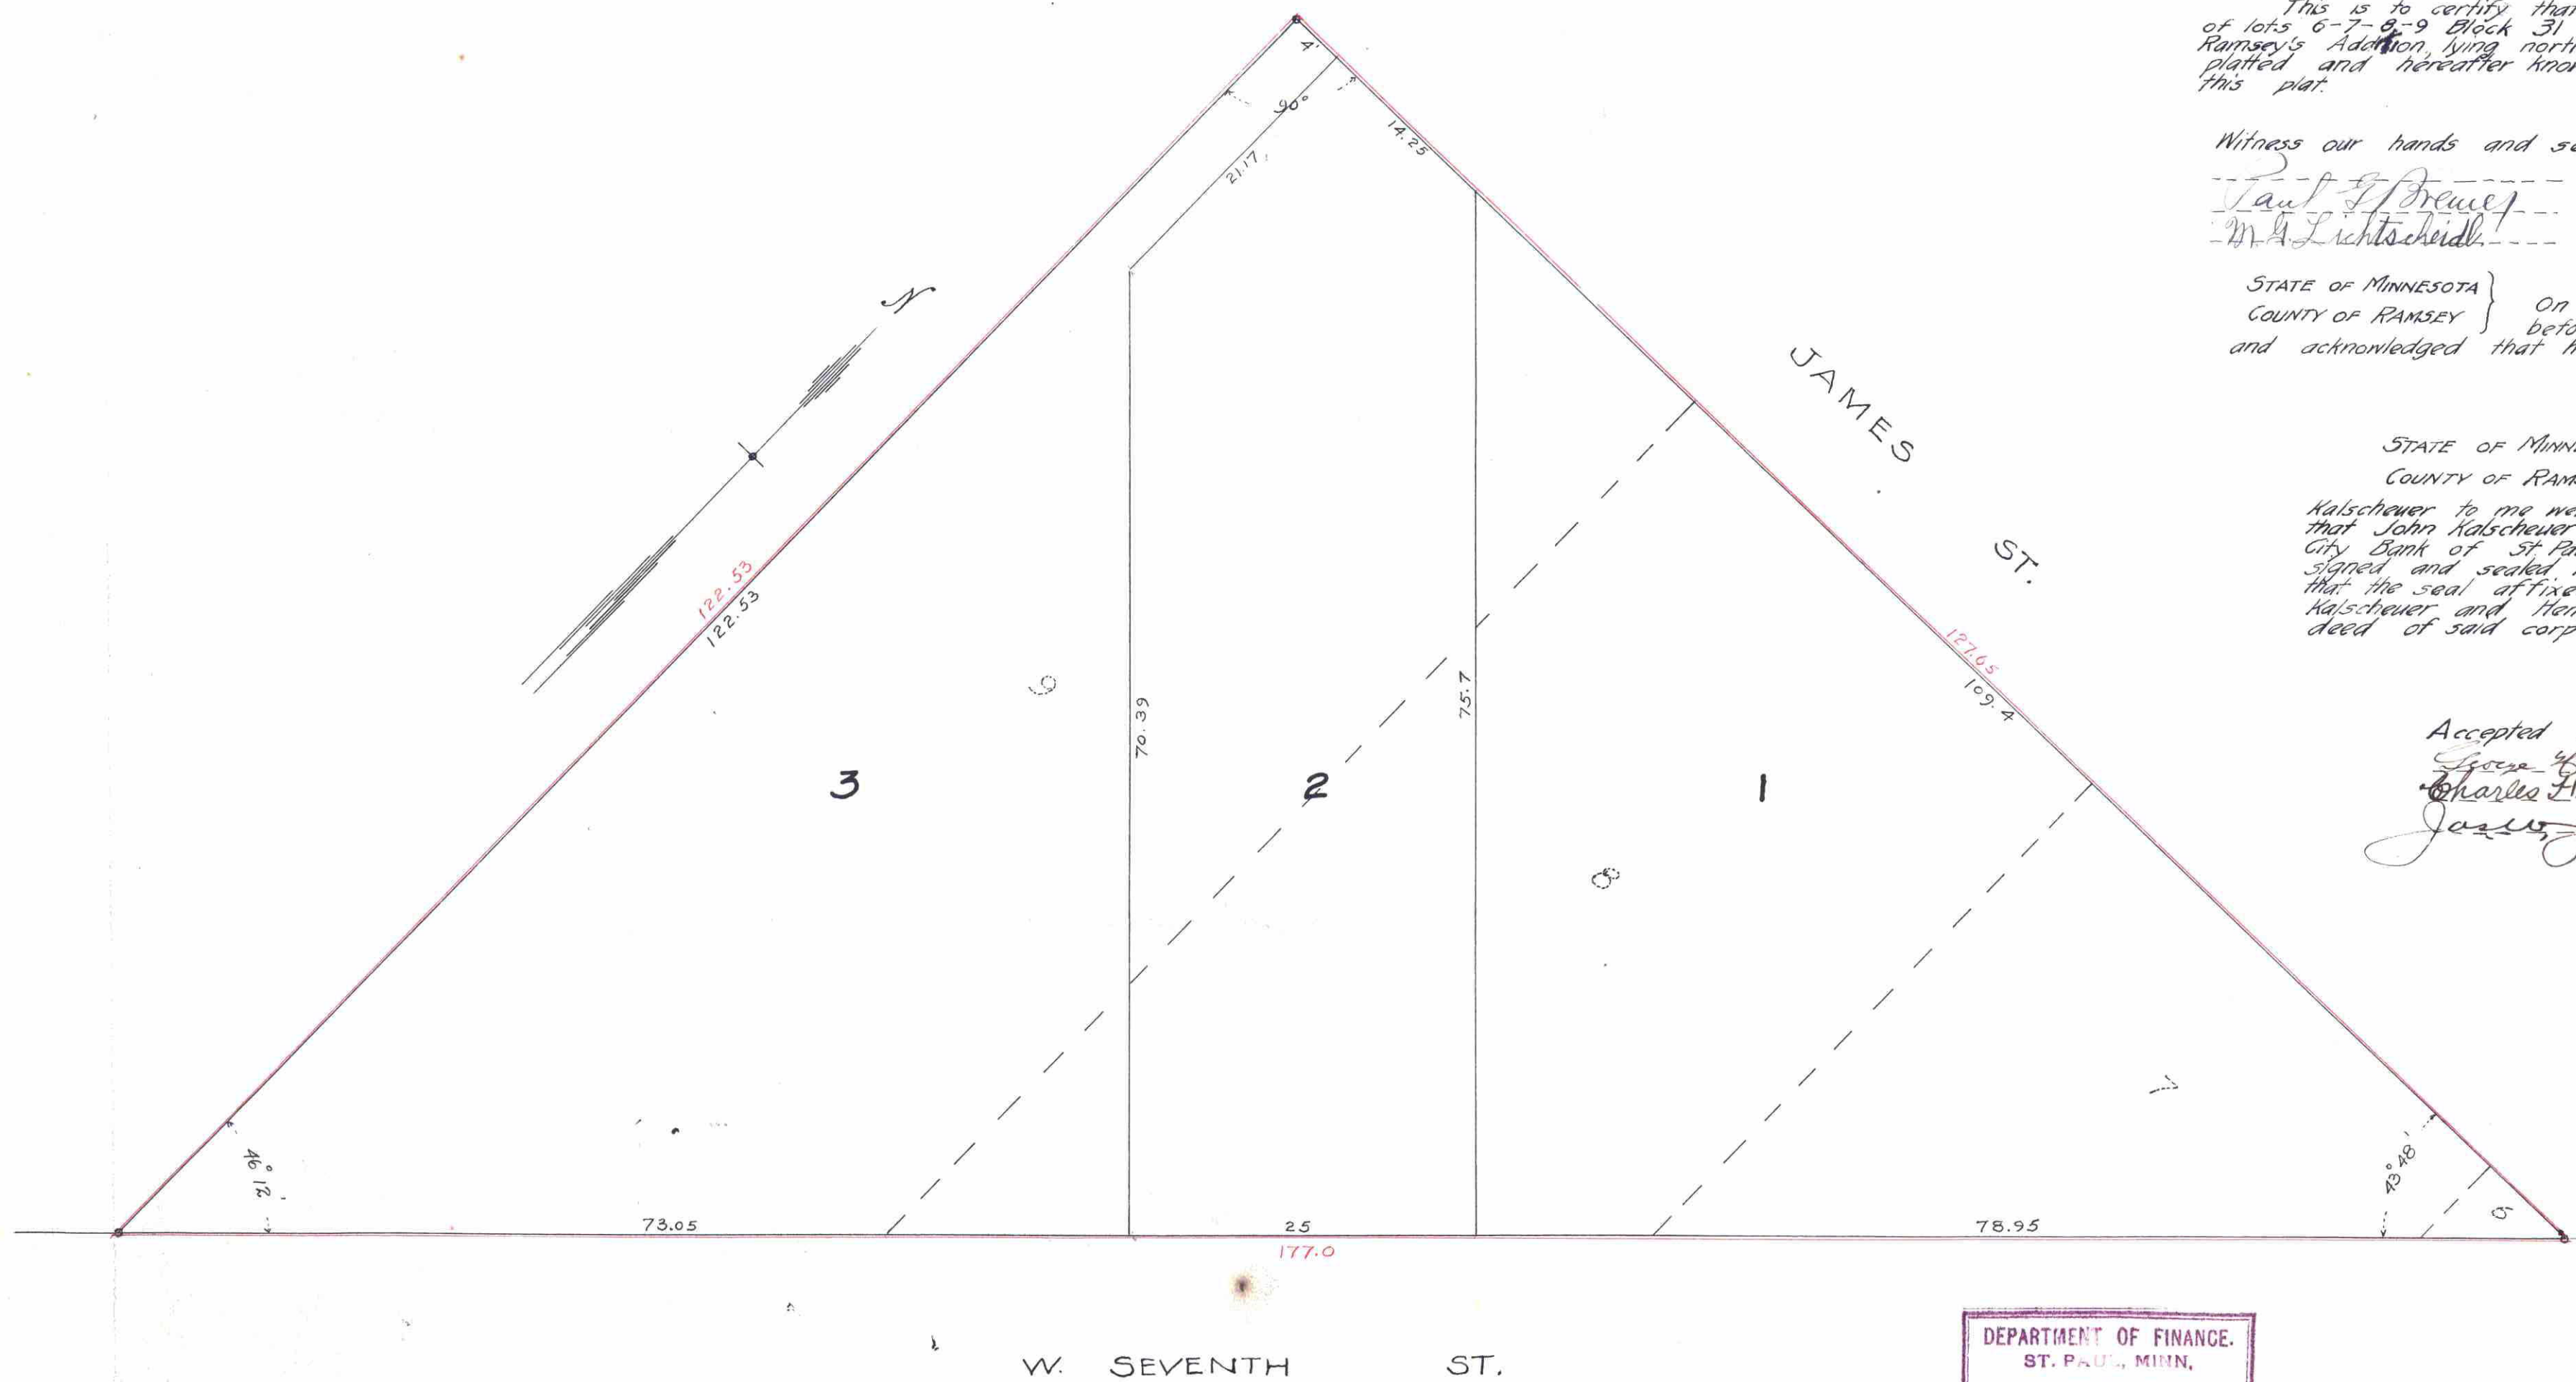

I hereby certify to having surveyed and platted the property as described on this map as City Bank Rearrangement, St. Paul, Minnesota and have placed iron monuments at the corners as shown on this map and the same is correct.

J. J. Armstrong
Surveyor.

5266
STATE OF MINNESOTA }
COUNTY OF RAMSEY } On this 13th day of February A.D. 1915 personally appeared before the undersigned, F. J. Armstrong to me well known and acknowledged that he executed the foregoing certificate as his own free act and deed.

472661

F. J. Armstrong
Notary Public Ramsey Co, Minn.
My commission expires Sept 20 1916

This is to certify that Louis Anderson, a bachelor and the City Bank of St. Paul, owners of lots 6-7-8-9 Block 31 Thomas Daly's subdivision of Blocks 10 & 31 of Jinson Brown and Ramsey's Addition, lying north of Seventh Street have caused the same to be surveyed and platted and hereafter known as, "City Bank Rearrangement", St. Paul, Minnesota as shown on this plat.

Witness our hands and seals this 13th day of February A.D. 1915

Louis Anderson City Bank of Saint Paul President.
Henry Kalscheuer Cashier.
John Kalscheuer Cashier.

STATE OF MINNESOTA }
COUNTY OF RAMSEY } On this 13th day of Feb. A.D. 1915 personally appeared before me the undersigned Louis Anderson, a bachelor, to me well known and acknowledged that he executed the foregoing certificate as his own free act and deed.

Louis Anderson
Notary Public Ramsey Co, Minn.
My commission expires Sept 7 1917

STATE OF MINNESOTA }
COUNTY OF RAMSEY } On this 13th day of Feb. A.D. 1915 personally appeared before me, the undersigned, John Kalscheuer and Henry Kalscheuer to me well known who, being by me duly sworn, did say each for himself that John Kalscheuer is the president and Henry Kalscheuer is the cashier of the City Bank of St. Paul, Minnesota, a corporation and that the foregoing instrument was signed and sealed in behalf of said corporation and the said John Kalscheuer and Henry Kalscheuer acknowledged said instrument to be the free act and deed of said corporation.

John Kalscheuer
Notary Public Ramsey Co, Minn.
My commission expires Sept 7 1917

Accepted and approved this 20th day of February A.D. 1915.

Charles H. Brown Plat Commissioners.
Jesse Jordan

M. W. Fitzgerald Commissioner of Public Works.

Accepted by the Council Feb 24 1915
Approved Feb 25 1915

John J. Farney City Clerk.

TAXES PAID
AND TRANSFER ENTERED
MAR 5 1915
GEO. J. RIES, COUNTY AUDITOR
By *Ringwald*

DEPARTMENT OF FINANCE.
ST. PAUL, MINN.
MAR 5 - 1915
Assessment PAID
S. A. FARNSWORTH, Commissioner,
By *Schneider*

Taxes for the year of 1914 on the lands described within PAID
MAR 5 - 1915
Marta J. Farney, Treasurer,
RAMSEY COUNTY, MINN.
Per *Ringwald*

This is to certify that the within instrument was filed for record in this office at St. Paul, on the 8th day of March A. D. 1915 and that the same was duly recorded in Book 33 of Town Plats Pages 20
M. W. Fitzgerald
J. J. Farney

472661

3858