


# ROBERT P. LEWIS COMPANY SUBDIVISION

Scale 1" to 100'  
o Indicates Iron Monument

Surveyed By  
T. Milton Fowble  
St. Paul, Minn.

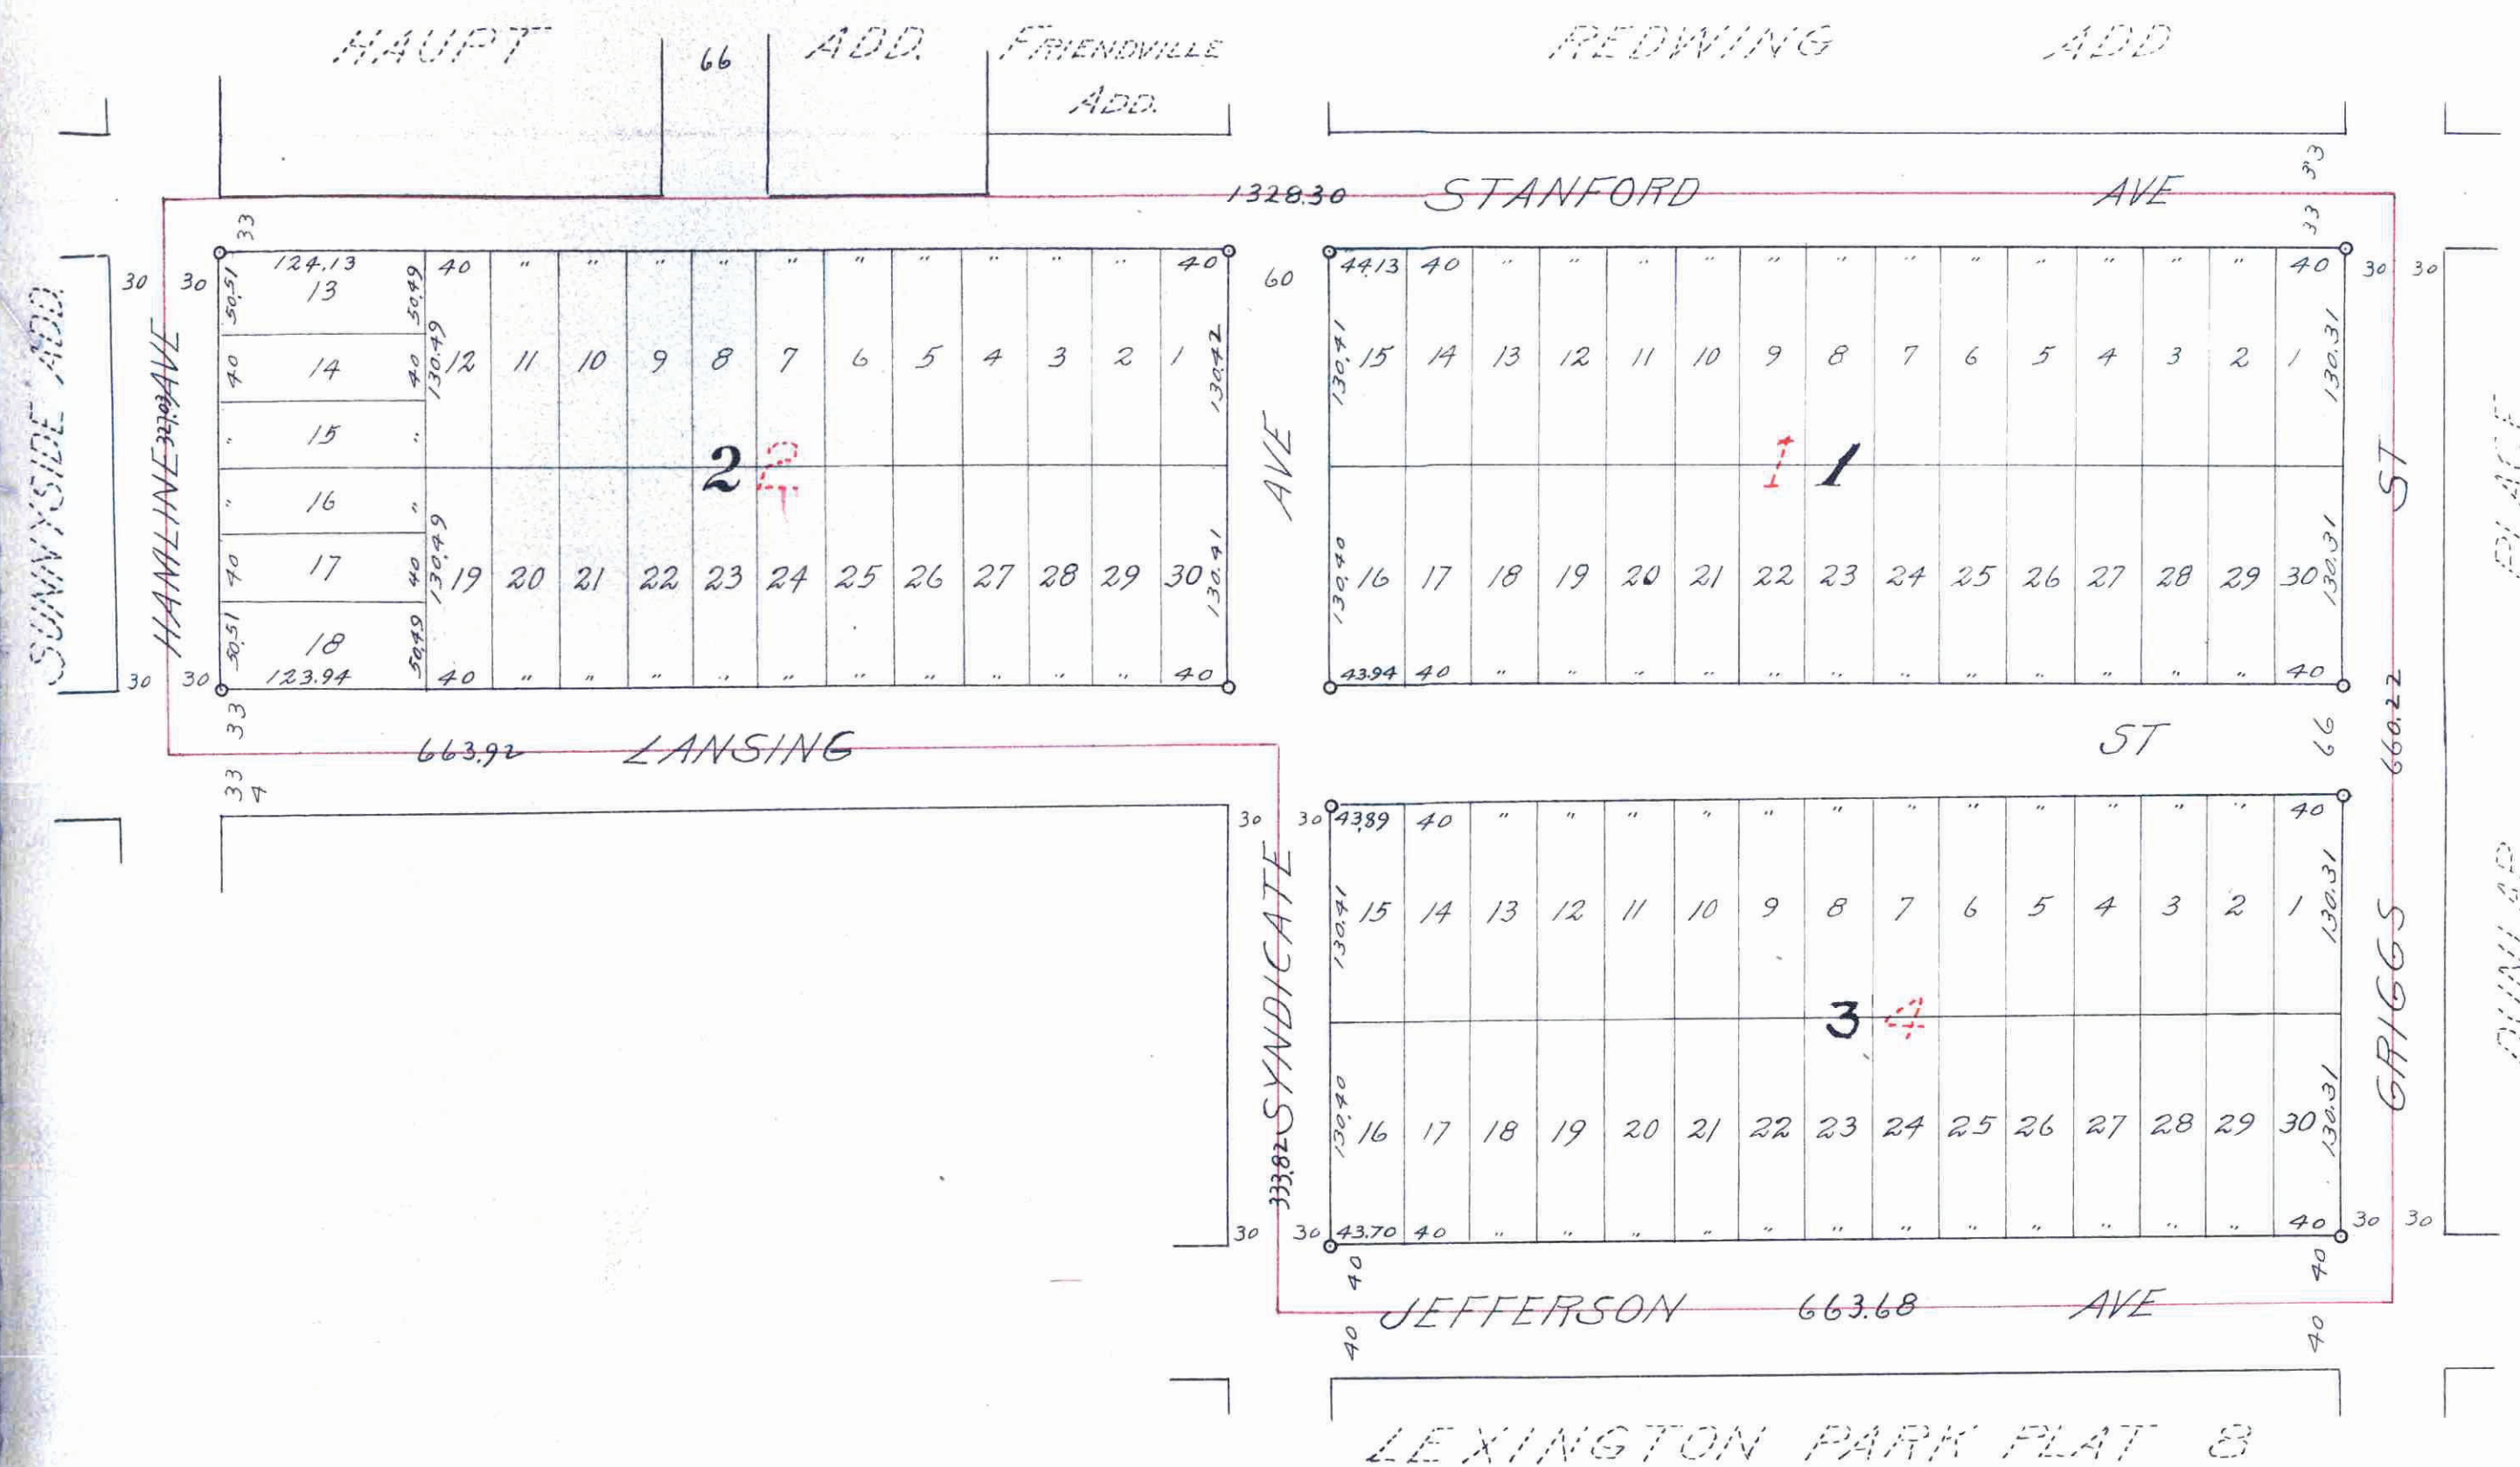

I hereby certify to having surveyed and platted the property described on this map as ROBERT P. LEWIS COMPANY SUBDIVISION and have placed iron monuments at the block corners as hereon indicated and the same is correct.

*T. Milton Fowble*  
Surveyor.

State of Minnesota }  
County of Ramsey }  
On this 3rd day of August A.D. 1915 before me personally appeared T. Milton Fowble, to me known to be the person who executed the foregoing certificate and acknowledged that he executed the same as his free act and deed.

*Justin B. Ryan*  
Notary Public, Ramsey County, Minnesota  
My Commission expires July 19, 1919

This is to certify that the ROBERT P. LEWIS COMPANY, a corporation, organized under the laws of the State of Minnesota, owner of blocks 1, 2 and 4 Stinson's Hamline Avenue Addition to St. Paul, Ramsey County, Minnesota, has caused the same to be surveyed and platted and hereafter known as ROBERT P. LEWIS COMPANY SUBDIVISION, as shown by this plat and hereby dedicates to the public for public use forever, all the streets and avenues as hereon designated.

Witness our hands and the corporate seal of the above named corporation this 3rd day of August A.D. 1915.

In presence of *George W. Skold* By *Robert P. Lewis* President  
*W. C. Miller* *Ada E. Brack* Secretary

State of Minnesota }  
County of Ramsey }  
On this 3rd day of August A.D. 1915, before me personally appeared Robert P. Lewis and Ada E. Brack, to me known to be the persons who executed the foregoing certificate, who being duly sworn did each say for himself and herself respectively, that Robert P. Lewis is the president, and Ada E. Brack is the secretary of the ROBERT P. LEWIS COMPANY, a corporation, and that the seal attached to the foregoing instrument is the corporate seal of said corporation and that said instrument was signed and sealed in behalf of said corporation by authority of its board of directors and that said instrument is the free act and deed of said corporation.

*George W. Skold*  
Notary Public, Ramsey County, Minnesota  
My Commission expires August 16, 1916

Accepted and approved this 7th day of August A.D. 1915--

*George W. Skold*  
*Charles H. Brown*  
*James J. Jaden*  
*W. C. Miller*

Flat Commissioners  
Commissioner of Public Works

Accepted by the Council. Aug 7th - 1915.  
Approved *John J. Farley*  
City Clerk

Taxes for the year of 1914 on the lands described within PAID  
AUG 16 1915  
MORTGAGE OFFICE, TREASURER,  
RAMSEY COUNTY, MINN.  
*W. C. Miller*

TAXES PAID  
AND TRANSFER ENTERED  
AUG 16 1915  
GEO. J. BIES, COUNTY AUDITOR  
*W. C. Miller*

DEPARTMENT OF FINANCE,  
ST. PAUL, MINN.  
AUG 16 1915  
Assessment  
S. A. L. SCHMIDLER, Commissioner  
*E. Schneider*  
(How installments paid to date)

This plat document is an UNOFFICIAL copy of a Subdivision Plat or Registered Land Survey and is made available for information purposes only.

To obtain an official copy please contact the Ramsey County Recorder's Office.

DOCUMENT NUMBER 20644  
CERTIFICATE NUMBER 19357  
BOOK 51 PAGE 23  
STATE OF MINNESOTA  
County of Ramsey  
OFFICE OF THE REGISTER OF TITLES  
I hereby certify that the foregoing is a true and correct copy of the original as filed in my office at St. Paul, on the 16th day of August, A. D. 1915.

*W. C. Miller*  
Registrar of Titles  
County of Ramsey, Minn.

20644