

SCHULTZ REAR.


o indicates iron
Scale 20 Feet per inch

F. J. Armstrong, Surveyor

66

Mrs.

Fairview

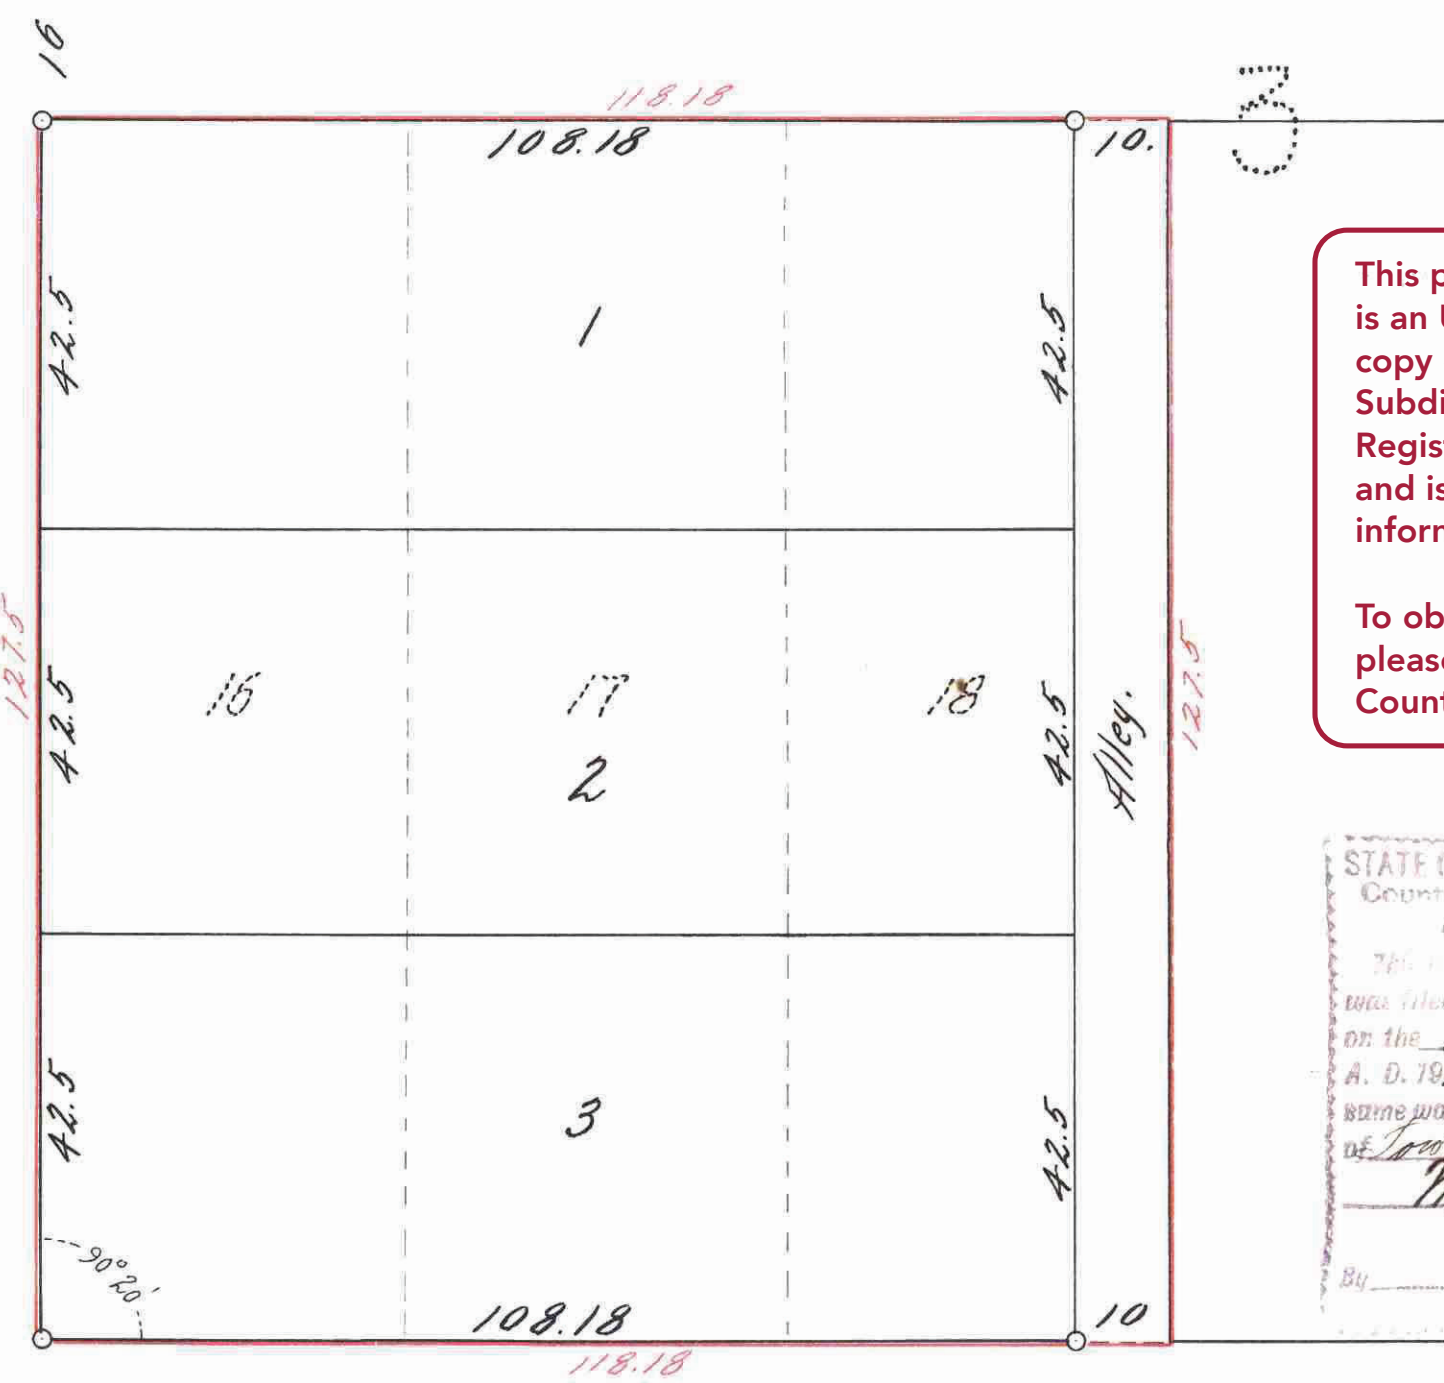

This plat document is an UNOFFICIAL copy of a Subdivision Plat or Registered Land Survey and is made available for information purposes only.

To obtain an official copy please contact the Ramsey County Recorder's Office.

STATE OF MINNESOTA
County of Ramsey
Office of the Register of Deeds
720 ...
on the 8th day of August
A. D. 1916 ...
M. W. Fitzgerald
G. L. ...

I hereby certify to having surveyed & platted the property described on this map as, Schultz Rear, and have placed irons at the corners, as shown on this map, and the same is correct.
F. J. Armstrong
Surveyor

State of Minnesota } On this 11th day of
County of Ramsey } July A.D. 1916
personally appeared before the under-
signed, F. J. Armstrong, to me well known
and acknowledged that he executed the
foregoing certificate as his own free act
and deed.
L. Ethel J. Dodge
Notary Public, Ramsey Co., Minn.
My Commission expires, Jan. 24, 1917

This is to certify that Jessamine Gladys Montgomery and Fred H. Montgomery her husband, proprietors of, Lots 16, 17 & 18 Block 3, Glenwood Park Addition, have caused the same to be surveyed and platted and hereafter known as Schultz Rear, as shown by this plat and hereby dedicate to the public and for public use forever, all the streets, avenues and alleys as herein indicated.
Witness our hands and seals this 12th day of July 1916
In presence of
A. Marquissen }
Orvin Kipp }
Jessamine Gladys Montgomery
Fred H. Montgomery

State of Minnesota } On this 12th day of July A.D. 1916, personally
County of Ramsey } came before me the undersigned, Jessamine Gladys
Montgomery and Fred H. Montgomery her husband, to me well known, and
acknowledged that they executed the foregoing certificate as their own free
act and deed.
Orvin Kipp
Notary Public, Ramsey Co., Minn.
My Commission expires, April 19, 1919

Accepted and approved this 15th day of July A.D. 1916
G. J. Ries }
Charles H. Johnson }
James }
City Commissioners
Commissioner of Public Works.
Accepted by the Council, - JULY 15th - 1916.
Approved, - JULY 17th - 1916.
City Clerk.

Taxes for the year of 1916 on the
lands described within PAID
JUL 26 1916
Martin J. O'Malley, Treasurer
RAMSEY COUNTY, MINN.

TAXES PAID
AND TRANSFER ENTERED
JUL 26 1916
GEO. J. RIES, COUNTY AUDITOR

DEPARTMENT OF FINANCE
ST. PAUL, MINN.
AUG - 1916

499733