
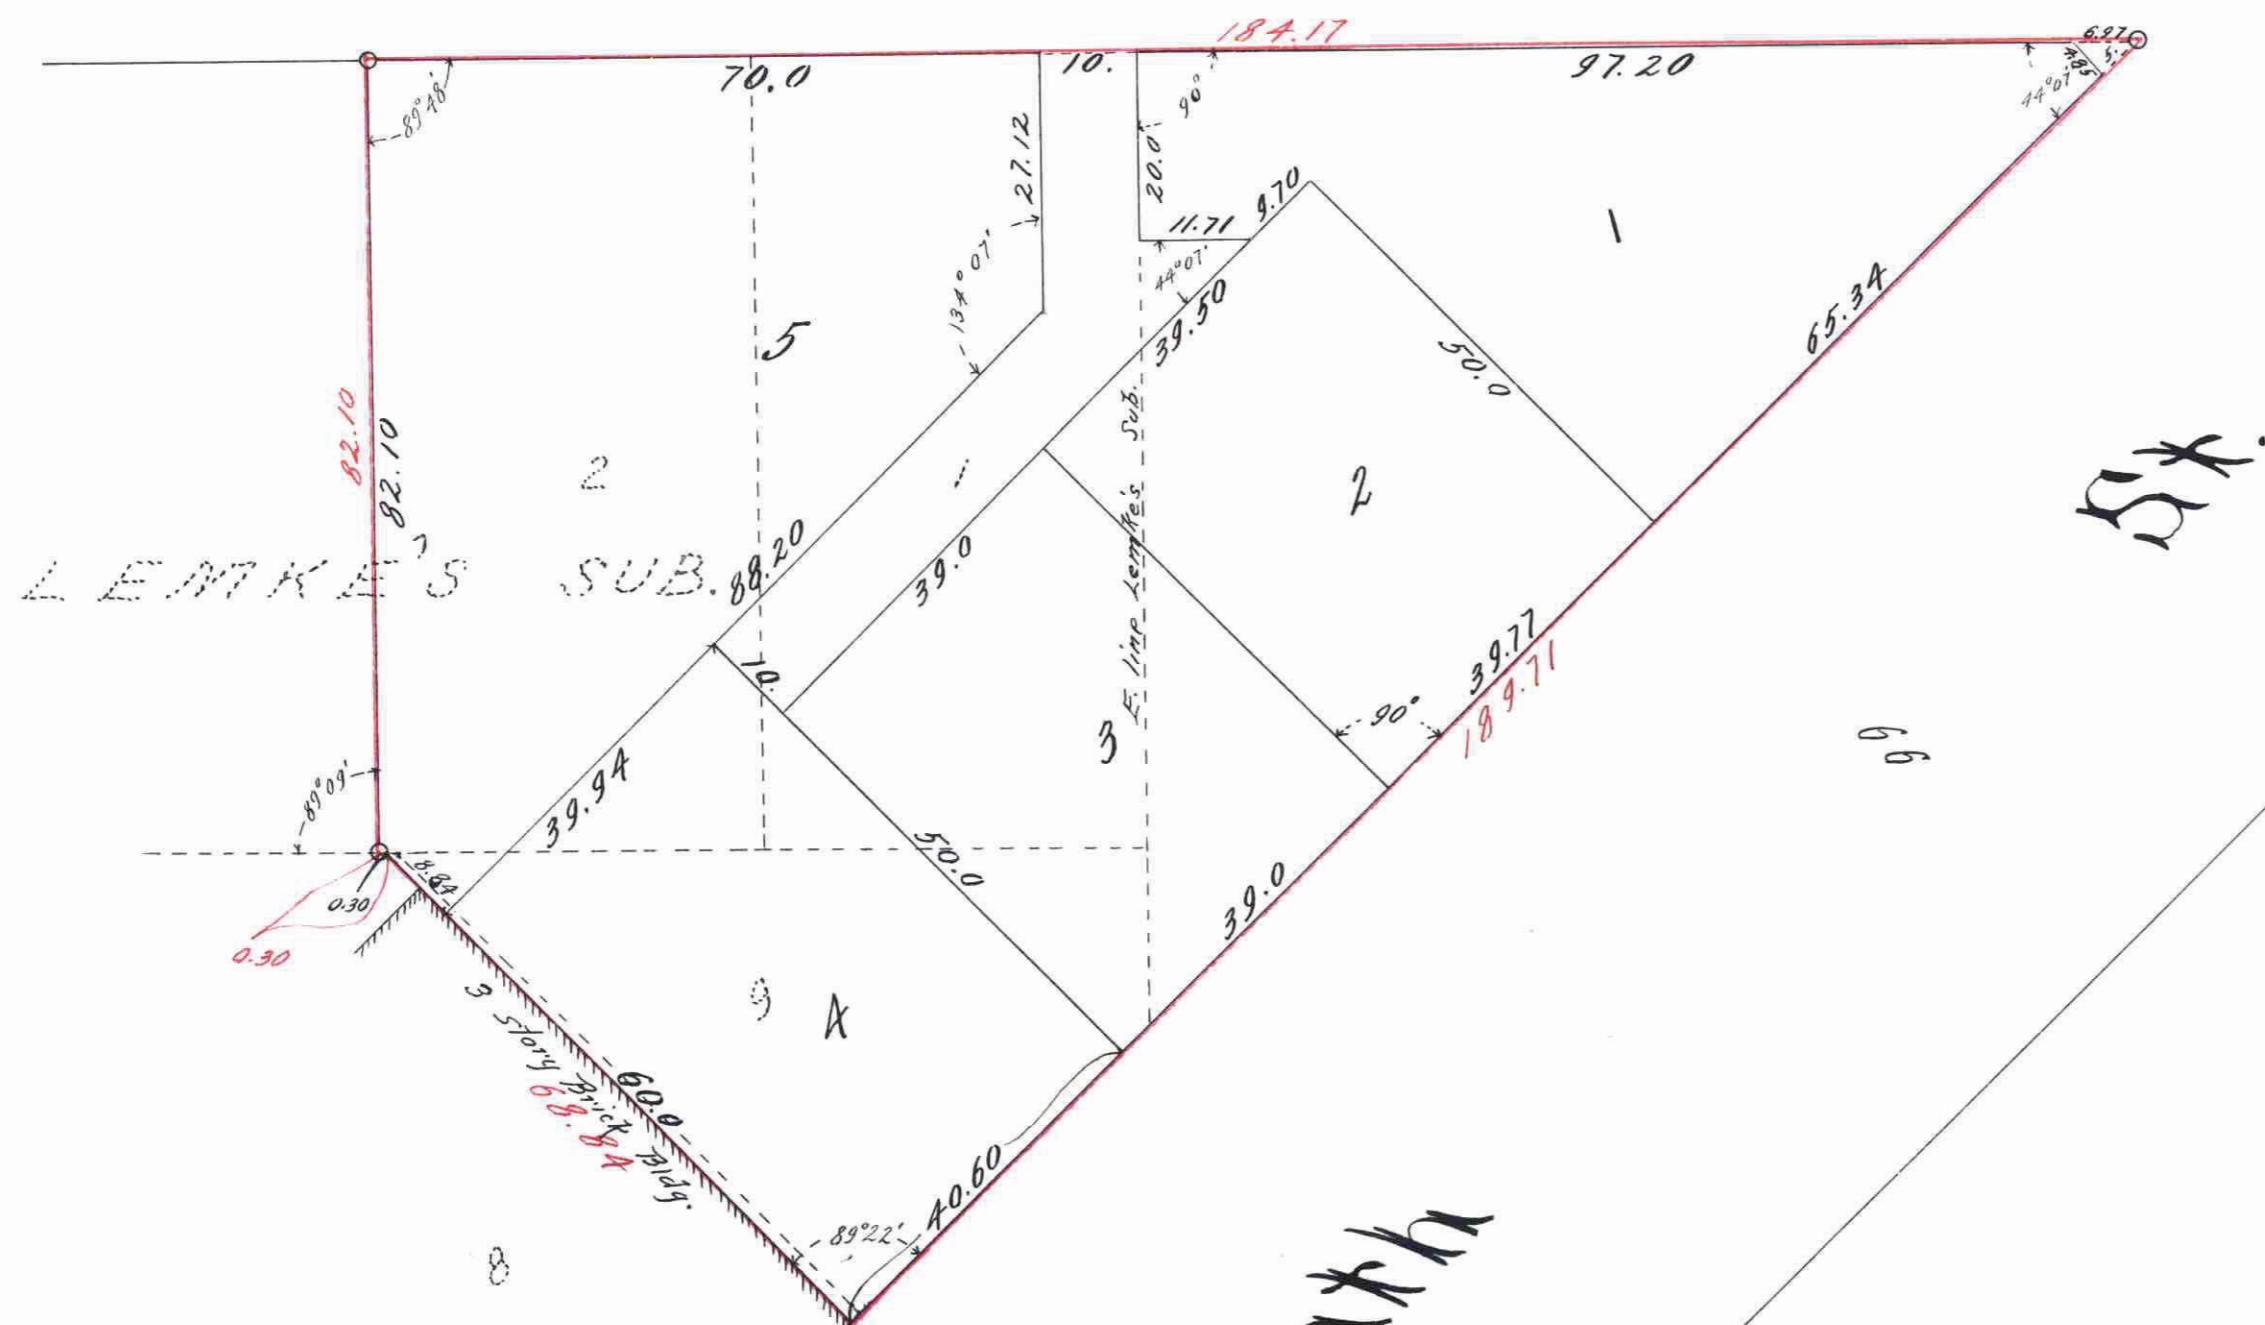


SKARDA'S SUBDIVISION

Jens Pedersen, Surveyor

533950

o indicates iron
Scale 20 Feet per inch.

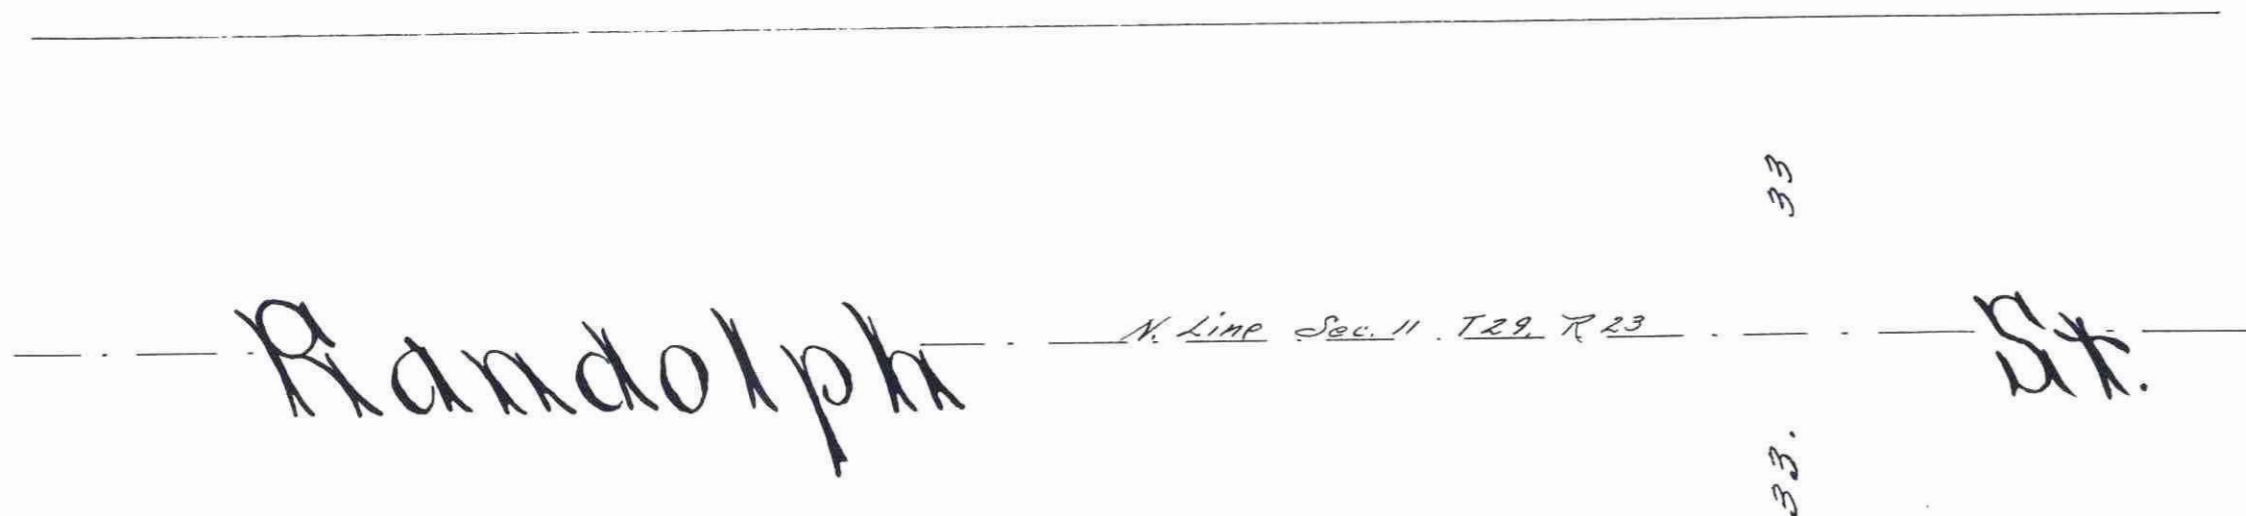

Mr. Seventh

I, hereby certify to having surveyed and platted the property described on this map as, Skarda's Subdivision, and have placed irons at the corners as shown on this map, and the same is correct.

Jens Pedersen
Surveyor.

State of Minnesota } On this 14th day
County of Ramsey } of March A.D. 1918,
personally appeared before the undersigned
Jens Pedersen, to me well known, and
acknowledged that he executed the fore-
going certificate as his own free act and deed.

W. Moore
Notary Public,
Ramsey Co., Minn.

My Commission expires Oct 24 1919.

This is to certify that John Skarda and Antonia Skarda his wife, proprietors of all that part of the North half of Northeast quarter of Northeast quarter of Section eleven, Township twenty eight, Range twenty three, (Sec. 11, T. 28, R. 23), Lots one (1) two (2) nine (9) and part of Lot eight (8), Lemkes Subdivision, according to the recorded plat thereof on file and of record in the office of the Register of deeds, in and for the County of Ramsey, described as follows to wit, (Commencing at the intersection of the south line of Randolph St and the northerly line of W. 

Witness our hands and seals this 14th day of March 1918
In presence of

James W. Jordan
W. Moore

John Skarda
Antonia Skarda

State of Minnesota } On this 14th day of March A.D. 1918, personally
County of Ramsey } came before me the undersigned, John Skarda and Antonia Skarda, his wife,
to me well known, and they acknowledged that they executed the foregoing
certificate as their own free act and deed.

W. Moore
Notary Public, Ramsey Co., Minn.
My Commission expires, Oct 24 1919.

Accepted and approved this 20th day of March A.D. 1918.

Charles E. Brown
James W. Jordan
W. Moore
Commissioners
Commissioner of Public Works.

Accepted by the Council March 21-1918
Approved, March 21-1918

John W. Brown
City Clerk.

TAXES PAID
AND TRANSFER ENTERED

JUN 20 1918
GEO. J. BRES. COUNTY AUDITOR
R. R. R. Deputy

Taxes for the year of 1917 on the
lands described within PAID
JUN 20 1918
Martin J. ... Treasurer
C. ...

All Installments of Assessments due on
the within property to date are paid
JUN 20 1918
DEPARTMENT OF FINANCE
S. A. ...
C. ...

STATE OF MINNESOTA
County of Ramsey, ss:
Office of the Register of Deeds.
This is to certify that the within instrument
was filed for record in my office at St. Paul,
on the 20 day of June
A. D. 1918, at 4:00 P.M., and that the
same was recorded in Book 36
of Long Plat, Page 17.
W. Moore
Register of Deeds.

This plat document
is an UNOFFICIAL
copy of a
Subdivision Plat or
Registered Land Survey
and is made available for
information purposes only.
To obtain an official copy
please contact the Ramsey
County Recorder's Office.

533950