44

HORNSBY'S REARRANGEMENT OF THE WEST HALF OF BLOCK 101 OF WEST SAINT PAUL PROPER

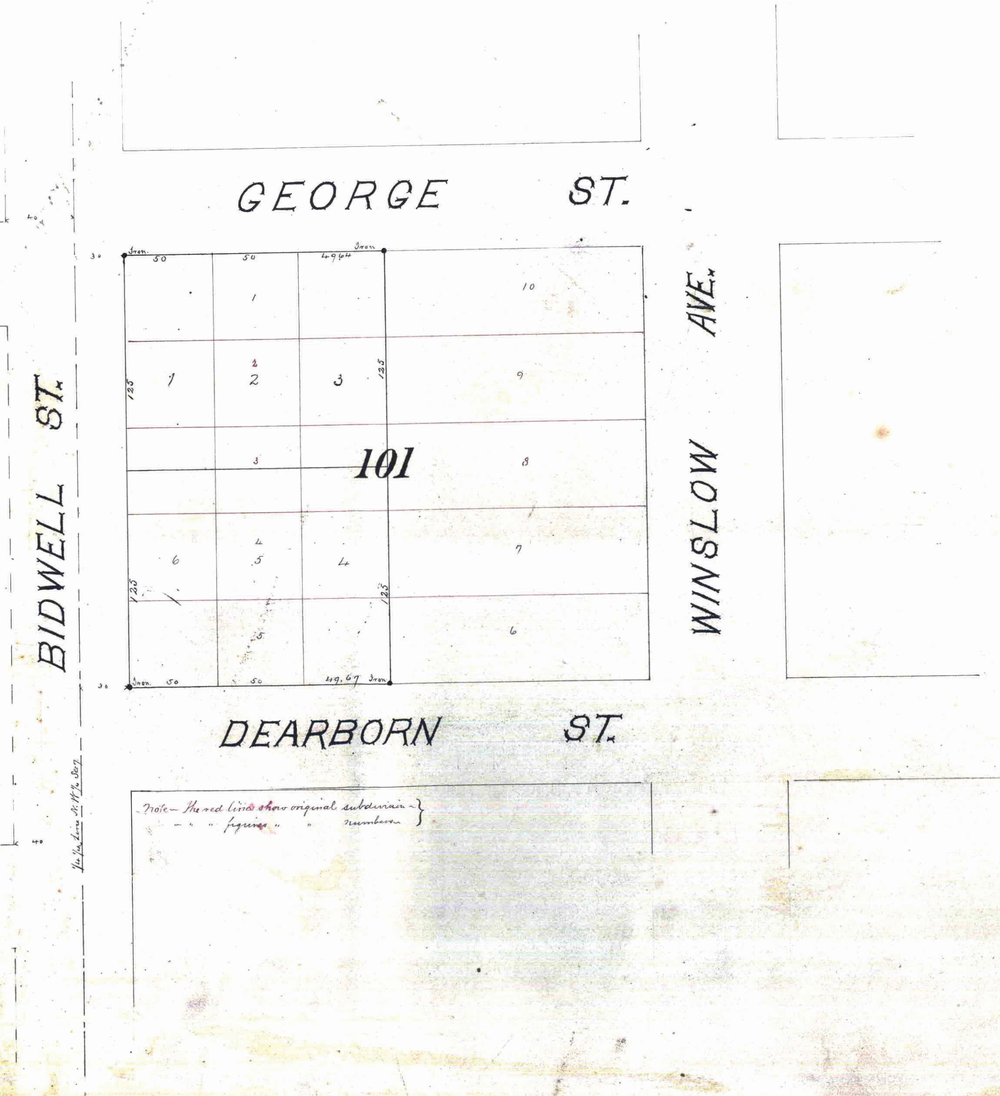

Note — The red lines show original subdivision
" " " figures " " numbers

This plat document is an UNOFFICIAL copy of a Subdivision Plat or Registered Land Survey and is made available for information purposes only.

To obtain an official copy please contact the Ramsey County Recorder's Office.

RAMSEY COUNTY

STATE OF MINNESOTA, } SS.
County of Ramsey.
OFFICE OF THE REGISTER OF DEEDS.
This is to certify that the within instrument was filed for Record in this office, at St. Paul, on the 14th day of April A. D. 1885 at 4 35 o'clock P. M., and that the same was duly recorded in Book W of Plats pages 44
R. C. Wiley
Register of Deeds.
By _____ Deputy.

I certify that I have surveyed and platted the West half of Block 101 of West Saint Paul Proper as Hornsby's Rearrangement of the West half of Block 101 of West Saint Paul Proper, and have placed Iron monuments at the corners as shown on this plat, that this is a correct plat of said survey.
J. B. Hawley Surveyor

State of Minnesota } s.s.
County of Ramsey }
On the 23rd day of December 1884 personally appeared before me J. B. Hawley to me well known to be the identical person who surveyed the above described piece of land and executed the above certificate, and acknowledged said certificate to be correct and his free act and deed.
J. B. Olivier
Notary Public Ramsey County, Minnesota

I Benjiman A. Pomeroy the owner of the West half of Block 101 of West Saint Paul Proper hereby certify that I have caused the same to be surveyed and platted as Hornsby's Rearrangement of the West half of Block 101 of West Saint Paul Proper as hereon indicated.
In witness whereof I have placed my hand and seal on the 23 day of December 1884.
Benjn. A. Pomeroy (seal)
In the presence of
A. H. Hornsby
J. B. Olivier

State of Minnesota } s.s.
County of Ramsey }
On the 23rd day of December 1884 personally appeared before me Benjiman A. Pomeroy to me well known to be the identical person who executed the above certificate and acknowledged the same to be his free act and deed.
J. B. Olivier
Notary Public Ramsey County, Minnesota

Approved by the Plat Commission on the 23rd day of Dec. 1884.
S. P. Folsom
James Starkey
Wm A Van Slyke } Plat Commission

Examined and Approved on the 24th day of December, 1884.
W. H. Lamon
City Engineer City of Saint Paul

Accepted by the Common Council on the 17 day of March 1885
[illegible] City Clerk City of Saint Paul

St Paul Minnesota }
1884 }
Taxes paid and transfers Entered April 14th 1885
James O'Brien
County Auditor Ramsey County.
Pugsley

CITY TREASURER'S OFFICE
ST. PAUL, MINN.
APR 14 1885
ASSESSMENTS PAID by Sale
George Reis
CITY TREAS.
Nichols