


# H. H. CHAPMAN'S LAKE OWASSO BEACH.

JOHN BIRVINE, SURVEYOR.

AUGUST 1919.

Scale 100 ft per inch.

O INDICATES IRONS

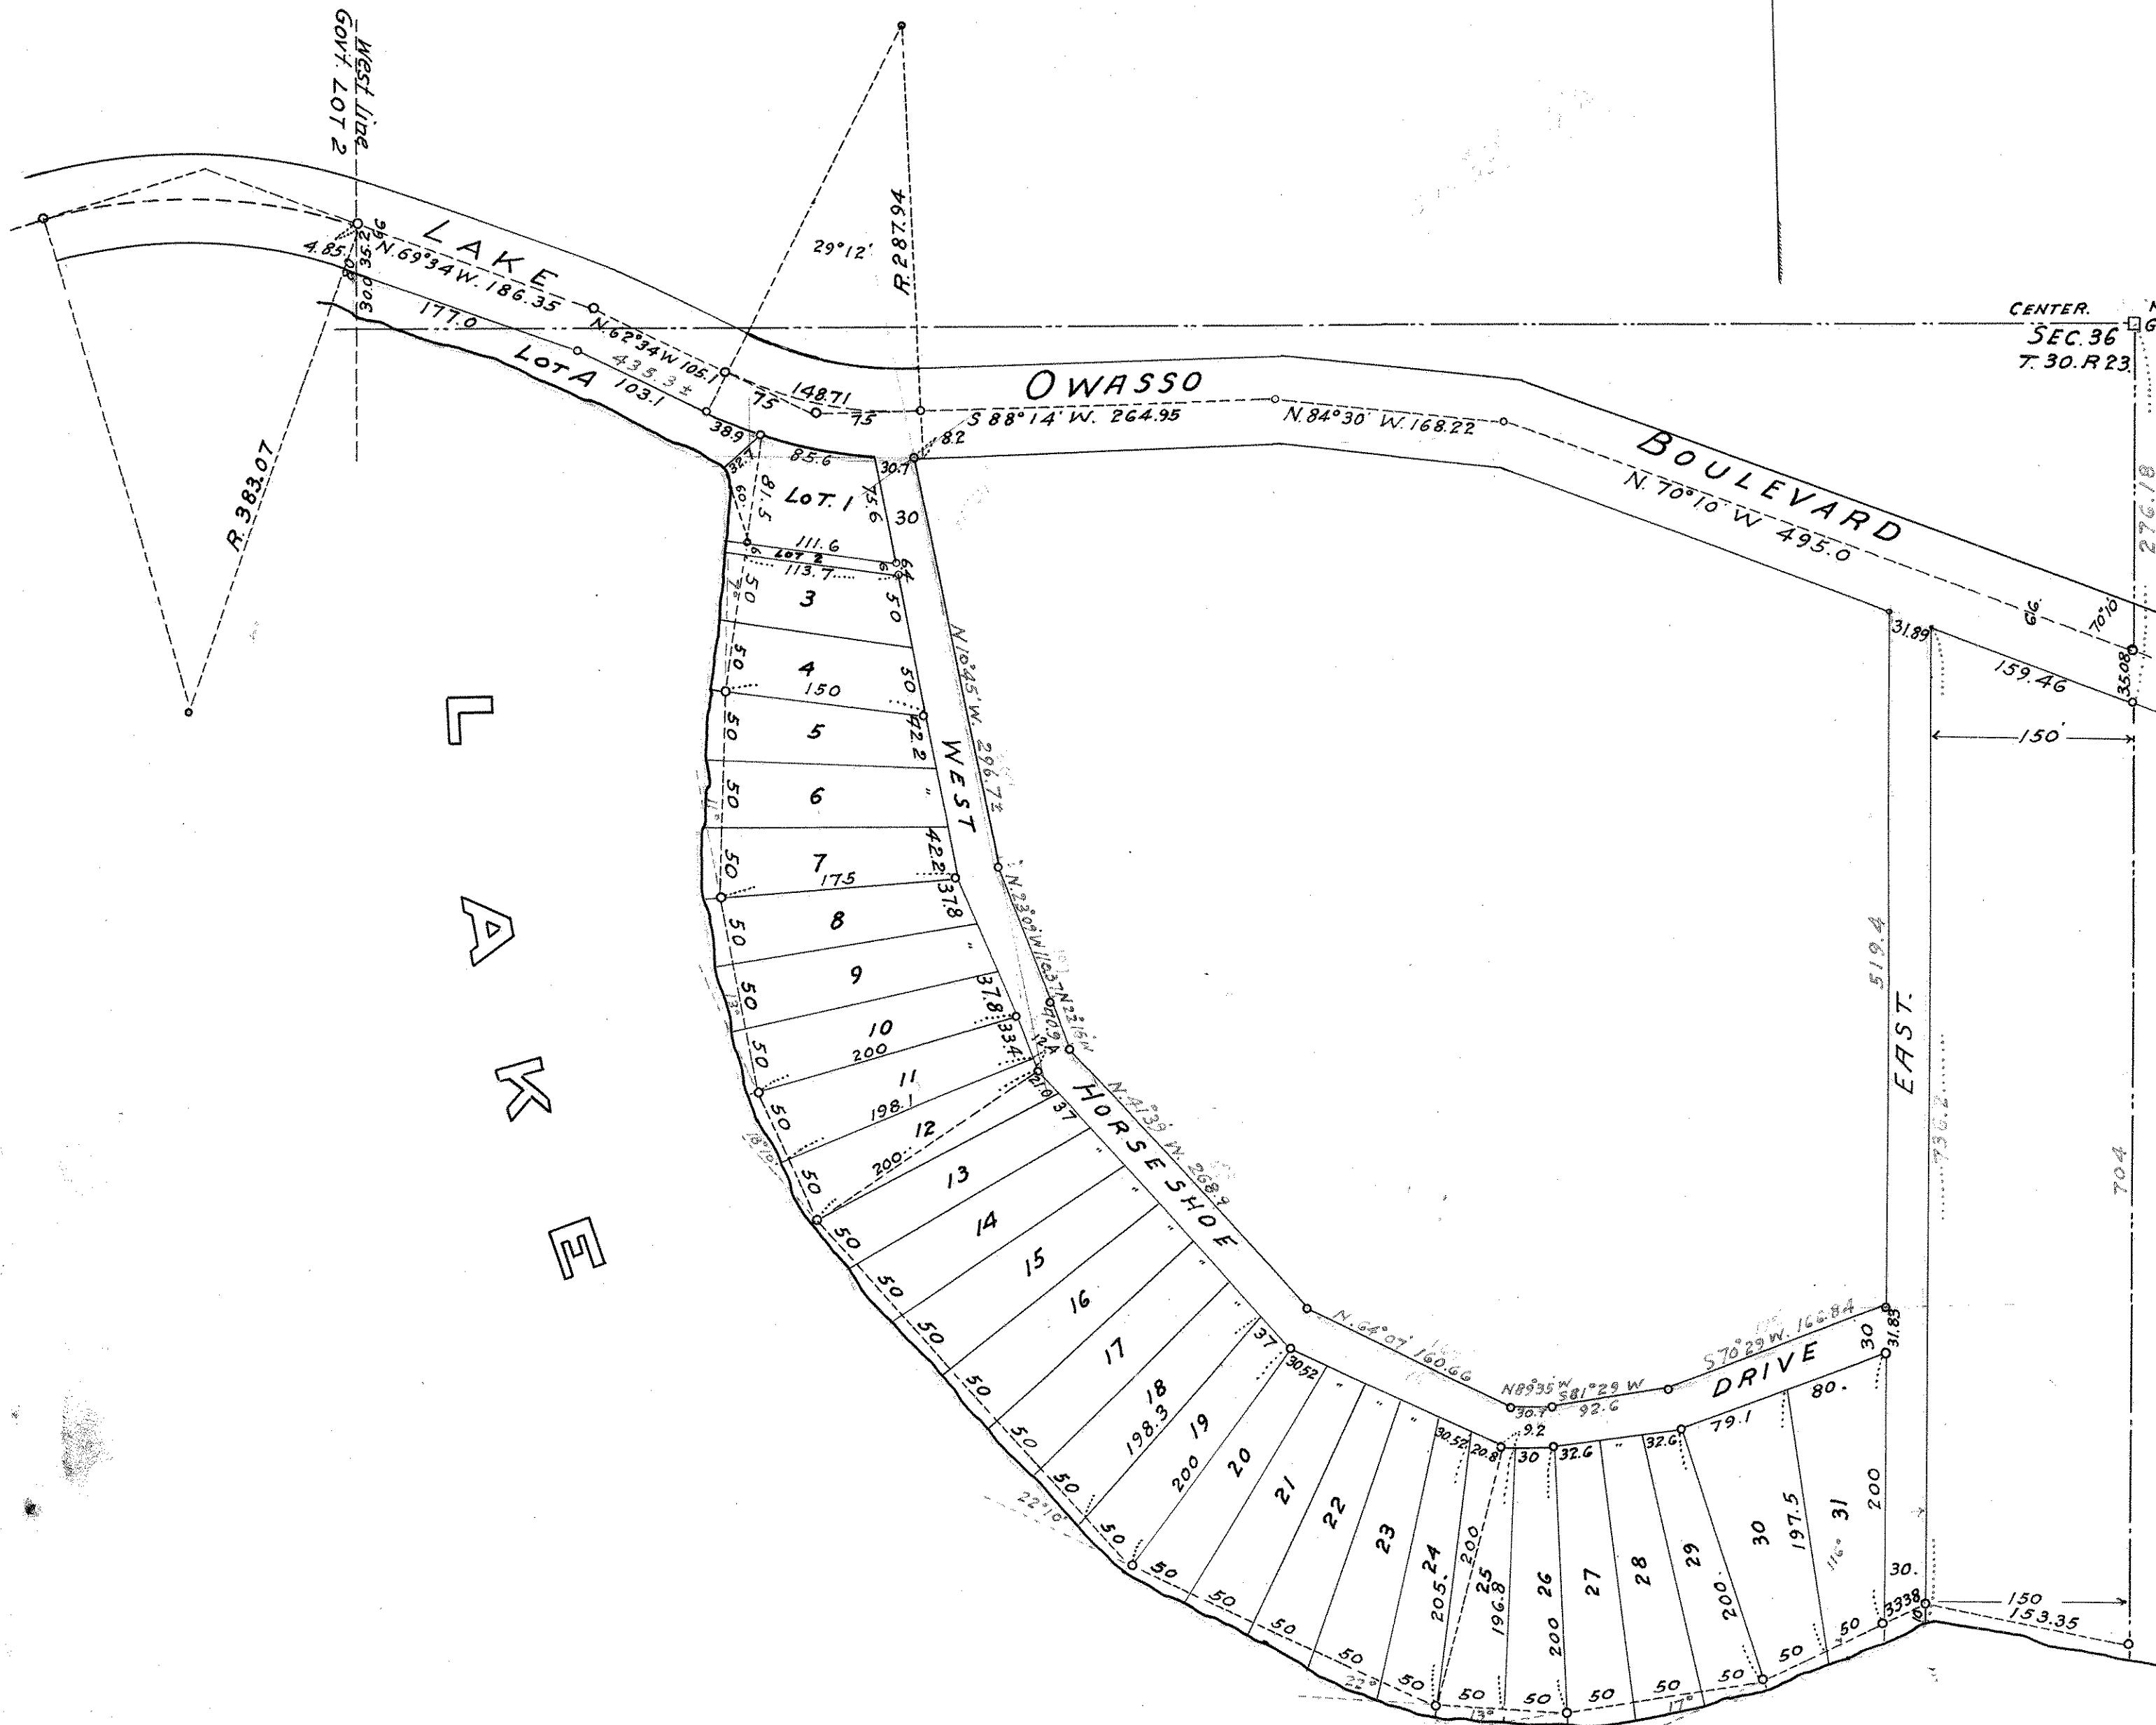

I hereby certify to having surveyed and blotted the property described on this map as H.H. Chapman's Lake Owasso Beach and have placed iron monuments at the places designated on this map and the same is correct.

John B. Birvine, Surveyor.

State of Minnesota On this 11<sup>th</sup> day of December A.D. 1919 personally County of Ramsey I came before me the undersigned John B. Birvine to me well known and acknowledged that he executed the foregoing certificate as his own free act and deed.

J. H. O'Dell

Notary Public.

My Commission Expires Oct. 1st 1921 Ramsey County, Minnesota.

This is to certify that Harry H. Chapman and Mary Chapman his wife owners of the following described property to wit: Commencing at the northeast corner at Government lot two, Section thirty six, Township thirty Range twenty-three, thence south on the east line of said lot two 276.8 feet thence north 70° 10' west 159.46 feet to point of beginning, thence north 70° 10' west 31.89 feet, thence south parallel to and 180 feet west of the east line of said lot two 519.4 feet thence south 70° 29' west 166.84 feet, thence south 81° 29' west 92.6 feet thence north 89° 35' west 30.1 feet, thence north 64° 57' west 160.66 feet, thence north 41° 39' west 268.9 feet, thence north 22° 15' west 40.9 feet, thence north 23° 09' west 110.37 feet, thence north 10° 45' west 296.7 feet more or less to the south line of Lake Owasso Boulevard, thence along the south line of said boulevard 435.3 feet more or less to the west line of said lot two, thence south on the west line of said lot two to the shore of Lake Owasso, thence south easterly along the shore of Lake Owasso to a point 150 feet west of the east line of said lot two, thence north and parallel with the east line of said lot two 736.2 feet more or less to point of beginning, have caused the same to be surveyed and blotted and hereafter known as Harry H. Chapman's Lake Owasso Beach as shown by this plat and hereby dedicate to the public, for public use forever all the streets, avenues, alleys, drives or boulevards as herein indicated. Witness my hands and seals this 16<sup>th</sup> day of December A.D. 1919

In presence of

{ H. H. Chapman  
Mary Chapman

State of Minnesota On this 16<sup>th</sup> day of December A.D. 1919 personally appeared before me the undersigned Harry H. Chapman and Mary Chapman his wife to me well known and acknowledged that they executed the foregoing certificate as their own free act and deed.

Notary Public  
Ramsey County, Minnesota.

Accepted and approved this day of A.D. 19  
Charles H. Bronson } Plat Commission  
Commissioner of Public Works

Accepted and approved by the Board of County Commissioners for the County of Ramsey, State of Minnesota on this 18<sup>th</sup> day of April A.D. 1921.

Geo. J. Rice

County Auditor.

Recorded April 27, 1921

Spec #1911 FOR CORRECTED PLAT AUG 10, 1925  
FILED

Torrens #45892