


# WHEELER'S COMO HEIGHTS RE.

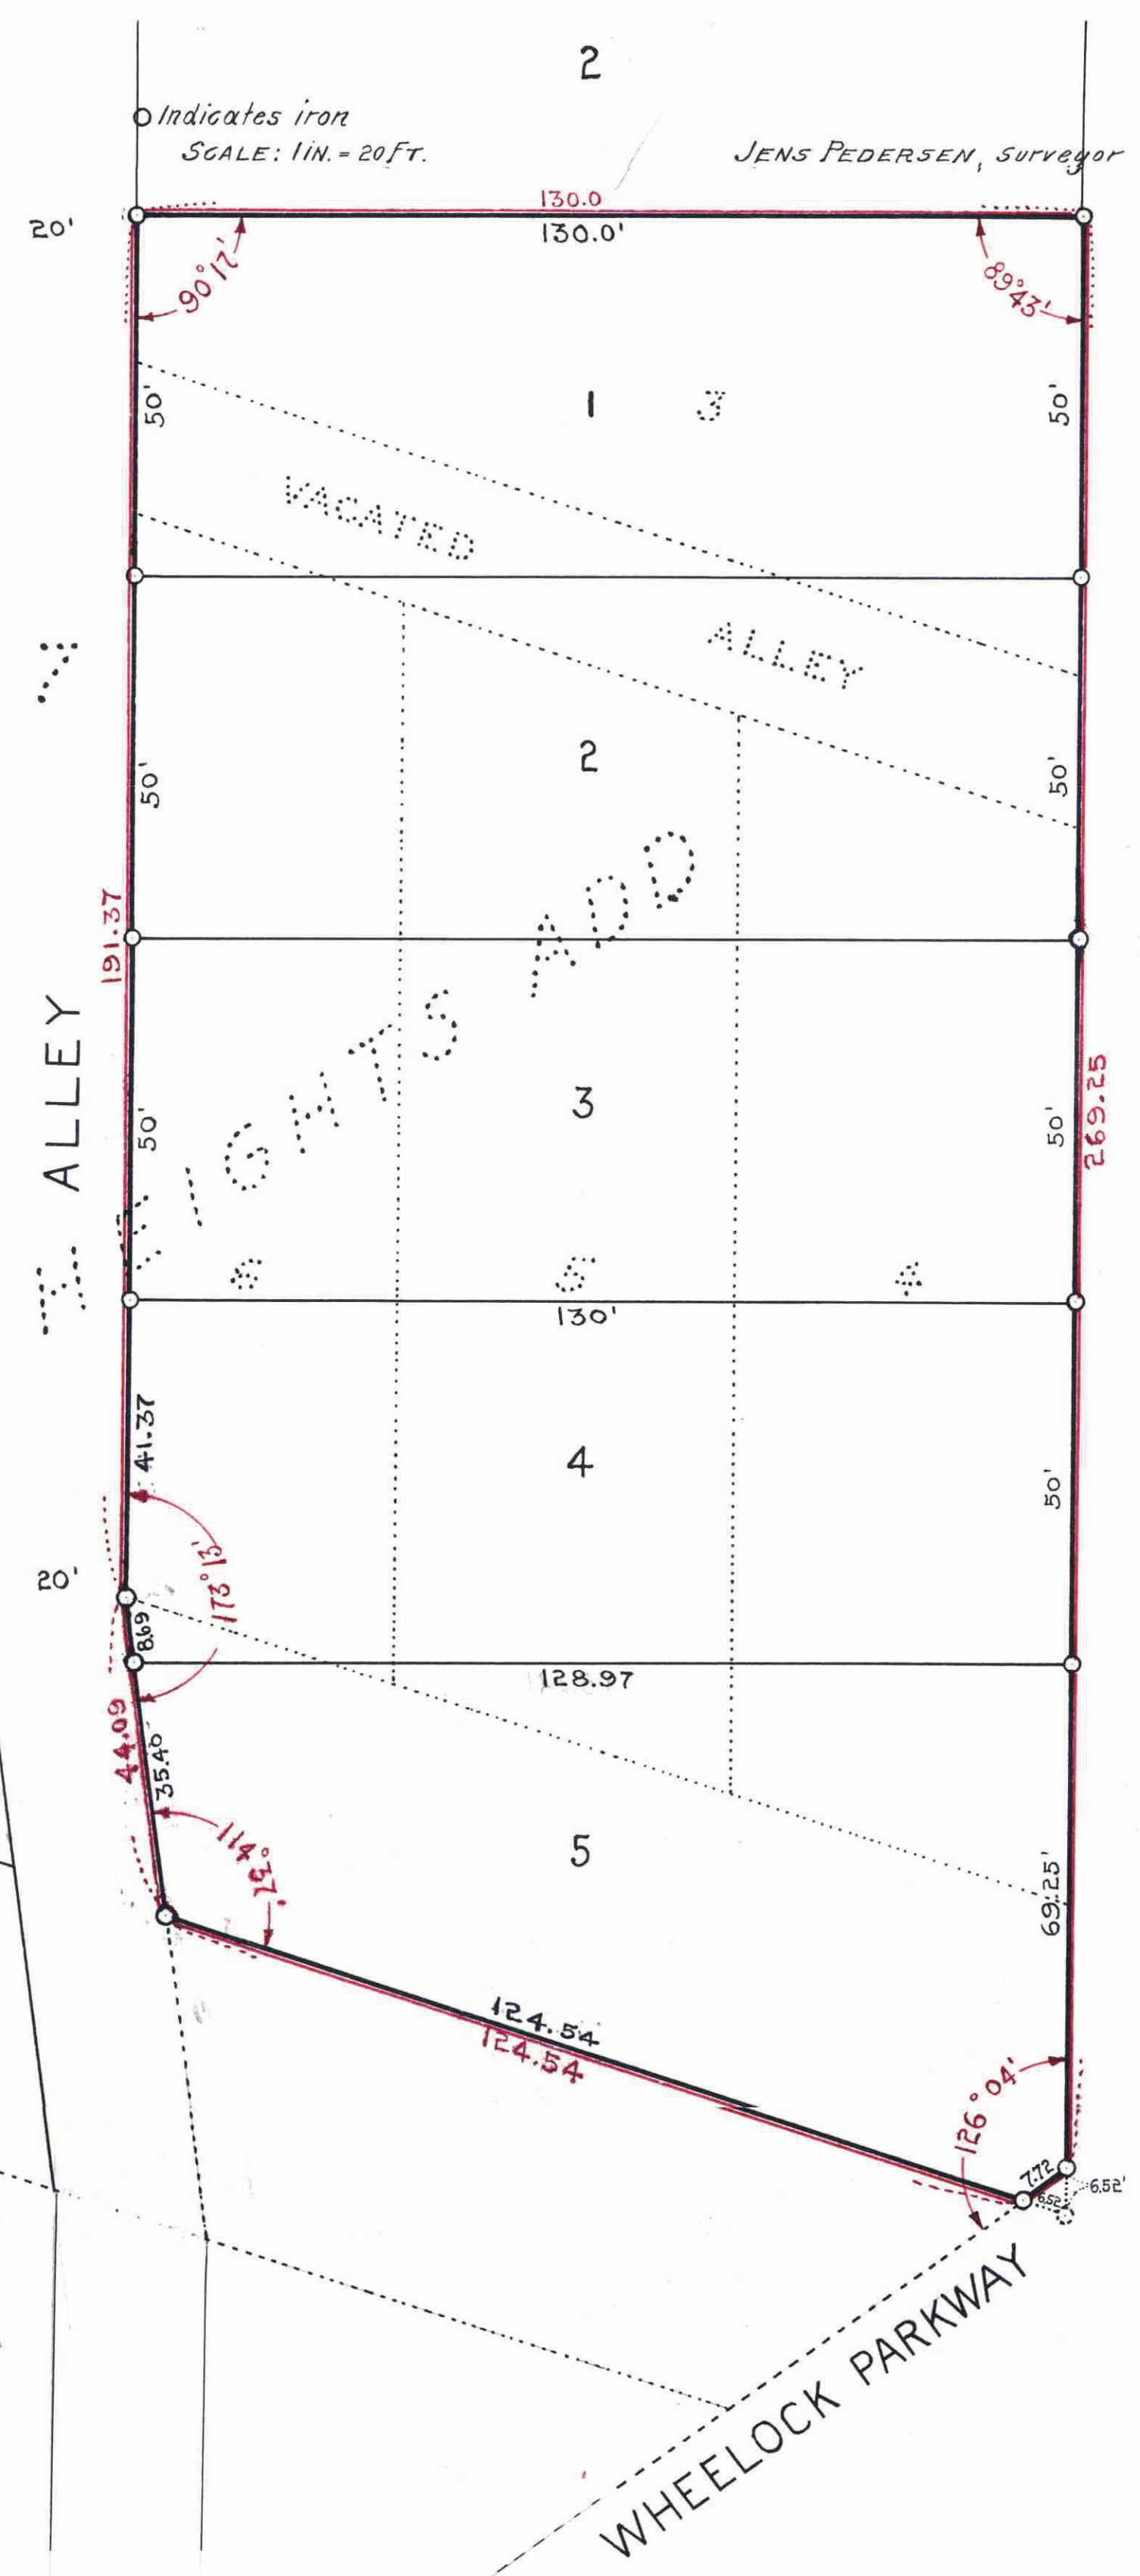

ROLAND ST.

I hereby certify to having surveyed and platted the property described on this map as: WHEELER'S COMO HEIGHTS RE. and have placed irons at the corners as hereon indicated and the same is correct.

*Jens Pedersen*  
surveyor

STATE OF MINNESOTA } On this 2<sup>nd</sup> day of  
COUNTY OF RAMSEY } August A.D. 1922

personally appeared before the undersigned JENS PEDERSEN, to me well known and acknowledged that he executed the foregoing certificate as his own free act and deed.

*F. L. Brown*  
NOTARY PUBLIC, RAMSEY CO., MINN.  
My commission expires 5/11/1923

and Osage Street and Alley vacated

This is to certify that RUSH B. WHEELER and HARRIET S. WHEELER, his wife proprietors of Lots Three (3) Four (4) Five (5) and SIX (6) of BLK. 7 of COMO HEIGHTS ADD. have caused the same to be surveyed and platted and hereafter known as WHEELER'S COMO HEIGHTS RE. as shown by this plat and hereby dedicates to the public and for public use forever all the streets, avenues and alleys as herein indicated.

Witness my hand and seal this 2<sup>nd</sup> day of August 1922

In presence of  
*J. M. Peterson*  
*Victor C. Knapp*

*Rush B. Wheeler*  
*Harriet S. Wheeler*

STATE OF MINNESOTA } On this 2<sup>nd</sup> day of August A.D. 1922 personally came before me the undersigned RUSH B. WHEELER and HARRIET S. WHEELER his wife to me well known and they acknowledged that they executed the foregoing certificate as their own free act and deed.

616316

*J. M. Peterson*  
NOTARY PUBLIC, RAMSEY CO., MINN.  
My commission expires June 12, 1928

STATE OF MINNESOTA }  
County of Ramsey, SS:  
I, \_\_\_\_\_, Clerk of the Register of Deeds, do hereby certify that the within instrument was filed for record in this office at St. Paul, on the 2<sup>nd</sup> day of August A. D. 1922, at 2:20 P. M., and that the same was duly recorded in Book \_\_\_\_\_ of \_\_\_\_\_ Pages \_\_\_\_\_

*J. J. Jorgensen*  
Register of Deeds  
Deputy

Accepted and approved this 21<sup>st</sup> day of August A.D. 1922

*George H. Koenig*  
*Charles H. Benson* } PLAT COMMISSIONERS  
*James Jordan*

*W. J. Pita* COMMISSIONER OF PUBLIC WORKS

Accepted by the COUNCIL Aug 26<sup>th</sup> - 1922  
Approved Aug 26<sup>th</sup> - 1922

*Henry Wilson*  
CITY CLERK

This plat document is an UNOFFICIAL copy of a Subdivision Plat or Registered Land Survey and is made available for information purposes only.

To obtain an official copy please contact the Ramsey County Recorder's Office.

RAMSEY COUNTY

All installments of Assessments due on the within property to date are paid

AUG 25 1922  
DEPARTMENT OF FINANCE  
ST. PAUL, MINN.  
JAMES W. CUNY, COM'Y. FINANCE.  
*W. J. Pita*

Taxes for the year 1922  
AUG 25 1922  
KEYES, DRUSE & CO.  
*J. M. Peterson*

616316