


FOOSHE ADD.

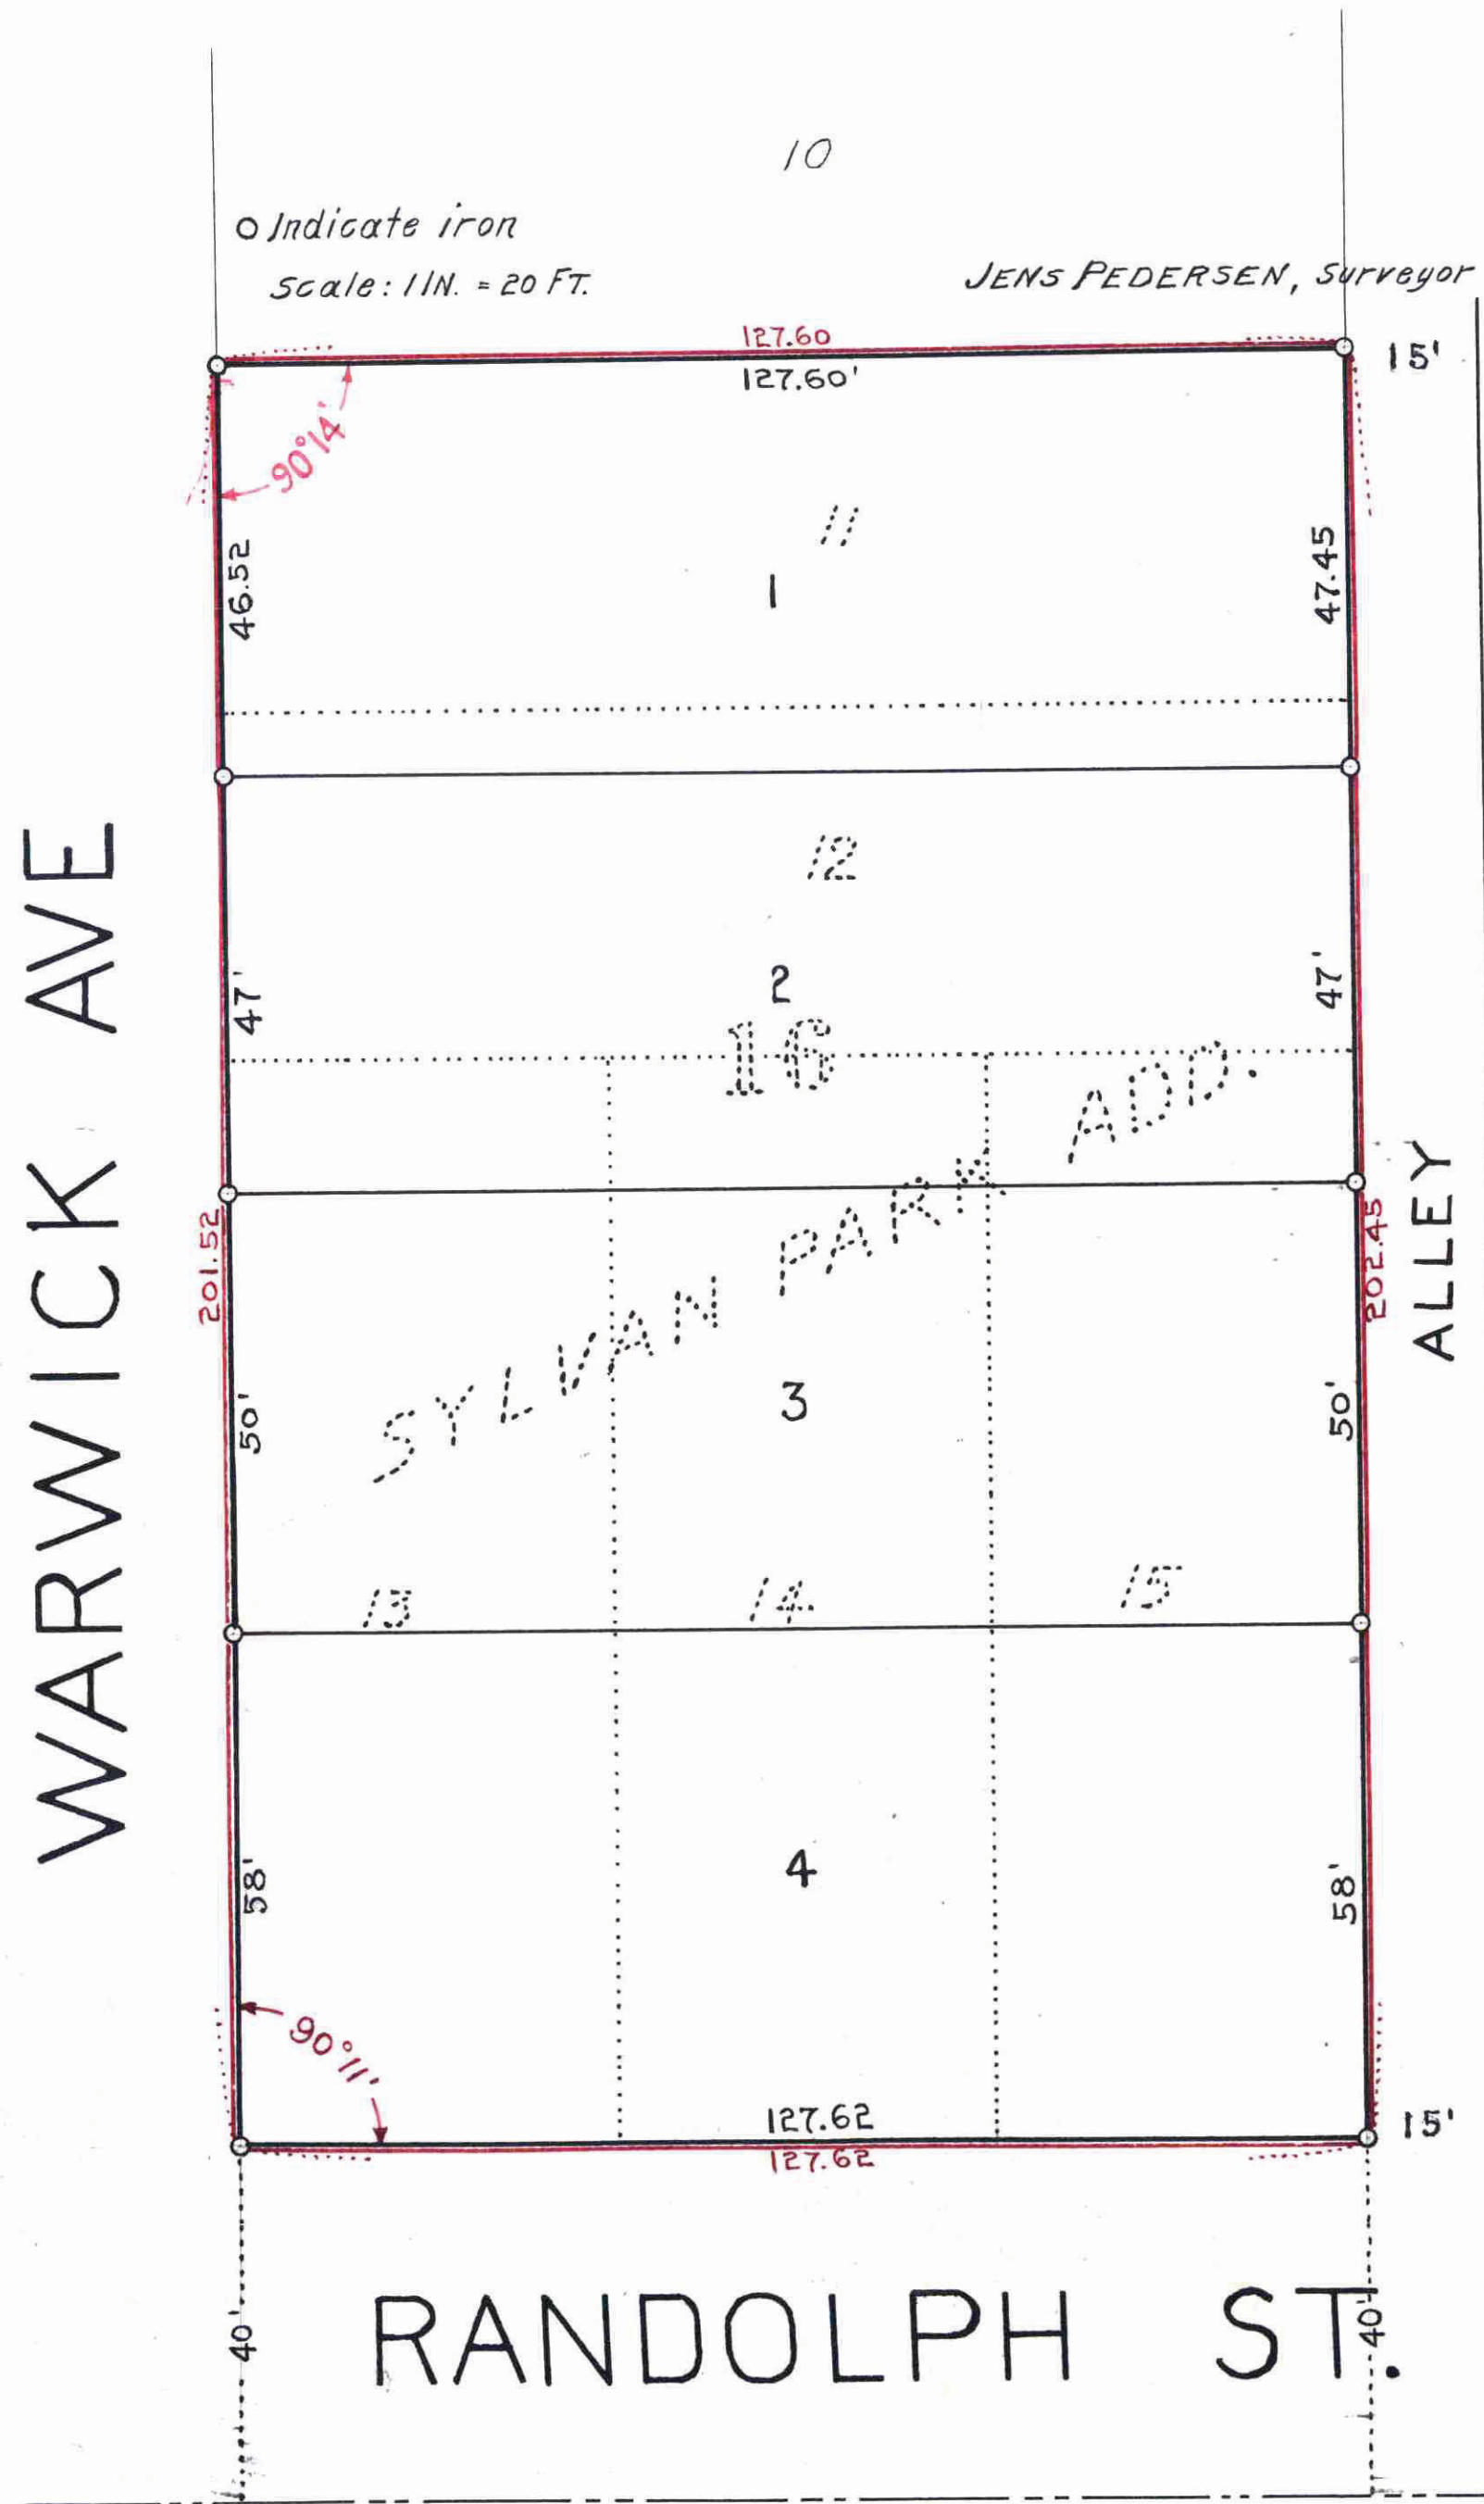

This plat document is an UNOFFICIAL copy of a Subdivision Plat or Registered Land Survey and is made available for information purposes only.

To obtain an official copy please contact the Ramsey County Recorder's Office.



All instalments of Assessments due on the within property to date are paid

AUG 28 1922

DEPARTMENT OF FINANCE

JAMES H. CLANCY, COUNTY CLERK

Taxes for the year of 1922 have been paid

AUG 29 1922

KEELY'S CHECK TR.

Jimmereham

TAXES PAID AND TRANSFER DUTIES

AUG 31 1922

GEO. J. REED, Co. Auditor

I hereby certify to having surveyed and platted the property described on this map as: Fooshe Add. and have placed irons at the corners as hereon indicated and the same is correct.

Jens Pedersen
Surveyor

State of Minnesota } on this 9th day of August, A.D. 1922
County of Ramsey }
personally appeared before me the undersigned, Jens Pedersen, to me well known and acknowledged that he executed the foregoing certificate as his own free act and deed.

F. L. Brown
Notary Public, Ramsey Co. Minn.
My commission expires 5/11/1923.

This is to certify that Peter G. Fooshe and Catharine Fooshe his wife and Allen McMillan (single) proprietors of lots eleven (11) twelve (12) thirteen (13) fourteen (14) and fifteen (15) of Block 16 of Sylvan Park Add. have caused the same to be surveyed and platted and hereafter known as Fooshe Add. as shown by this plat and hereby dedicate to the public, and for public use forever, all the streets, avenues and alleys as herein indicated.

Witness my hand and seal this 8th day of August, 1922.

In presence of:
H. W. Kramberg
Henry H. Sandberg

Catharine Fooshe
Peter G. Fooshe
Allen McMillan
Oscar Sandell

State of Minnesota } on this 8th day of August, A.D. 1922
County of Ramsey }
personally came before me the undersigned Peter G. Fooshe and Catharine Fooshe his wife and Allen McMillan, single, Oscar Sandell, Mortgagee to me well known, and they acknowledged that they executed the foregoing certificate as their own free act and deed.

Henry H. Sandberg
Notary Public, Ramsey Co. Minn.
My commission expires August 23rd, 1923.

Accepted and approved this 21st day of August, A.D. 1922

Charles H. Branson } Stat Commissioners
James D. Jordan }
W. J. P. Shea } Commissioner of public works

Accepted by the Council August 28th 1922
Approved August 28th 1922
Henry Brown
City Clerk.

INSTRUMENT NUMBER 54869

CERTIFICATE NUMBER 123322-3

BOOK 41 PAGE 111-112

STATE OF MINNESOTA

OFFICE OF THE REGISTRAR OF TITLES

THIS IS TO CERTIFY THAT THE WITHIN INSTRUMENT WAS FILED IN THIS OFFICE AT ST. PAUL, ON THE 28th DAY OF AUGUST, A. D. 1922

W. J. P. Shea
Deputy

54869