


24
610460

EDFORD PLAT No 1.

SCALE, ONE INCH = 100 FEET.

O INDICATES IRON MONUMENT.

CHAS. MURRAY, SURVEYOR.

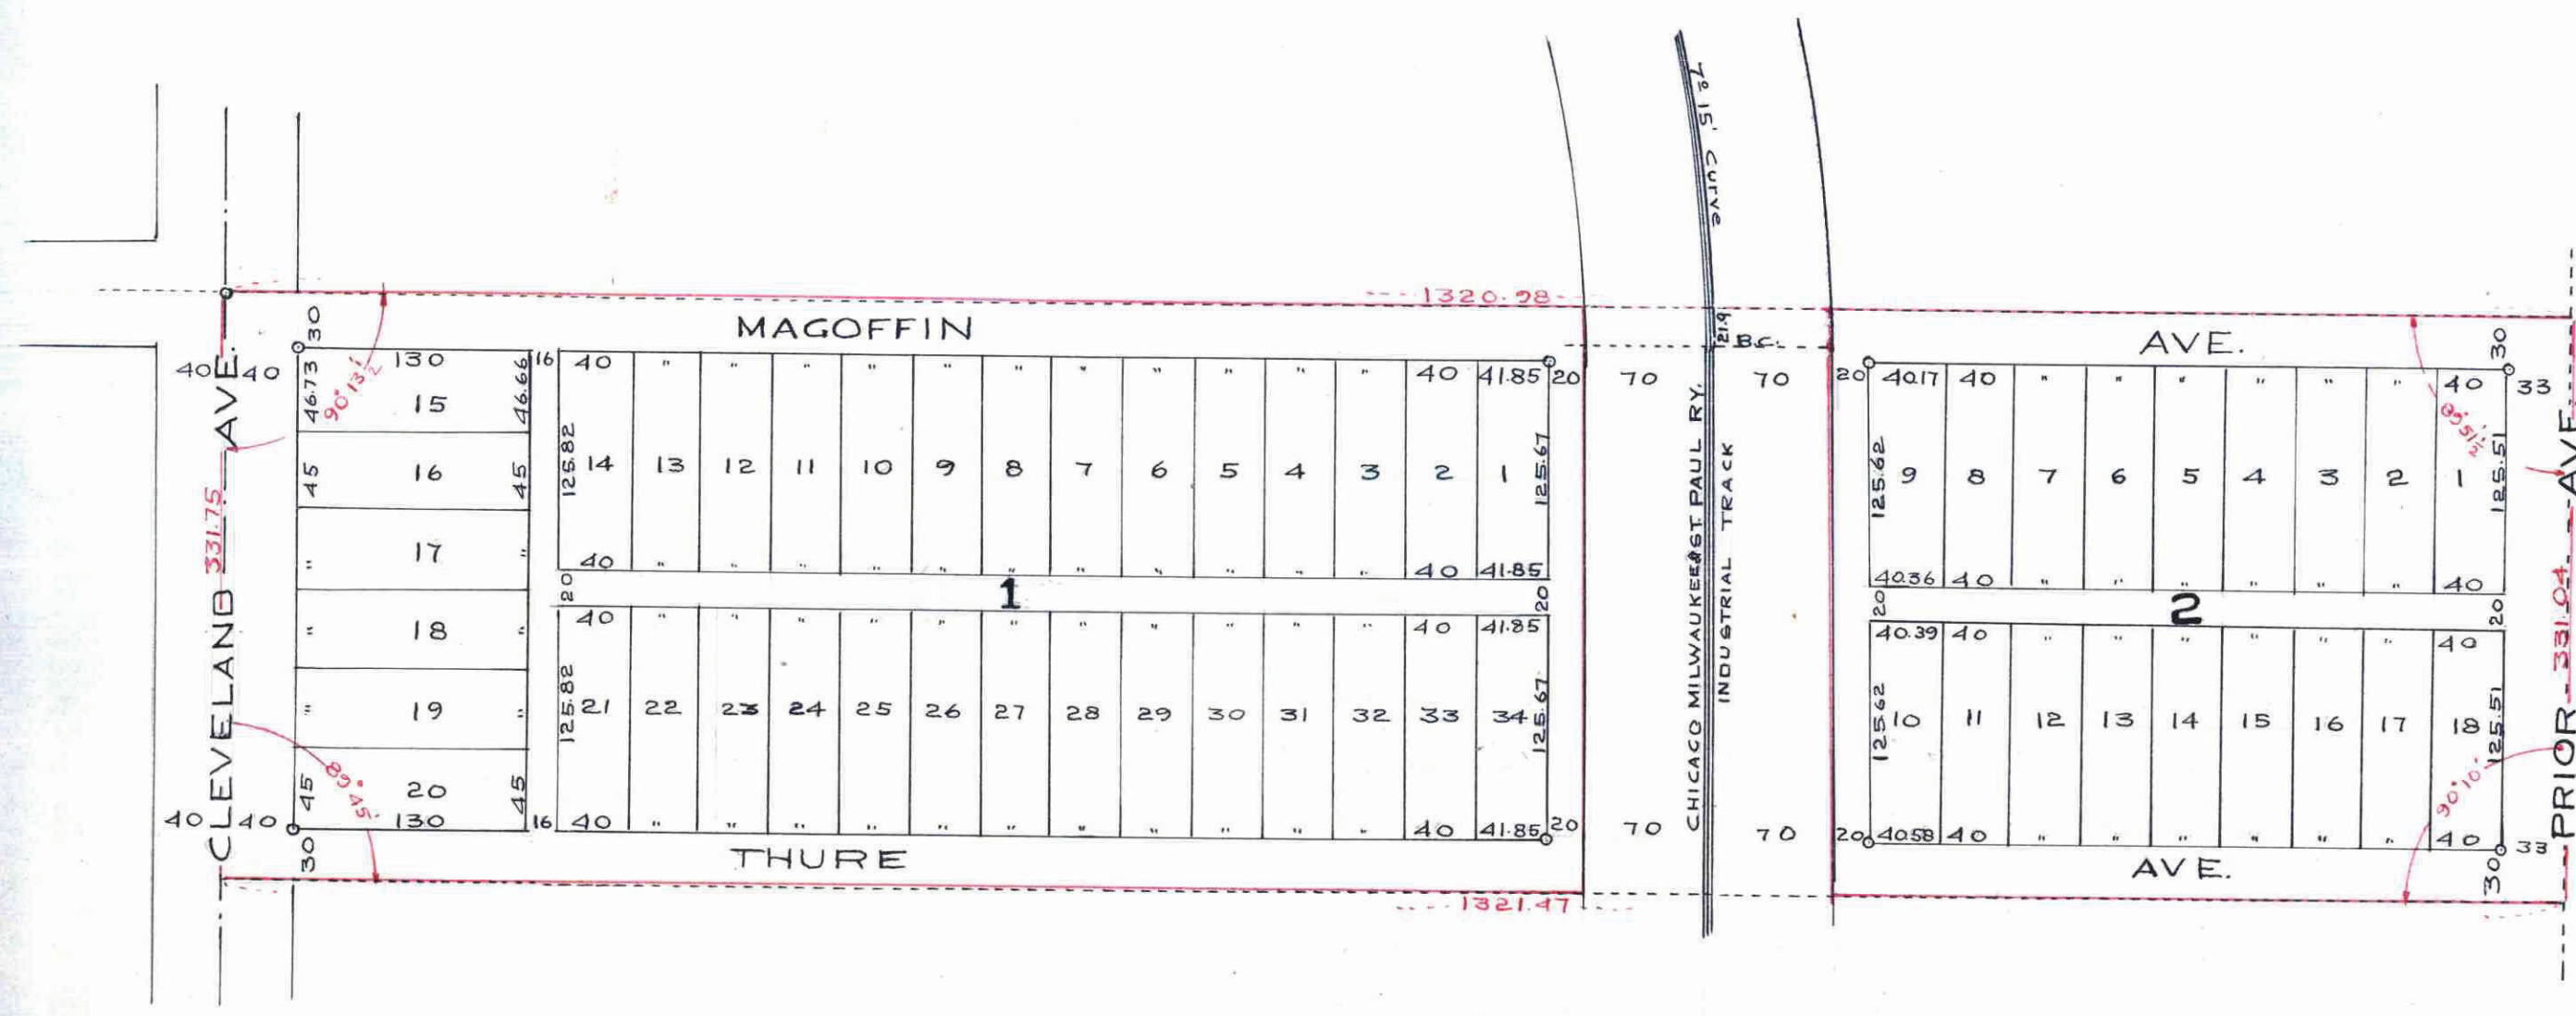

STATE OF MINNESOTA
County of Ramsey
Office of the Register of Deeds
This is to certify that the within instrument
was filed for record in this office at St. Paul
on the 31st day of July
A. D. 1923, at 2:00 o'clock P. M. and that the
same was duly recorded in Book 40
of Survey & Plat Pages 14
By J. W. Mueller
Register of Deeds.
Deputy

This plat document is an UNOFFICIAL copy of a Subdivision Plat or Registered Land Survey and is made available for information purposes only.

To obtain an official copy please contact the Ramsey County Recorder's Office.

Whereby Certify to having surveyed and platted the property described on this Map as Edford, Plat No 1 and have placed iron monuments at the corners of each block as shown hereon and the same is correct.

Chas. Murray, Surveyor.

State of Minnesota } SS. On this 31st day of July 1923
County of Ramsey } Before me personally appeared Chas. Murray to me well known who acknowledged that he executed the foregoing Certificate as his own free act and deed.

J. W. Mueller
Notary Public Ramsey County Minn.
My Commission Expires April 1st 1930.

This is to Certify that Thure A. Johnson, bachelor, owner of the following described property The North half of the North half of the Southwest Quarter of the Southwest Quarter of Section 16 T. 28 - R. 23 except that part taken for the Chicago Milwaukee and St. Paul Railway, has caused the same to be surveyed and platted and hereafter known as Edford, Plat No 1 and hereby dedicates to the Public for public use forever all the streets, avenues and alleys as shown on this Plat.

Witness my hand and Seal this 31st day of July 1923.

In Presence of
Charles A. Johnson
Thure A. Johnson

State of Minnesota } SS. On this 31st day of July A. D. 1923
County of Ramsey } Before me personally appeared Thure A. Johnson to me well known who acknowledged that he executed the foregoing Certificate as his own free act and deed.

J. W. Mueller
Notary Public Ramsey County Minnesota
My Commission Expires April 1st 1930.

accepted and approved this 2nd day of August 1923


accepted by the Council 4th August 1923
approved 4th August 1923

City Clerk

TAXES PAID AND TRANSFER ENTRIES

AUG 6 1923

All Installments of Assessments due on the within property to date are paid

AUG 8 - 1923
DEPARTMENT OF FINANCE
J. W. Mueller

Taxes for the year of 1922 on the lands described within PAID.

AUG 8 - 1923
ELSA H. DEET, Treasurer,
RAMSEY COUNTY, MINN.
J. W. Mueller

610460