


BEAURLINE'S 2ND ADDITION

o Indicates Monument Scale 1" = 40' Edward R. Schafer
surveyor.

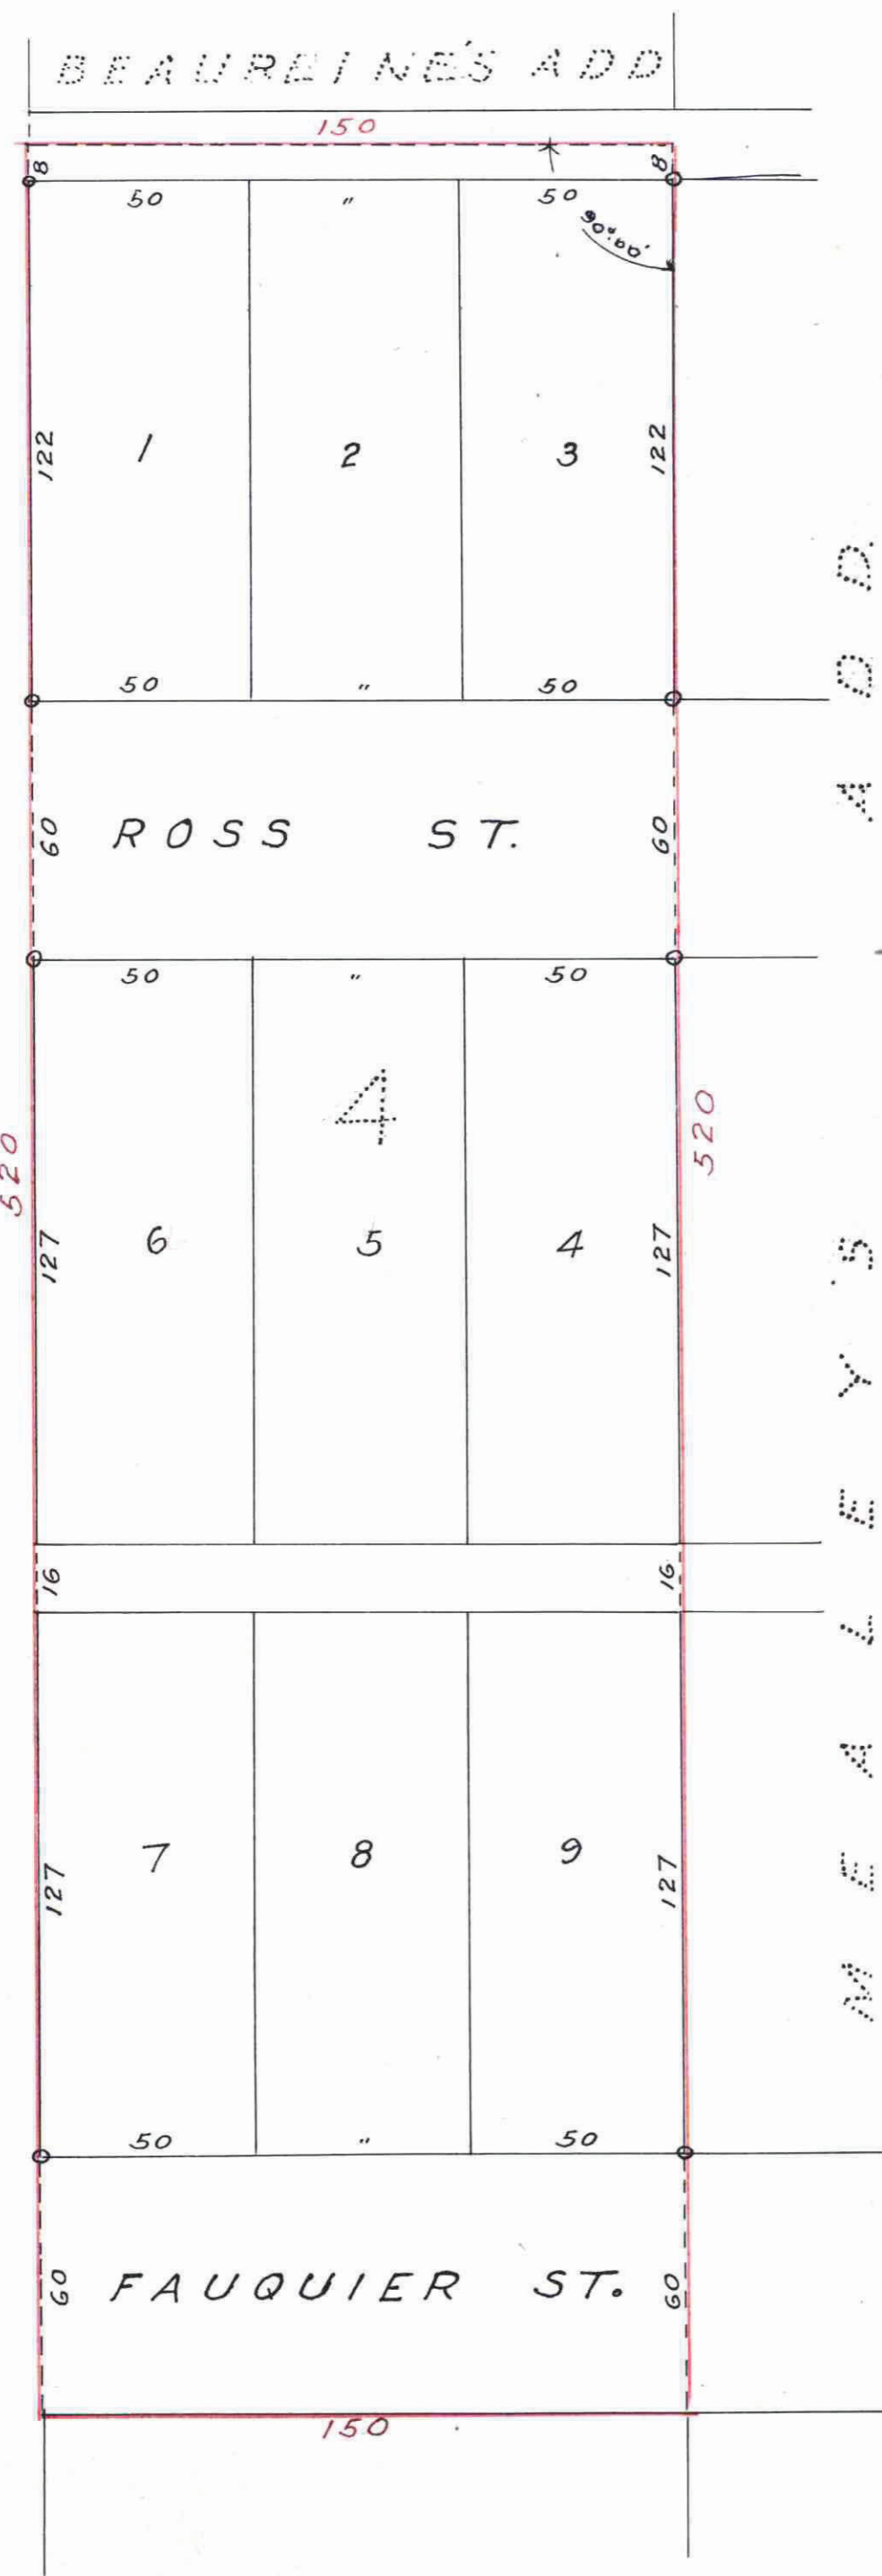

CRUICKSHANK'S GARDEN LOTS

ALLEYS

I hereby certify that having surveyed and platted the property described on this map as "BEAURLINE'S 2ND ADDITION" and have placed iron monuments at the corners as shown on this map, and the same is correct.

Edward R. Schafer
surveyor

76
610317

STATE OF MINNESOTA
County of Ramsey
Office of the Register of Deeds
This is to certify that the within instrument was filed for record in this office at St. Paul on the _____ day of _____ A. D. 19____ at _____ o'clock _____ M., and that the same was duly recorded in Book _____ of _____ Pages _____ Register of Deeds.
By _____ Deputy

State of Minnesota } On this 1st day of August A.D. 1923
County of Ramsey } personally appeared before the under-
signed Edward R. Schafer to me well known, and acknowledged
that he executed the foregoing certificate as his own free
act and deed

E. N. Payne
Notary Public, Ramsey Co., Minn.
My Commission expires _____

This is to certify that Andrew Beauurline, Serina Beauurline his wife, ^{owners of} the State Savings Bank of St. Paul, Minn. mortgagee of the following described tract of land viz, all of Lot 4, Block 3 except the North 122 feet, and the South 200 feet, Cruickshank's Garden Lots, according to the Recorded plat thereof on file and of record in the office of the Register of Deeds, have caused the same to be surveyed and platted and hereafter known as BEAURLINE'S 2ND ADDITION as shown on this plat and hereby dedicate to the public and for public use forever all the streets and Alleys as shown

Witness our hands and seals this 31st day of July 1923
In presence of
John Engen THE STATE SAVINGS BANK President
Frank Schlick Treasurer
Louis Betz Treasurer
Andrew Beauurline
Serina Beauurline

State of Minnesota } On this 31st day of July A.D. 1923, personally appeared before the
County of Ramsey } undersigned Andrew Beauurline and Serina Beauurline his wife to me
well known and acknowledged that they executed the foregoing certificate as their
own free act and deed

Harry Schick
Notary Public, Ramsey Co., Minn.
My Commission expires Feb. 3, 1927

State of Minnesota } On this 31st day of July A.D. 1923 personally appeared before the
County of Ramsey } undersigned Frank Schlick and Louis Betz to me well known
who being duly sworn did say each for himself that Frank Schlick is the President and
Louis Betz is the Treasurer of the State Savings Bank a corporation, that the
seal affixed to the foregoing instrument is the corporate seal of said corporation and
that said instrument was signed and sealed in behalf of said corporation by authority
of its Board of Directors, and the said Frank Schlick and Louis Betz acknowledged
said instrument to be the free act and deed of said corporation

Oscar A. Knobloch
Notary Public, Ramsey Co., Minn.
My Commission expires Mar 20-1927

Accepted and approved this 2^d day of August 1923

Guy B. Jensen Plat Commissioners
Charles H. Benson
James Jordan
John Betz Commissioner of Public Works

Accepted by the Council 4th day of August 1923
Approved Aug 4th 1923

Henry Olson
City Clerk

EST. IN DIST. COURT, MINN.
AUG 7-1923
Taxes for the year of 1922 on the
lands described within PAID.

All Installments of Assessments due
on the within property to date are paid
AUG 4-1923
DEPARTMENT OF FINANCE
DANIEL H. KELLY, Secy.

TAXES PAID
BY (PROPERTY OWNER)

Nielsen

STATE OF MINNESOTA
County of Ramsey
Office of the Register of Deeds
This is to certify that the within instrument was filed for record in this office at St. Paul on the 2^d day of Aug A. D. 1923, at 2:00 P.M., and that the same was duly recorded in Book _____ of _____ Pages _____ Register of Deeds.
By *H. J. Jorgensen* Deputy

This plat document is an UNOFFICIAL copy of a Subdivision Plat or Registered Land Survey and is made available for information purposes only.
To obtain an official copy please contact the Ramsey County Recorder's Office.

640347