


644571

J. AUER'S RE-ARRANGEMENT.

STATE OF MINNESOTA
 County of Ramsey
 Office of the Register of Deeds
 This is to certify that the within instrument was filed for record in this office at St. Paul on the 14th day of September A. D. 1923, at 12 o'clock P. M., and that the same was duly recorded in Book 21 of _____ Pages 1 _____
 By _____ Register of Deeds.
 Deputy

This plat document is an UNOFFICIAL copy of a Subdivision Plat or Registered Land Survey and is made available for information purposes only.
 To obtain an official copy please contact the Ramsey County Recorder's Office.

I hereby certify to having surveyed and platted the property as described on this map as J. AUER'S RE-ARRANGEMENT and have placed iron monuments at the corners of each and every lot as shown on this map, and the same is correct. There are no checks ponds swamps not traveled thorough-fares on or across the property.
 FRANK J. TAVERNIER
 Surveyor.

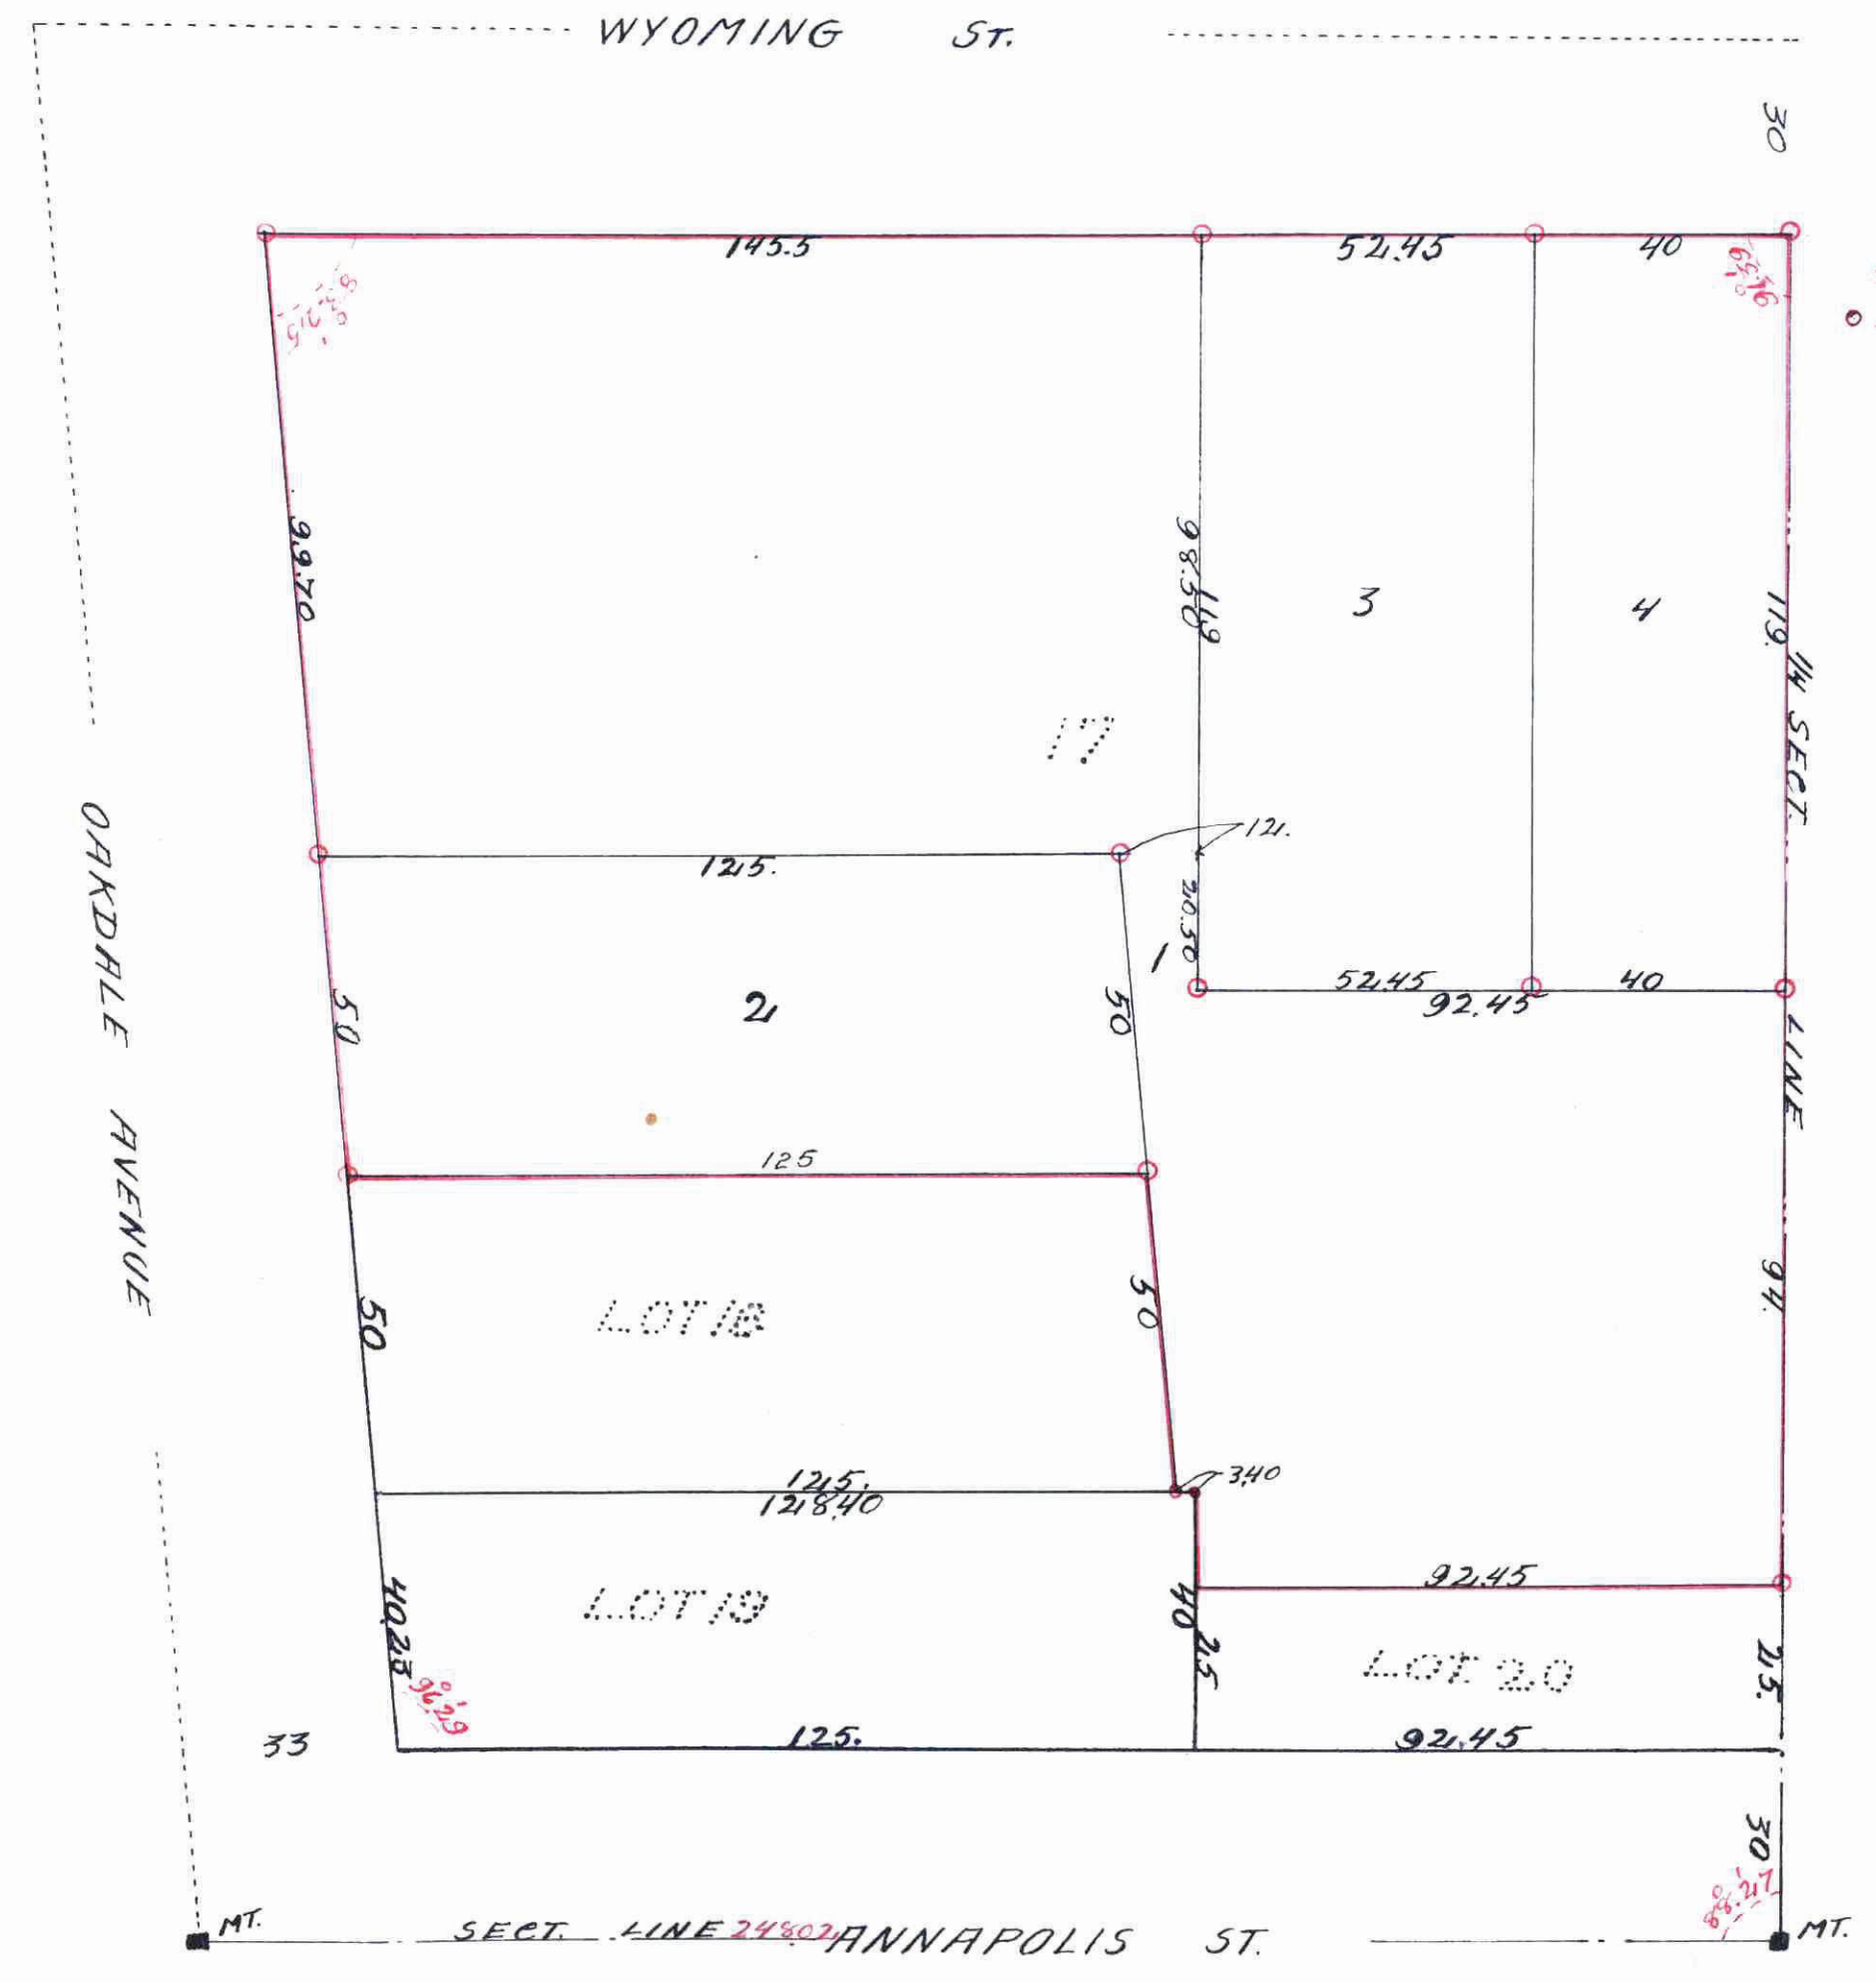

SCALE 30 FEET = 1 INCH
 ○ INDICATE IRON MONT.

BROWN AND JACKSON'S ADD.

STATE OF MINNESOTA
 County of Ramsey } On this 14th day of September
 A. D. 1923, personally appeared the undersigned FRANK J. TAVERNIER, some well known, and acknowledged that he executed the foregoing certificate as his own free act and deed.

[Signature]

Notary Public
 Ramsey Co. MINN.
 My Commission Expires Feb 20 - 1927

This is to certify that John Auer single proprietor of all of LOT 17 OF AUDITOR'S SUB-DIVISION No 22 Ramsey County Minn. has caused the same to be surveyed and platted, and hereafter known as J. AUER'S RE-ARRANGEMENT as shown by this plat.

Witness my hand and seal this 14th day of September 1923

In presence of

[Signature]
[Signature]

[Signature] {SEAL}

STATE OF MINNESOTA
 County of Ramsey } On this 14th day of October A. D. 1923
 personally came before me, the undersigned JOHN AUER, some well known, and he acknowledged that he executed the foregoing certificate as his own free act and deed.

[Signature]

Notary Public
 Ramsey County Minnesota
 My Commission Expires Feb 20th 1927

Accepted and approved this 1st day of Oct. AD. 1923

ALL installments of assessments due on this property to date are paid
 OCT - 1 1923
 DEPARTMENT OF FINANCE
 BY: _____
 (AMOUNT PAID TO COUNTY COMMISSIONER)

Accepted by the Council of the City of St. Paul on the 4th day of Oct. 1923
[Signature] City Clerk

[Signature]
[Signature] } Plat Commission
[Signature] Commissioner of Public Works

644571

[Signature]