

GALARNEAULT'S ADDITION.

132
Rose

o INDICATES IRON SCALE: 1 INCH = 50 FEET. ROBERT R. GODFREY, SURVEYOR.

I hereby certify to having surveyed and plotted the property described on this map as GALARNEAULT'S ADDITION and have placed irons as hereon indicated and the same is correct.
Robert R. Godfrey
Surveyor.

State of Minnesota. } On this 27th day of
County of Ramsey. } October A.D. 1927,
personally appeared before me the undersigned Robert R. Godfrey, to me well known and acknowledged that he executed the foregoing certificate as his own free act and deed.
W.P. Meenan
Notary Public, Ramsey Co. Minn.
My commission expires March 6, 1930.

This is to certify that we Casimir J. Galarneault and Sarah Galarneault his wife proprietors and William Anderson, unmarried mortgagee of the following described property viz: The West one-half of the Southwest one-quarter of the Southeast one-quarter of the Southeast one-quarter of Section Nine (9), Township Twenty-eight (28) North, Range Twenty-three (23), West, in Ramsey County, Minn. have caused the same to be surveyed and plotted and hereafter known as GALARNEAULT'S ADDITION and do hereby dedicate to the public and for public use forever the streets and alleys as herein indicated.

In presence of
Emmett P. Meenan
Edward J. Donnell
L. H. Palou
Casimir J. Galarneault
Sarah Galarneault
William Anderson

State of Minnesota. } On this 3rd day of November A.D. 1927, personally appeared
County of Benton. } before me the undersigned Casimir J. Galarneault and Sarah Galarneault his wife, to me well known and acknowledged that they executed the foregoing certificate as their own free act and deed.

W.A. Latture
Notary Public, Benton Co. Minn.
My commission expires August 11, 1933

State of Minnesota. } On this 27th day of October A.D. 1927, personally appeared
County of Ramsey. } before me the undersigned William Anderson, to me well known and acknowledged that he executed the foregoing certificate as his own free act and deed.

W.P. Meenan
Notary Public, Ramsey Co. Minn.
My commission expires March 6, 1930


Accepted and approved this 24th day of December A.D. 1927.
George G. Hadden
James Gordon } Plot Commissioners
John Anderson } Com'r. of Public Works.

Accepted by the Council December 28th 1927
Approved December 28th 1927
D. J. Anderson
City Clerk.

Taxes for the year of 1926 on the lands described within PAID
DEC 28 1927
ELBA M. CRIST, Treasurer
RAMSEY COUNTY, MINN.
By *A. C. Lundberg*

STATE OF MINNESOTA
County of Ramsey
Office of the Registrar of Deeds
This is to certify that the within instrument was filed for record in this office at St. Paul on the 30th day of December A. D. 1927 at 10 o'clock A.M., and that the same was duly recorded in Book 46 of Town Plats, Page 19.
J. J. Gagnier
Registrar of Deeds.

This plat document is an UNOFFICIAL copy of a Subdivision Plat or Registered Land Survey and is made available for information purposes only.
To obtain an official copy please contact the Ramsey County Recorder's Office.

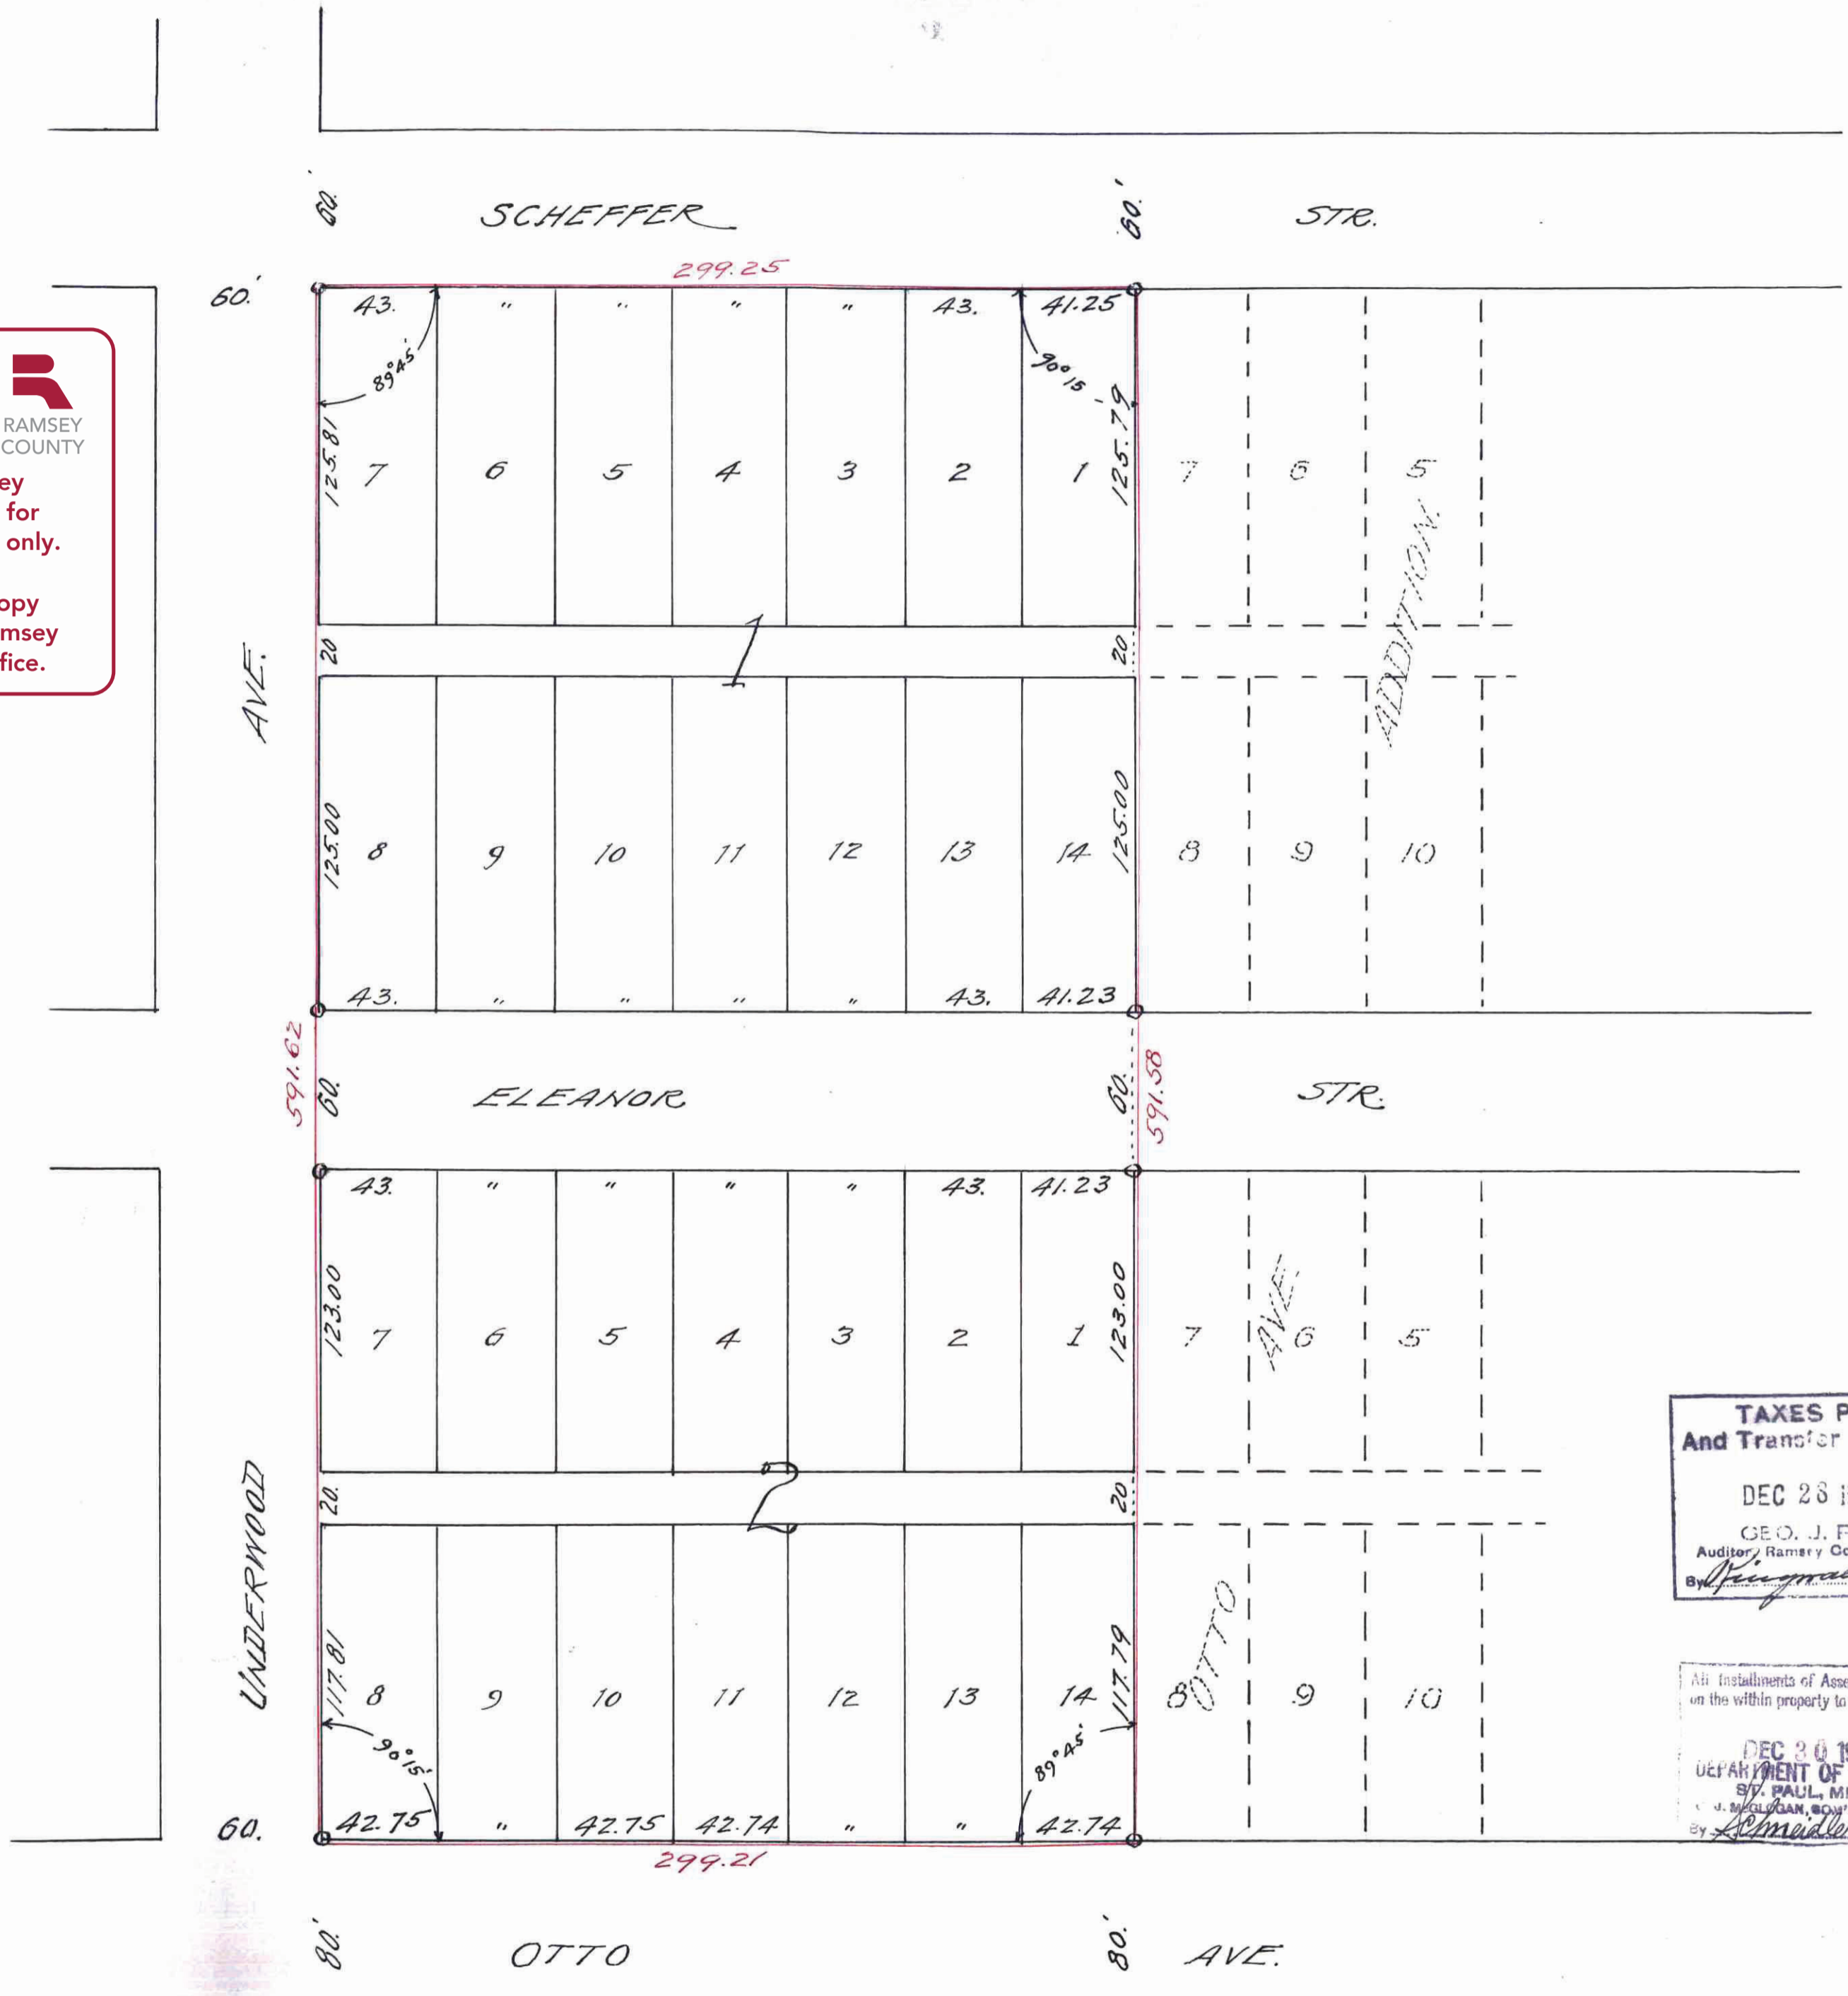

750190