

807570

DAYTONIA ADDITION


Scale 20 Feet per inch
o Indicates iron

This plat document is an UNOFFICIAL copy of a Subdivision Plat or Registered Land Survey and is made available for information purposes only.

To obtain an official copy please contact the Ramsey County Recorder's Office.



Jens Pedersen Surveyor

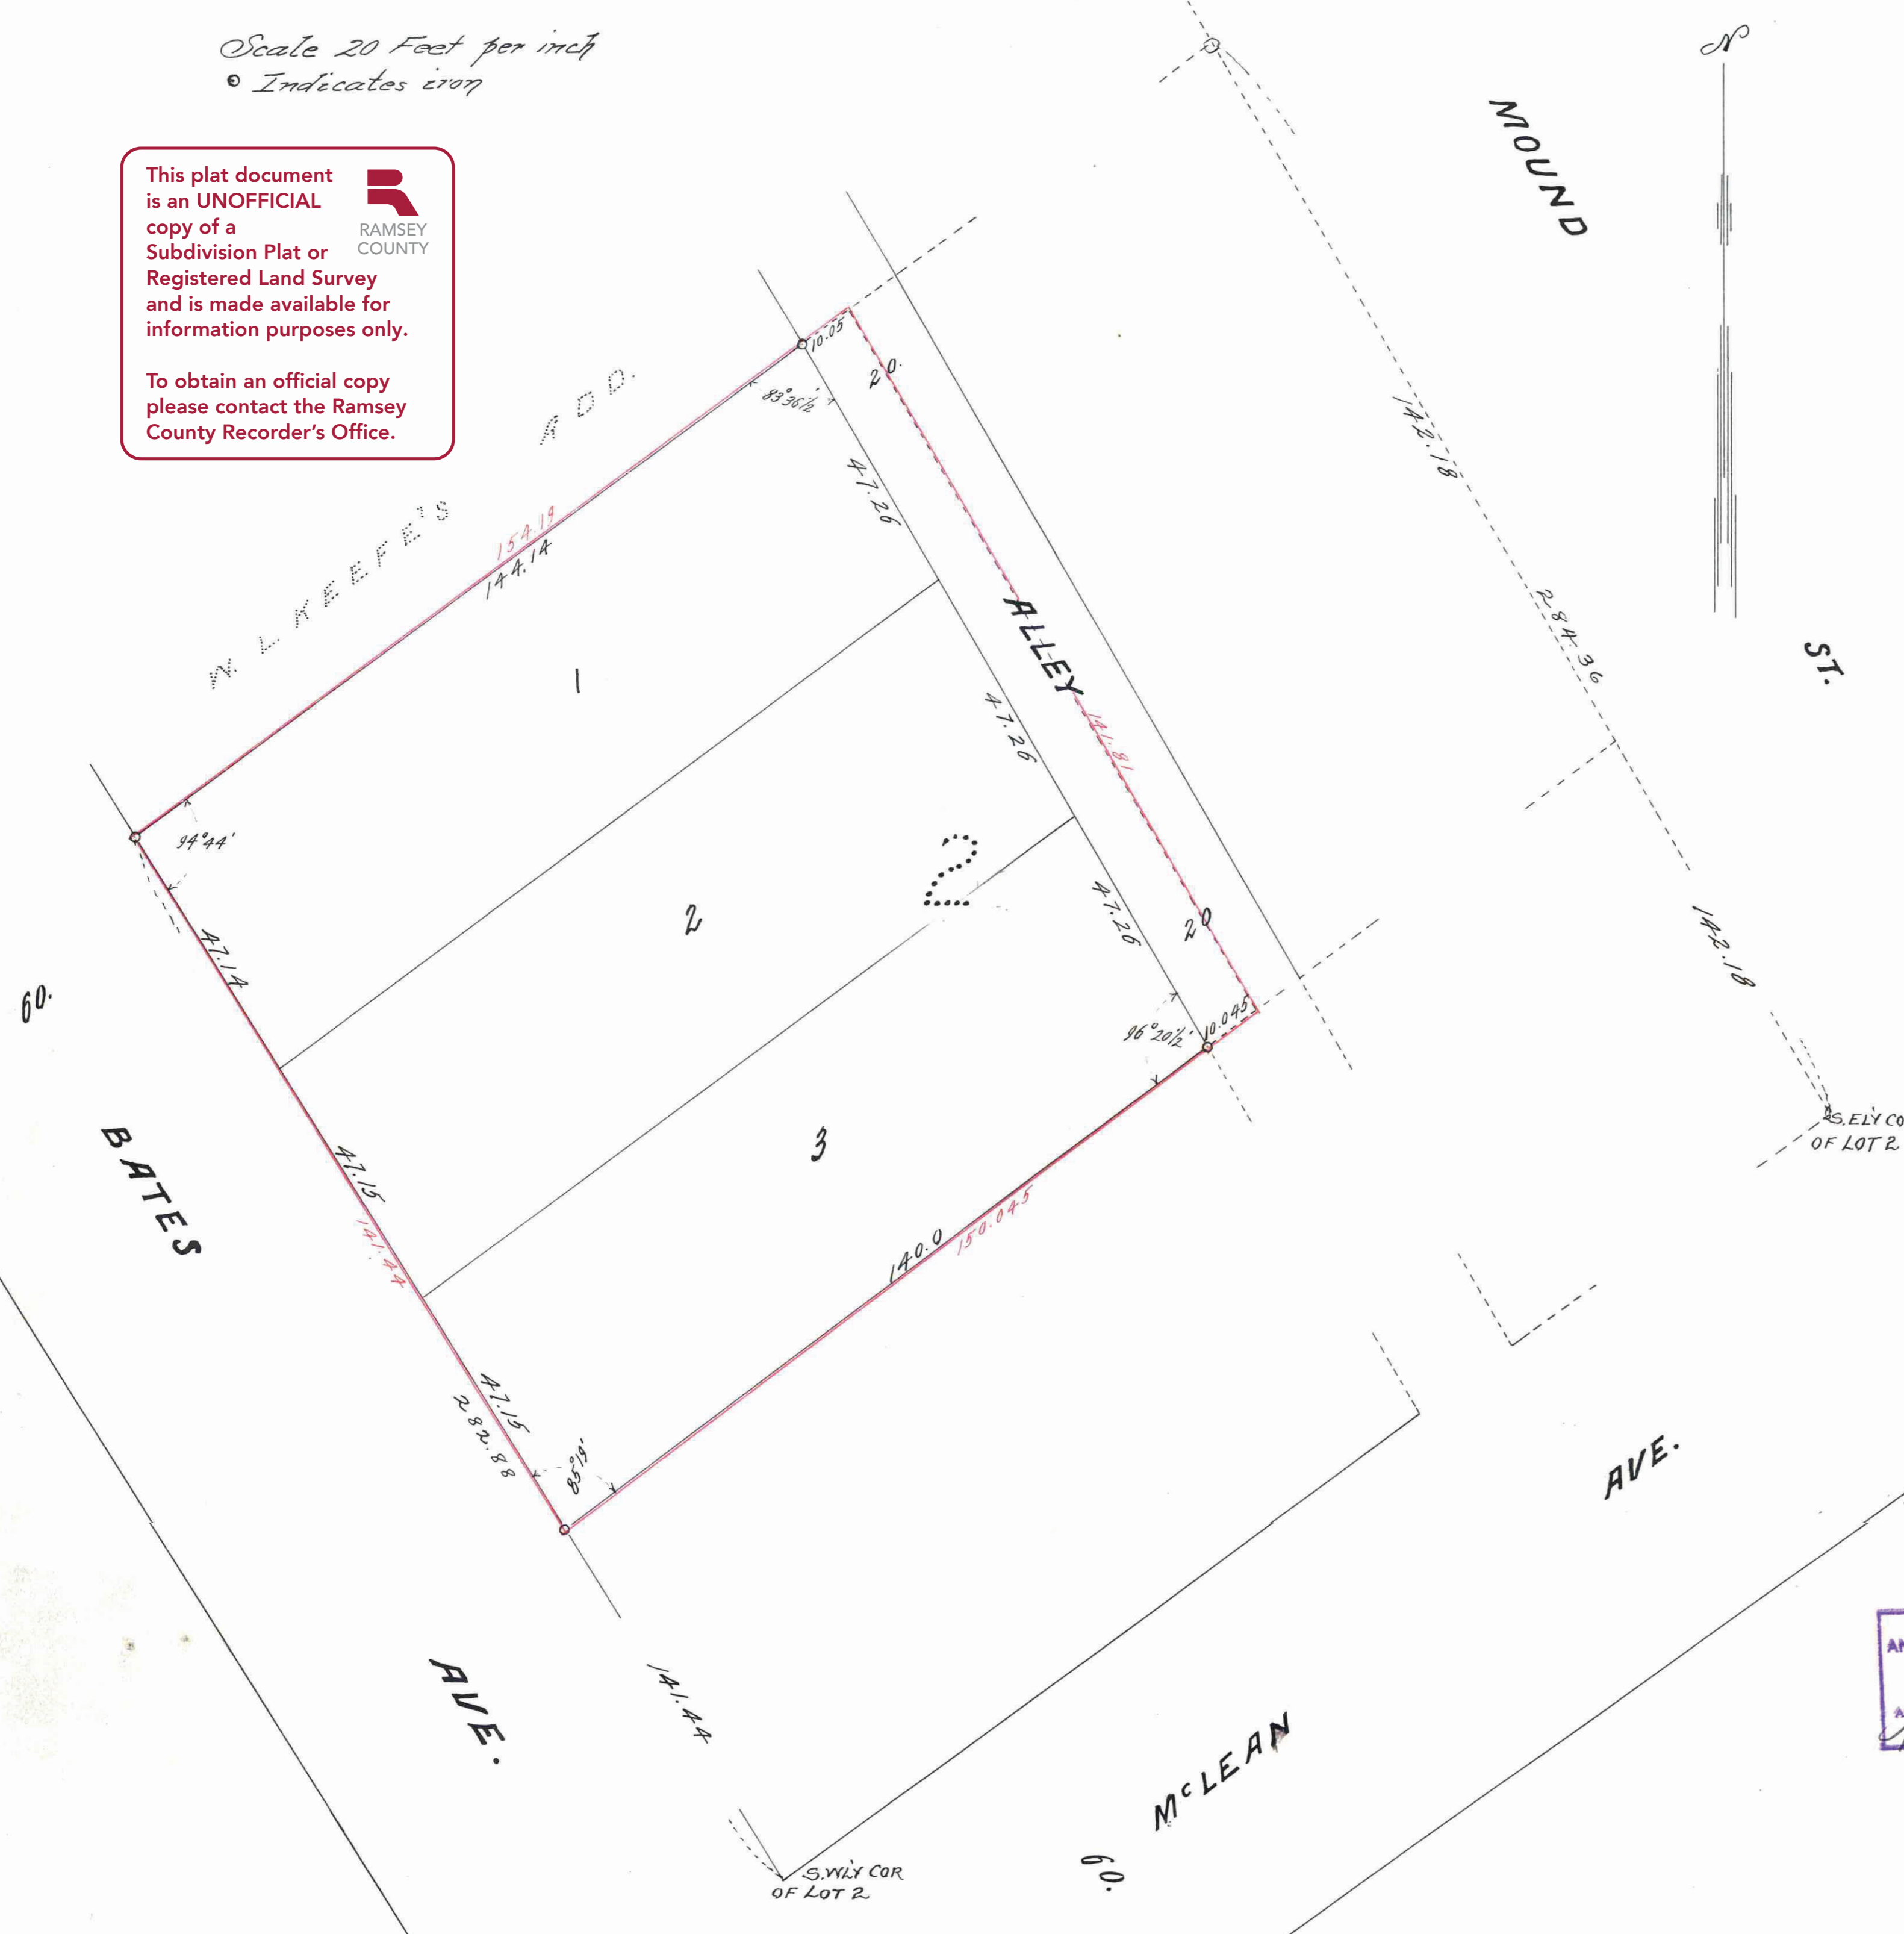

I hereby certify to having surveyed the property described on this plat as Daytonia Addition, and have placed irons at the corners as shown, and the same is correct. There is no low wet ground nor any traveled road or easement on or across same, except as shown.

Jens Pedersen
Surveyor

State of Minnesota } On this 25th day of
County of Ramsey } October A. D. 1930 before
me personally appeared, Jens Pedersen, to
me well known and acknowledged that
he executed the foregoing certificate as his
own free act and deed.

Notary Public, Ramsey Co., Minn.
My Commission expires Sept. 16, 1931.

This is to certify that, Lampland Lumber Company, a corporation existing under and pursuant to the laws of the state of Delaware, proprietor of all that part of Lot 2 Block 1 Suburban Hills addition to the city of St. 141.22 feet to the place of beginning, has caused the same to be platted and hereafter known as, Daytonia Addition, as shown on this plat and thereby dedicates to the public, for public use forever, all the streets, avenues and alleys as hereon indicated.

In witness whereof said corporation has executed this instrument by its duly authorized officers and has caused its corporate seal to be affixed this 25th day of October A. D. 1930.

In presence of
Oscar Lampland }
Edgar T. Erickson }
By Oscar Lampland
President
and Edgar T. Erickson
Secretary.

State of Minnesota } ss On this 25th day of October before me appeared
County of Ramsey } Oscar Lampland and Edgar T. Erickson to me personally
known who being by me duly sworn did say that they are the president and
secretary respectively of Lampland Lumber Company, and that the seal affixed to
the foregoing instrument is the corporate seal of said corporation and that said
instrument was signed and sealed in behalf of said corporation by authority of its
duly authorized officers and said Oscar Lampland and Edgar T. Erickson acknowledged
said instrument to be the free act and deed of said corporation.

Notary Public, Ramsey Co., Minn.
My Commission expires Sept. 16, 1931.

Accepted and approved this 21st day of October A. D. 1930.

Accepted and approved this 21st day of October A. D. 1930.
Commissioners
Commissioner of Public Works.

Accepted by the Council, Approved, City Clerk.

TAXES PAID AND TRANSFER ENTERED
NOV 6 - 1930
GEO. J. RIES
Register

NOV 6 - 1930
Schmidler

STATE OF MINNESOTA
County of Ramsey
Office of the Register of Deeds
This is to certify that the within instrument was filed for record in this office at St. Paul on the 24th day of November A. D. 1930, at 3 o'clock P. M., and that the same was duly recorded in the book of Deeds of Ramsey County, Minn., page 14.

Taxes for the year of 1929 on the lands described within PAID
NOV 6 - 1930
Elsa M. Ohst, Treasurer

807570