


Rudolph's Rear^e of Lots 1, 2, 3, 4, & 5 Blk 114. West St. Paul Proper to St. Paul.

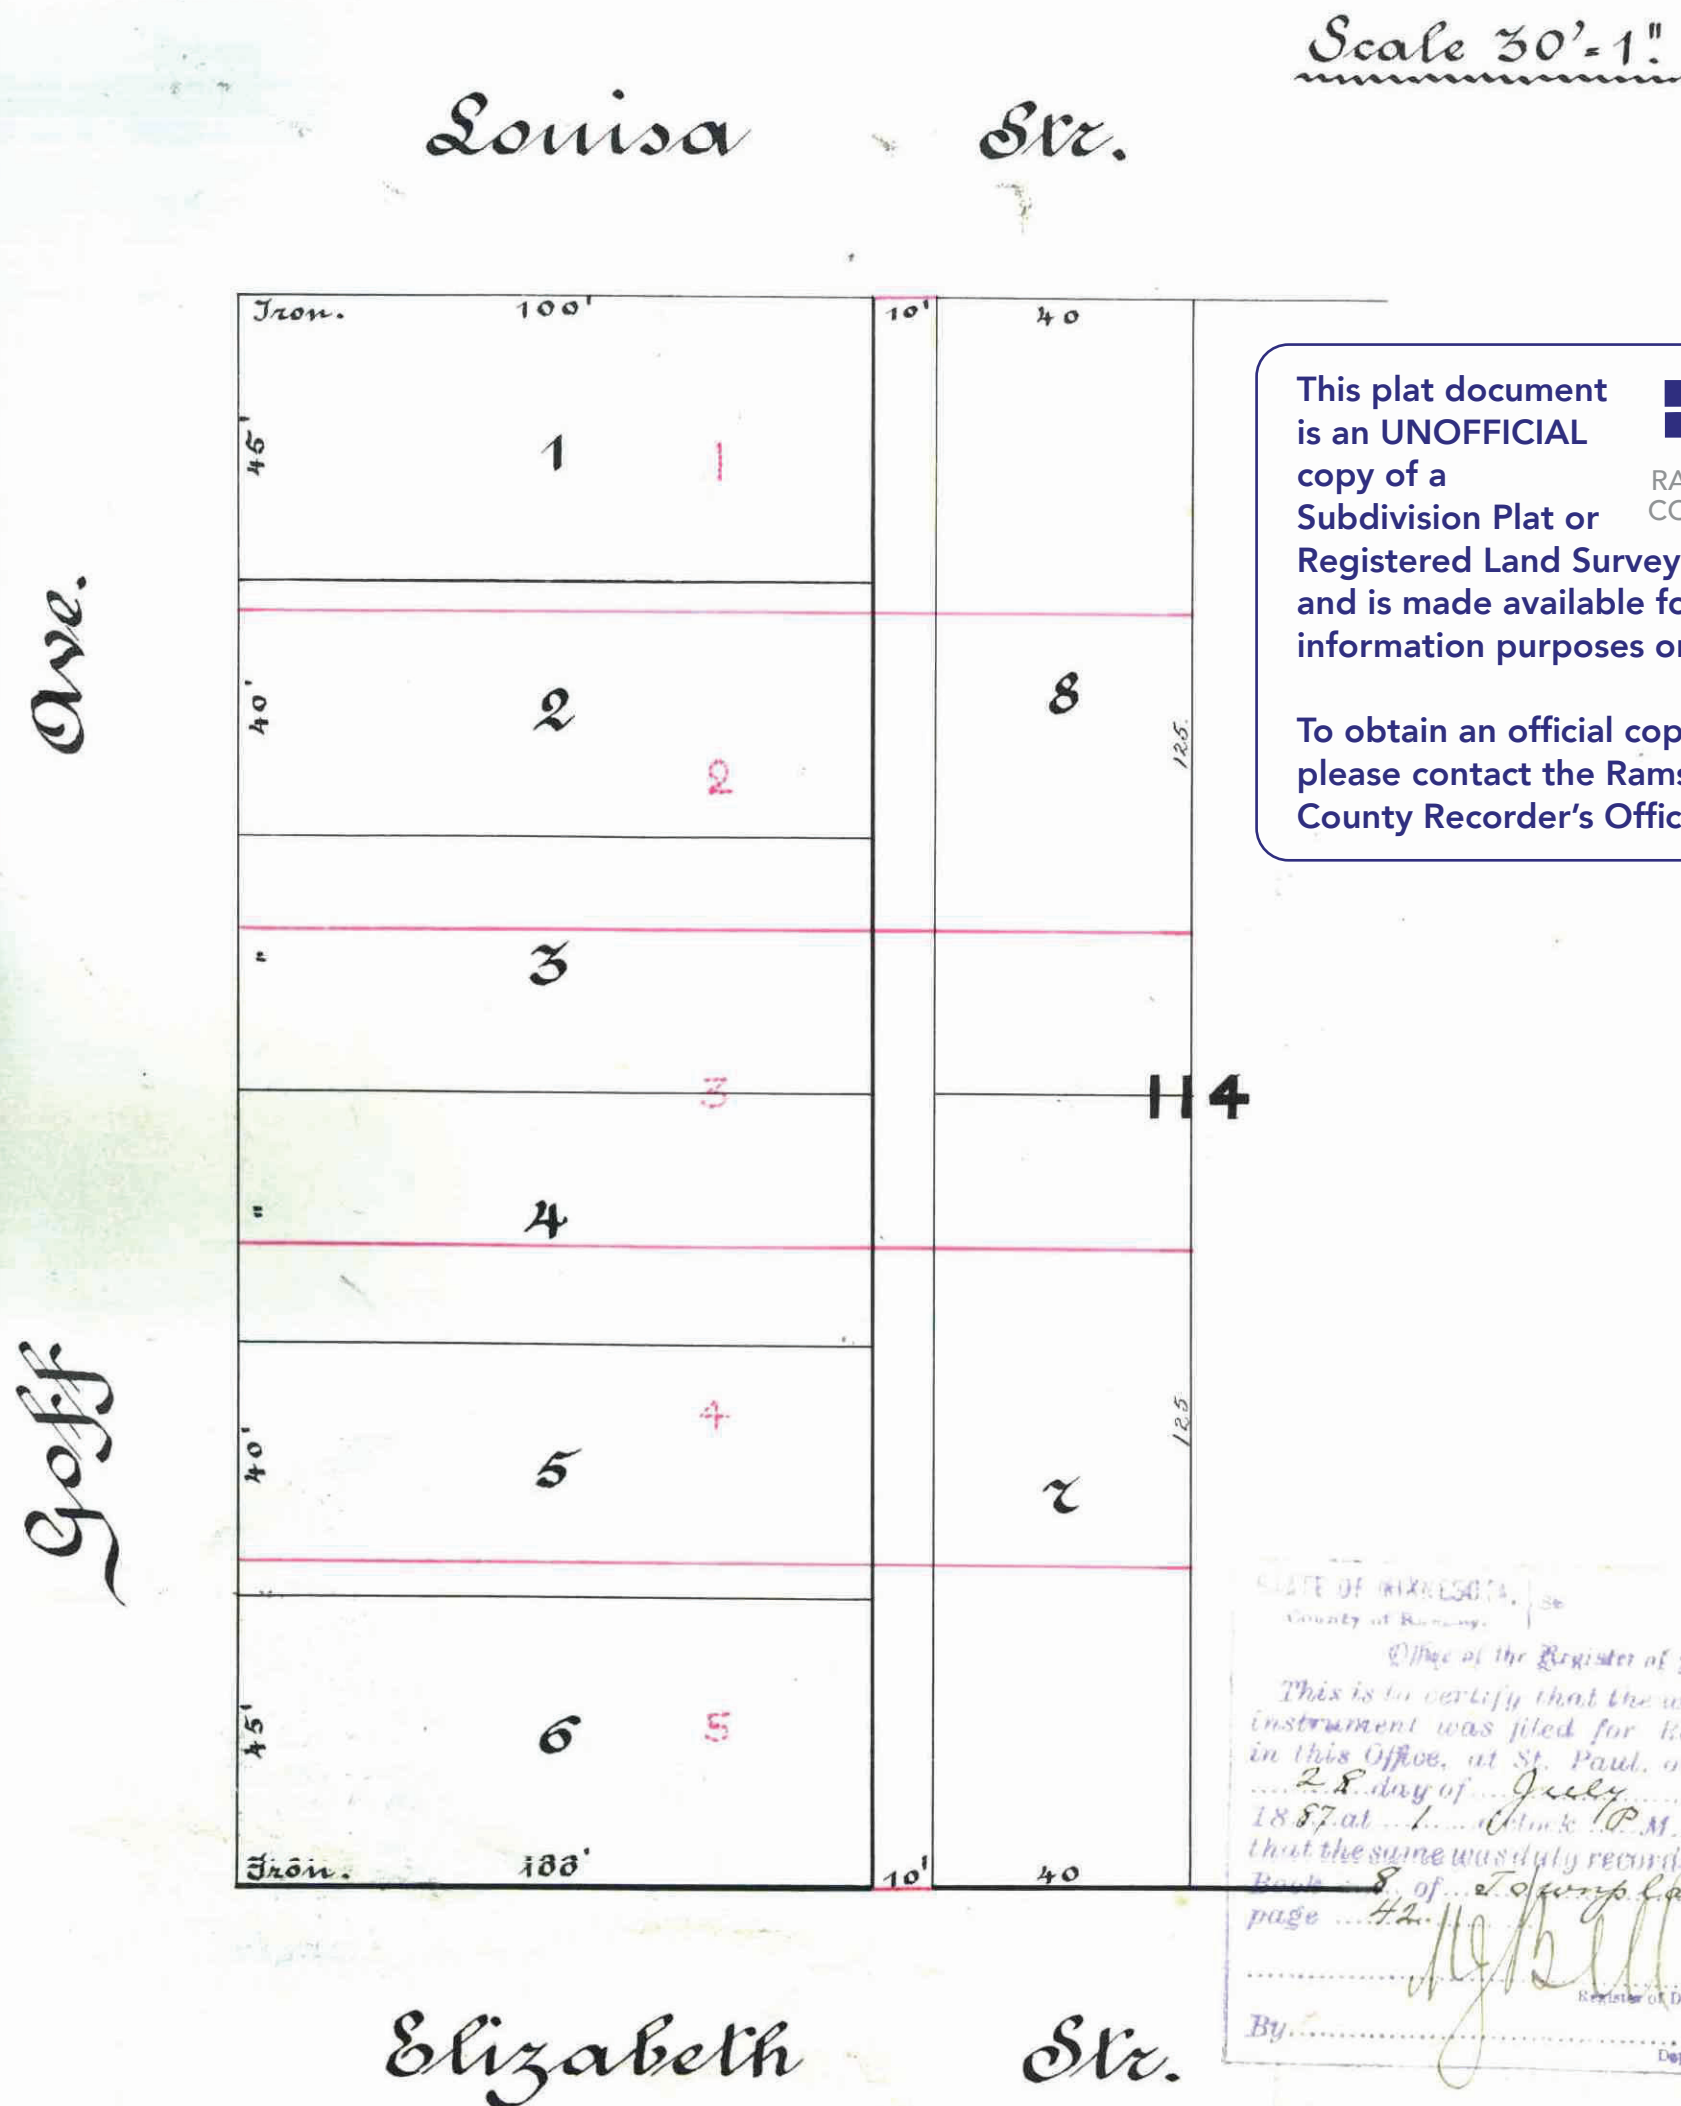

I hereby certify to having surveyed and platted the property as described on this map as Rudolph's Rear^e of Lots 1, 2, 3, 4 & 5 Blk 114 West St. Paul Proper to St. Paul and have placed iron monuments as shown on this map, and the same is correct.

Max Tolly

Surveyor.

This is to certify that Charles Rudolph proprietor of Lot 1, 2, 3, 4 & 5 Blk 114 West St. Paul Proper to St. Paul has caused the same to be surveyed and platted, and hereafter known as Rudolph's Rear^e as shown by this plat and hereby dedicate to the public, and for the public use forever the alley as herein indicated. Witness our hands and seals, this 18th day of July 1887.

In presence of *John S. Sanborn* Charles Rudolph
Oliver A. Wheeler

Accepted and approved this 18th day of July A.D. 1887

L. P. Holcomb
Ed. Starkey
W. J. Fundstad } Plat Commissioners

Taxes paid July 18, 1887 *W. J. Kain*

County Auditor.
Per *Sanborn* Ramsey Co., Minn.
Assessments

W. J. Kain
City Treasurer, St. Paul.

State of Minnesota, County of Ramsey
On this Eighteenth day of July A.D. 1887, personally appeared before the undersigned Max Tolly to me well known, and acknowledged that he executed the foregoing certificate as his own free act and deed.

John S. Sanborn

Notary Public
Ramsey Co., Minn.

State of Minnesota, County of Ramsey
On this Eighteenth day of July A.D. 1887, personally came before me Charles Rudolph to me well known and he acknowledged that he executed the foregoing certificate for the uses and purposes therein expressed

John S. Sanborn

Notary Public
Ramsey County, Minn.

I hereby recommend the acceptance of the within plat by the common council.

City Engineer

Accepted by the common council of the city of St. Paul on the 21st day of July 1887

Wm. J. Kain
City Clerk.

