


AUDITOR'S SUBDIVISION No. 89

RAMSEY CO. MINN.

Scale: 1 in. = 400 ft.

May 1938

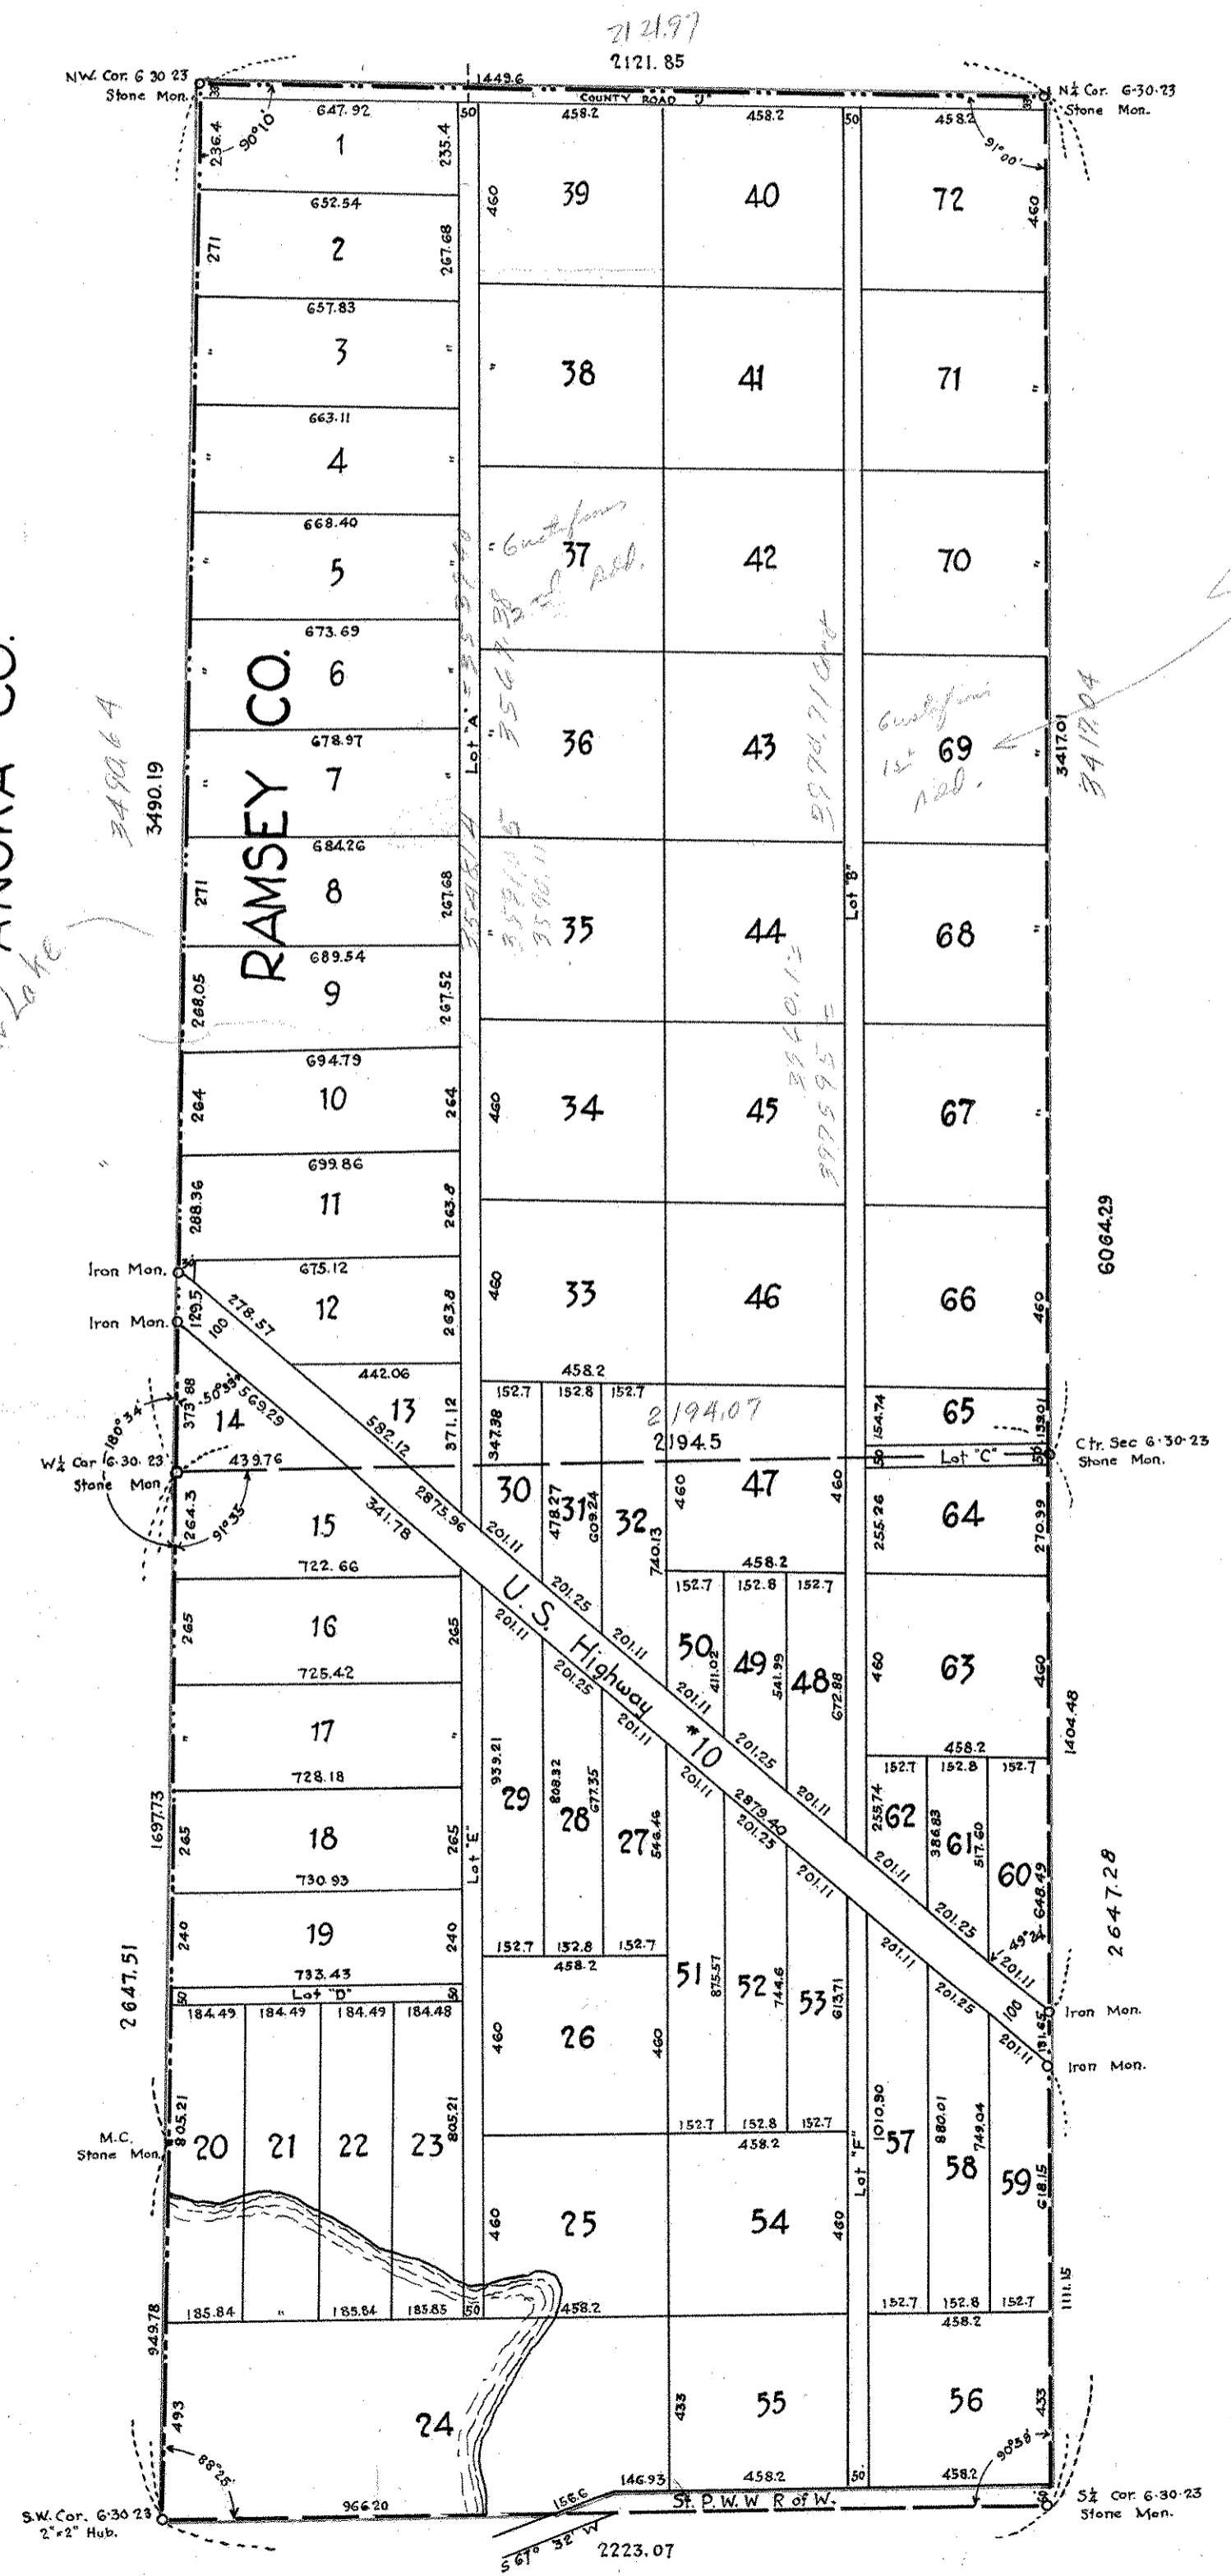

I, Harry S. Bronson, County Surveyor of Ramsey County, Minnesota, hereby certify to having platted the property as described on this map upon request and by order of the County Auditor, as Auditor's Subdivision No. 89, Ramsey Co. Minn., and the same is correct in accordance with records of Register of Deeds

Harry S. Bronson
COUNTY SURVEYOR

STATE OF MINNESOTA } On this 26th day of May A.D. 1938, personally appeared before me
COUNTY OF RAMSEY } Harry S. Bronson, County Surveyor of Ramsey County, to
me well known and acknowledged that he executed the foregoing certificate as his
own free act and deed.

L. H. Palmer
Notary Public, Ramsey Co., Minn.
My Commission Expires Aug. 7, 1943

STATE OF MINNESOTA } I, Eugene A. Monick, County Auditor of the County and State
COUNTY OF RAMSEY } aforesaid do hereby certify that in compliance with, and according
to the provisions of Section 2219, Mason's Minnesota Statutes for 1927, I have as such
County Auditor, caused the following described tract of land to wit, The
W^{1/2} excepting, Co. Road J, US Highway No 10 and St. Paul Water Works Right of Way, all
being in Section 6, Twp. 30 N., Rge. 23 W., to be platted and hereafter known as
Auditor's Subdivision No. 89, Ramsey Co. Minn., as shown on this plat.

Witness my hand and official seal this 26th day of May A.D. 1938

IN PRESENCE OF:

S. C. Ringwald
Edward J. Daniel

Eugene A. Monick
COUNTY AUDITOR

STATE OF MINNESOTA } On this 26th day of May A.D. 1938, personally appeared before me,
COUNTY OF RAMSEY } Eugene A. Monick, County Auditor of Ramsey County, to me well
known and acknowledged that he executed the foregoing certificate as his own free
act and deed.

Edward J. Daniel
Notary Public, Ramsey Co., Minn.
My Commission Expires July 13, 1944

Recorded May - 31 - 1938
Abstract # 932300
Torrens # 170750