

DAVIDSON'S FOURTH SUBDIVISION STOCKDALE FARMS

RAMSEY CO., MINN.

We hereby certify to having surveyed the property as described on this plat as DAVIDSON'S FOURTH SUBDIVISION STOCKDALE FARMS, and placed iron monuments at the corners of every block as shown, and the same is correct. There is no low wet ground nor any traveled road or easement on or across same except as shown.

DRUAR & MILLINOWSKI
By *A. S. Milinowski*
Surveyor
Registration # 156

State of Minnesota) On this 5th day of August
County of Ramsey) AD. 1938 before me personally
appeared, Arthur S. Milinowski, of Druar &
Milinowski to me well known, and acknowledged
that he executed the foregoing certificate as his
own free act and deed.

Van J. Pezdek
Notary Public, Ramsey County, Minn.
My commission expires Dec. 11, 1942

This is to certify that Watson P. Davidson, proprietor of all that tract or parcel of land lying and being in the County of Ramsey and State of Minnesota described as follows, to wit:
All of lot two (2) of Stockdale Farms and the North seven (7) feet of Lot eleven (11) Stockdale Farms, lying between the North line of County Road F and South line of Lot two (2), has caused the same to be platted and hereafter known as DAVIDSON'S FOURTH SUBDIVISION STOCKDALE FARMS, as shown on this plat, and hereby dedicates to the public, for public use forever, all the streets, avenues, alleys, parks and boulevards, as hereon indicated.
Witness our hands and seals this 21st day of July 1938.

In presence of

Earl J. Reed
J. M. Chase

Watson P. Davidson
Sarah M. Davidson

State of Minnesota) ss
County of Ramsey)

On this 21st day of July, 1938 before me personally appeared Watson P. Davidson and Sarah M. Davidson, his wife, to me well known, and acknowledged that they executed the foregoing certificate as their own free act and deed.

J. M. Chase
Notary Public, Ramsey County, Minnesota
My Commission expires September 8, 1940


Accepted and approved this 25 day of Aug AD. 1938

George E. Herwood
Mark W. Woodruff
Howard H. Hodgins
Plat
Commissioners

Milton Rosen Commissioner of Public Works

Accepted and approved by Board of County Commissioners of the County of Ramsey, State of Minnesota, this 27th day of August AD. 1938

John Amundson
County Auditor

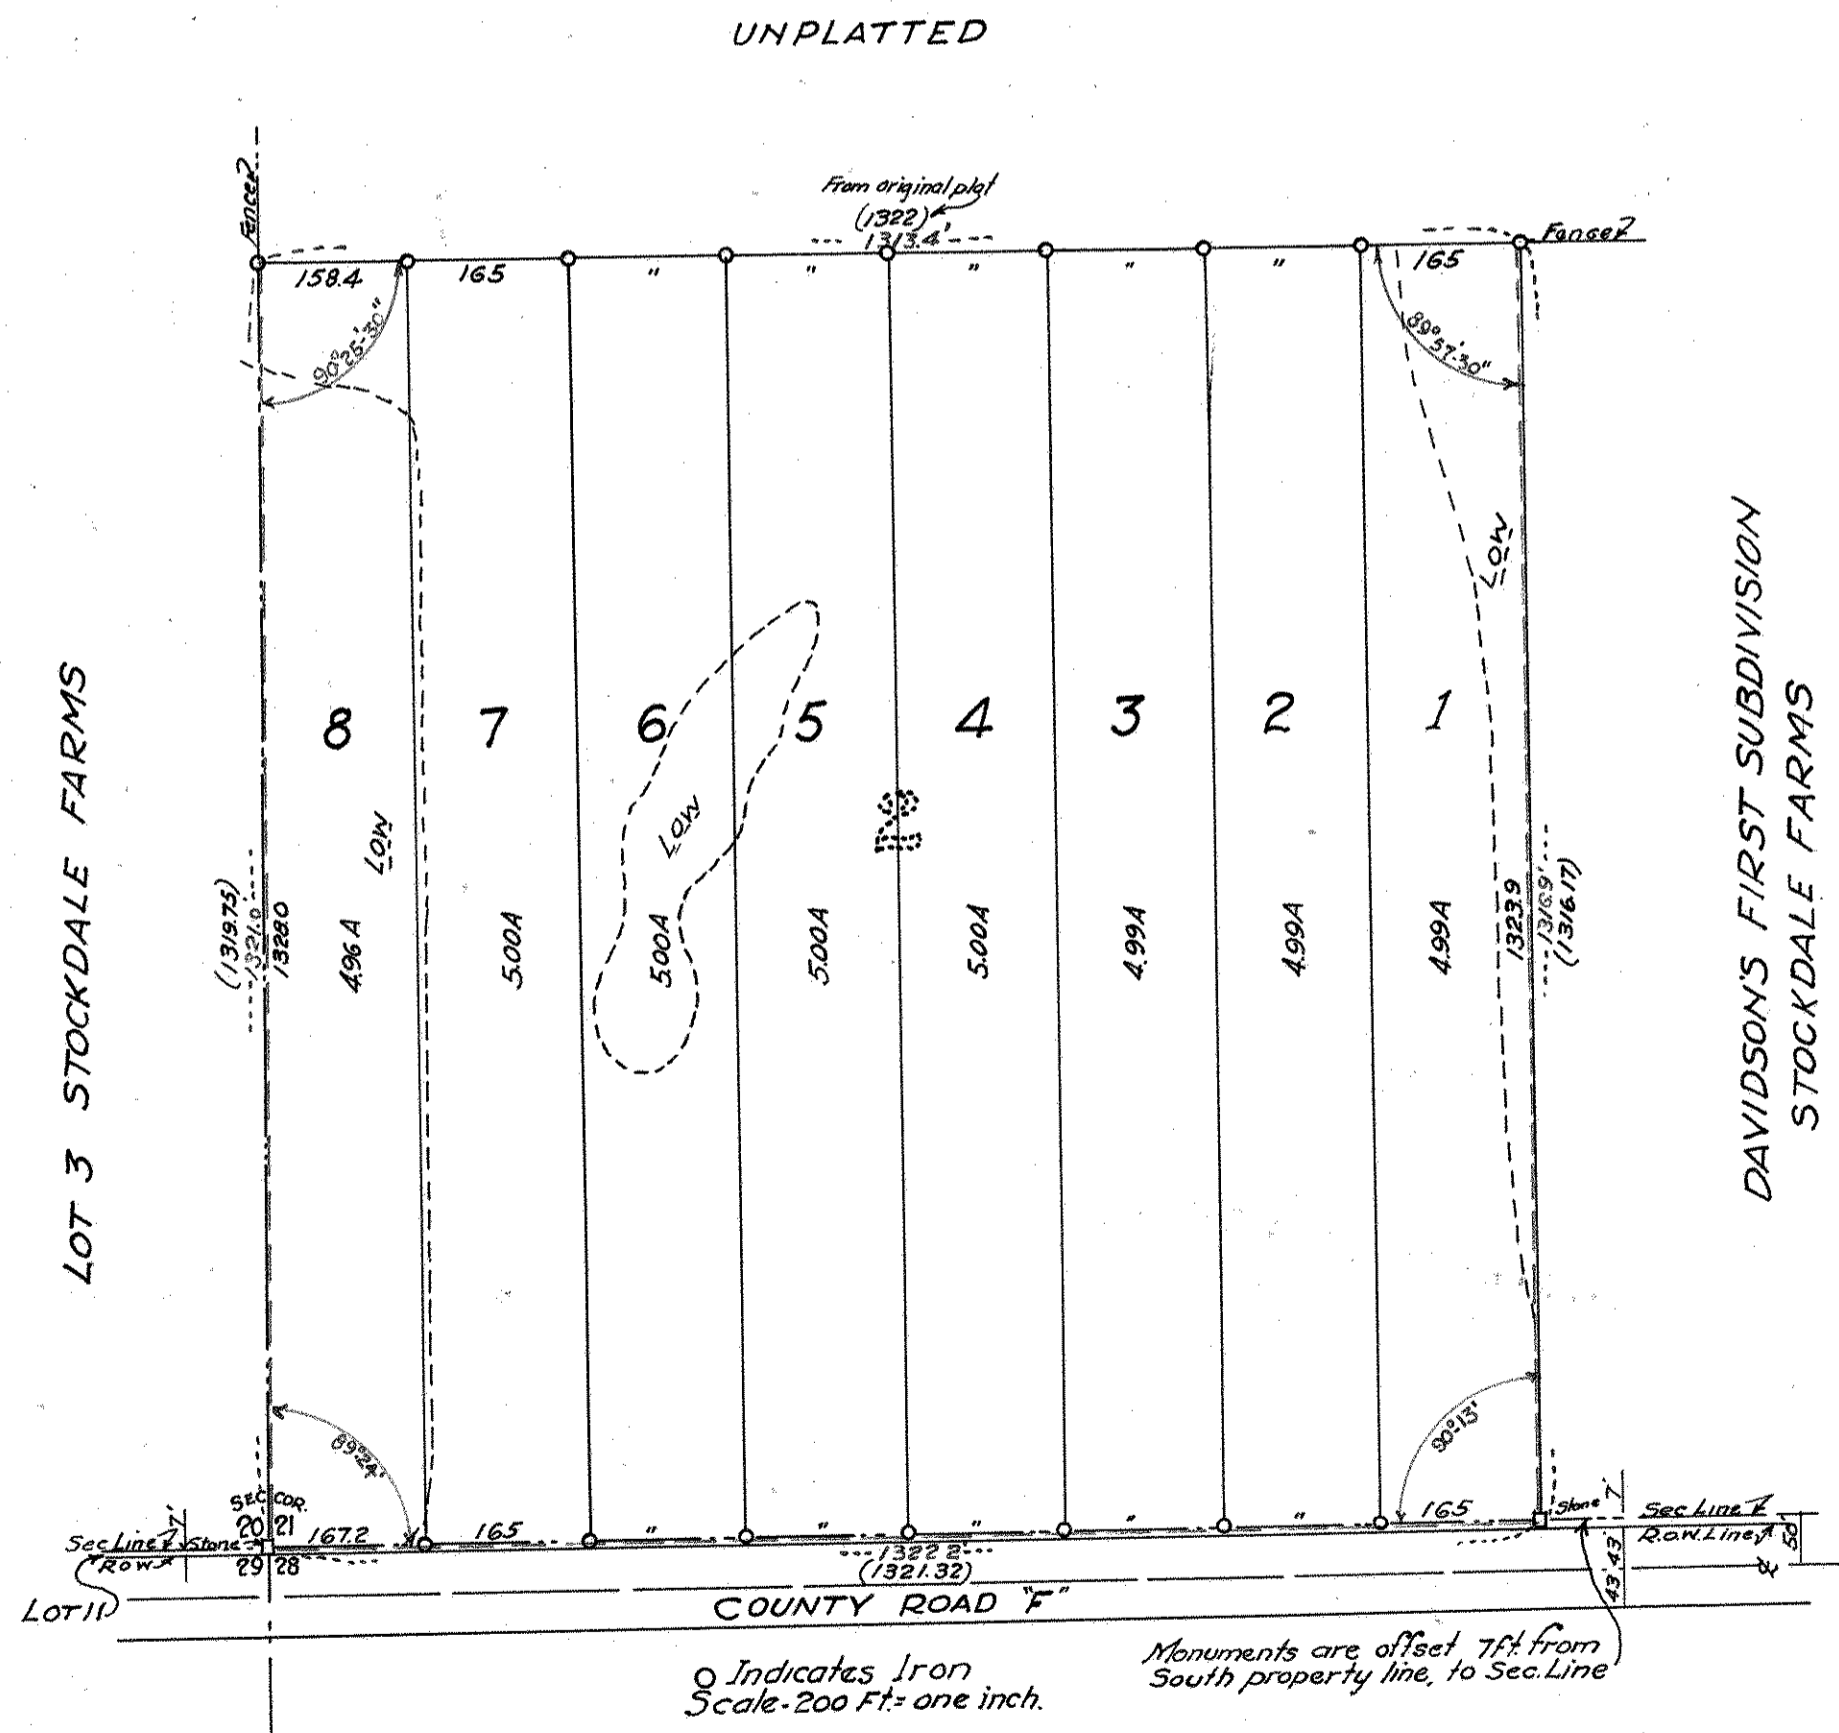

LOT 11 STOCKDALE FARMS

Recorded Sep. 6-1938