

947220

FORT SNELLING VIEW


St. Paul, Minn.

T. J. Welch Surveyor.

Scale 50 Feet per inch
o Indicates iron

This plat document is an UNOFFICIAL copy of a Subdivision Plat or Registered Land Survey and is made available for information purposes only.

To obtain an official copy please contact the Ramsey County Recorder's Office.

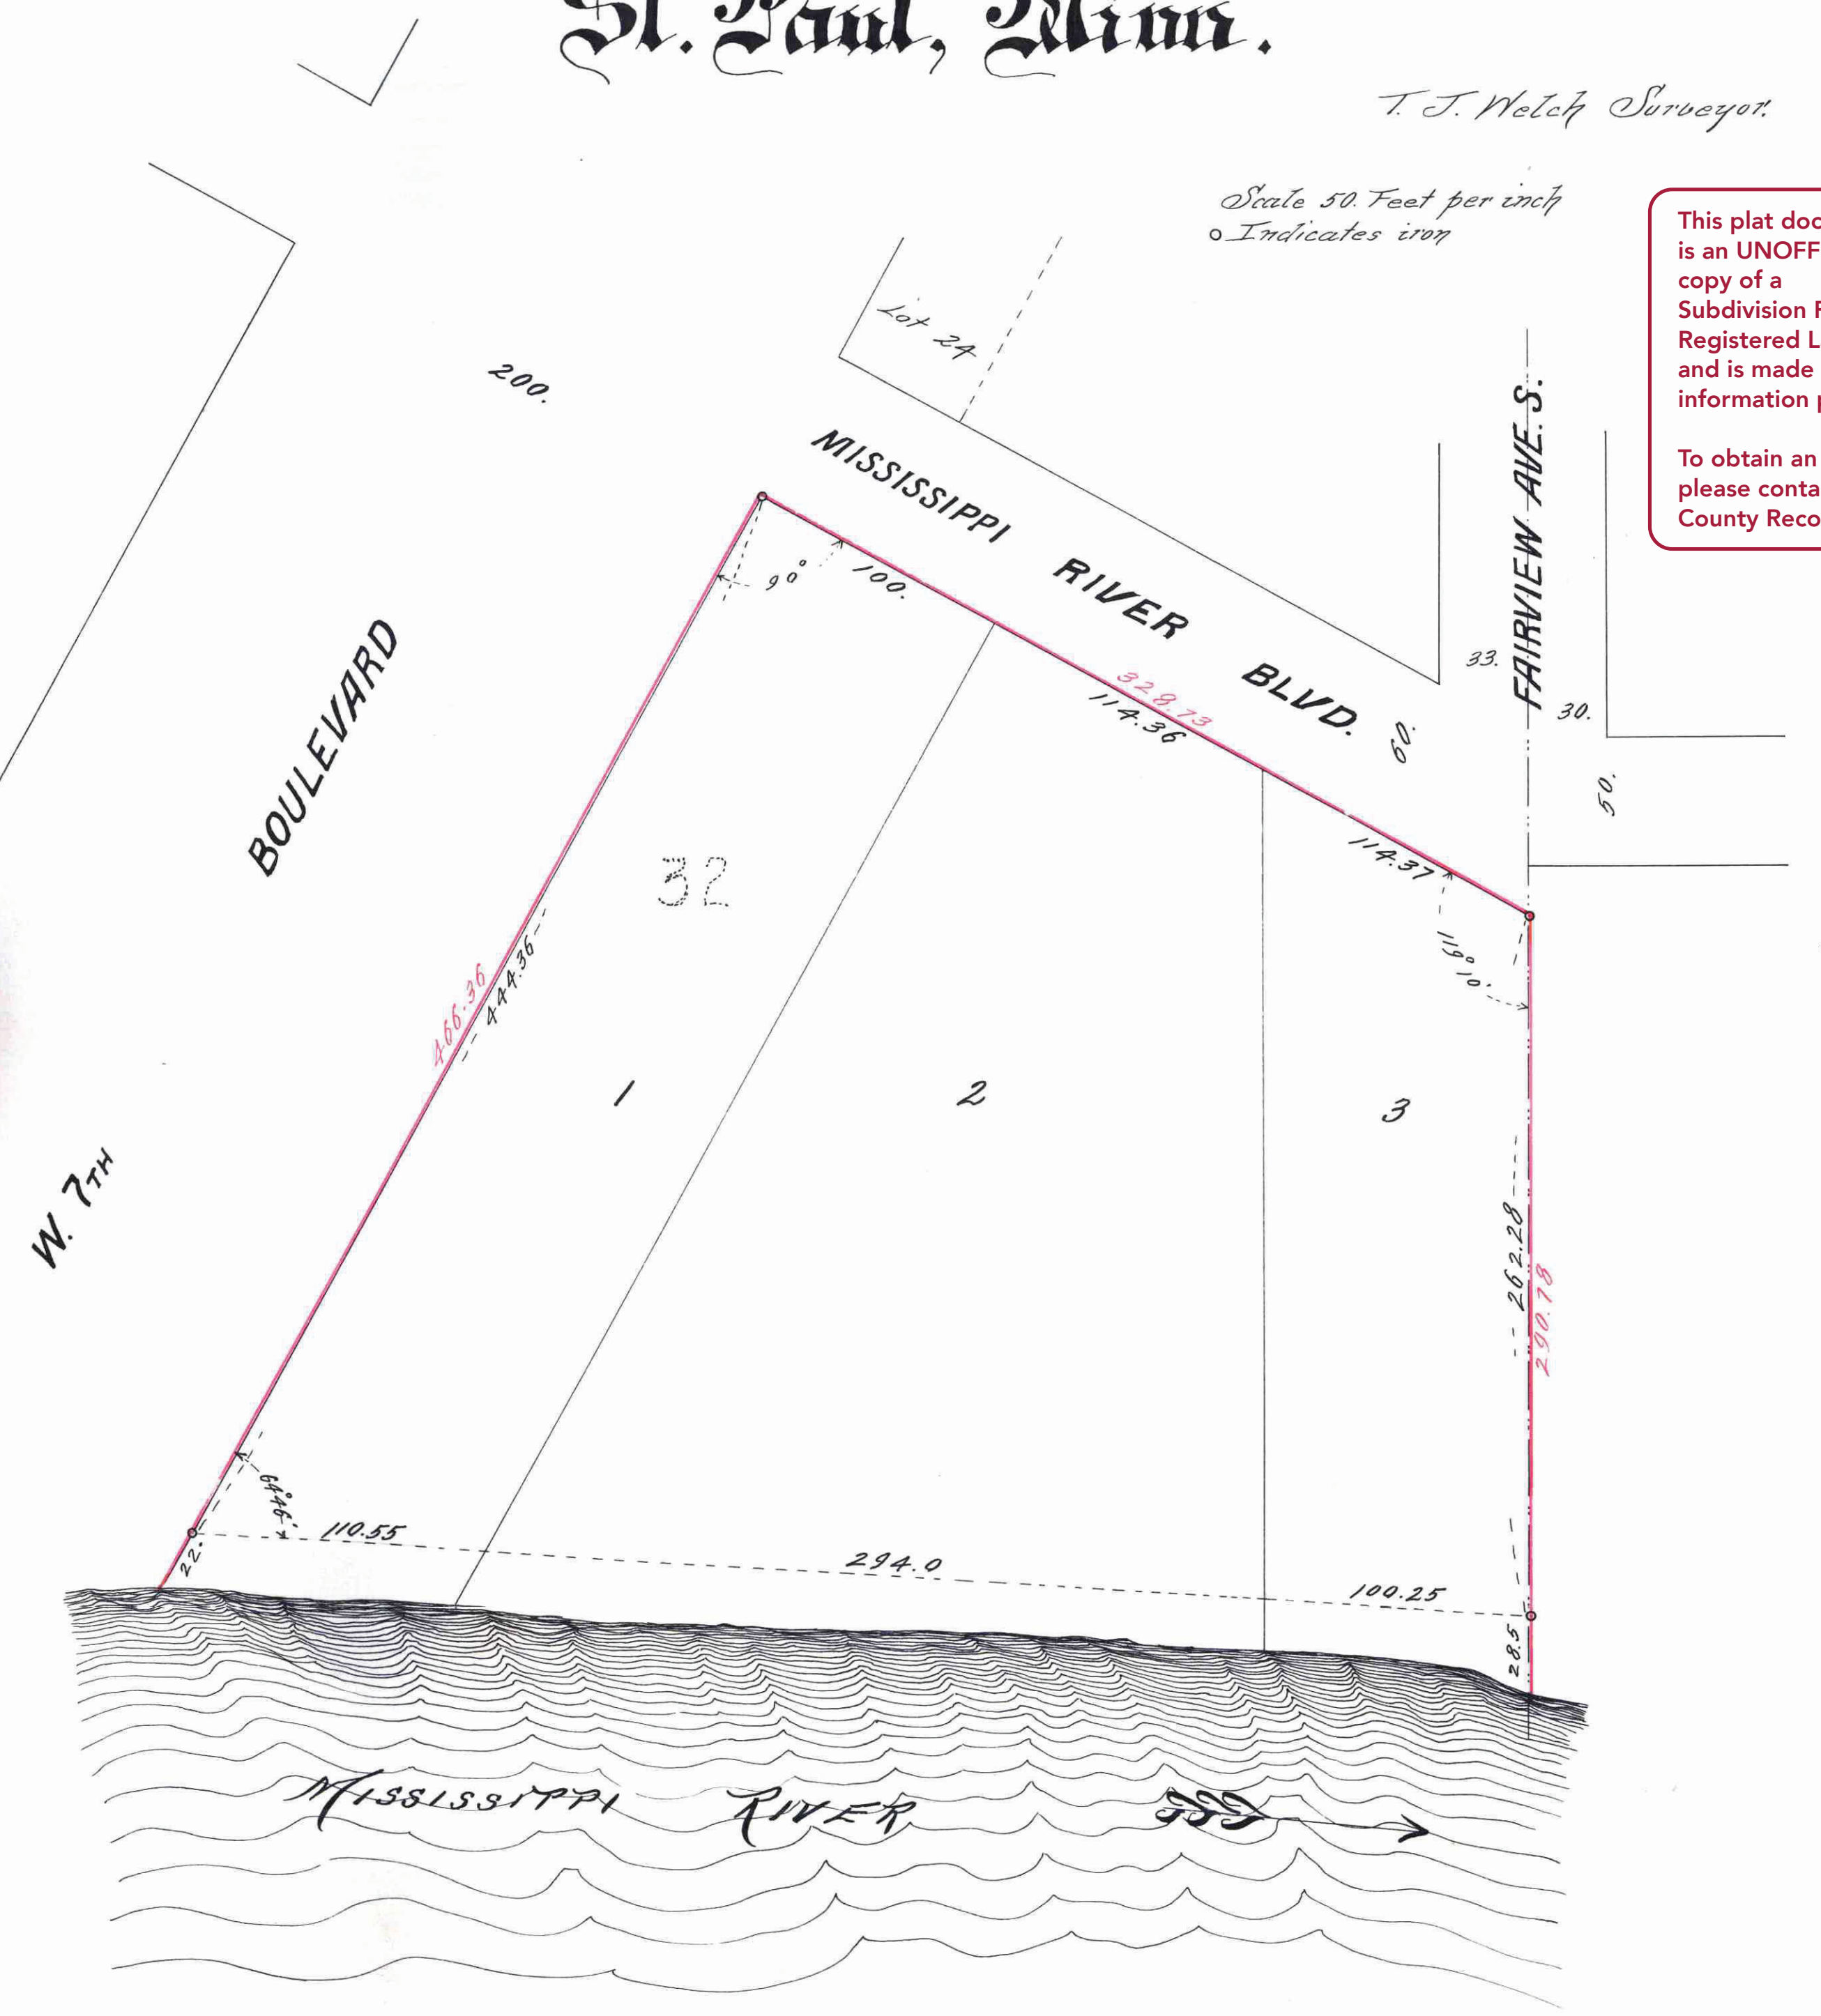

I hereby certify to having surveyed the property described on this plat as Fort Snelling View, St. Paul, Minn. and have placed irons at the corners as shown, and the same is correct.

There is no low wet ground nor any traveled road or easement on or across same, except as shown.

T. J. Welch
Minn. Registered Land Surveyor, Certificate No. 555.

State of Minnesota } On this 13 day of March A.D. 1939 before me the
County of Ramsey } undersigned personally appeared T. J. Welch,
to me well known to be the person described in and who acknowledged that he
executed the foregoing certificate as his own free act and deed.

Mark W. Woodruff
Notary Public, Ramsey Co., Minn.
My Commission expires, MARK W. WOODRUFF, Notary Public, Ramsey County, Minn. My Commission expires April 26, 1942.

This is to certify that Edmund O. Dregni, single proprietor of that portion of Lot 32, Franklin Steele's Subdivision of Lot 2, Section 21, Township 28, Range 23, lying east of a straight line drawn along the West line of Lot 24 Franklin Steele's Subdivision extended to the Mississippi River, has caused the same to be platted and hereafter known as Fort Snelling View, St. Paul, Minn. as shown on this plat and hereby dedicates to the public for public use forever, all the streets and avenues as hereon indicated.

Witness my hand and seal this 25 day of April 1939.

In presence of
James A. ... } Edmund O. Dregni
Edmund O. Dregni

State of Minnesota } On this 25 day of April A.D. 1939 before
County of Hennepin } me the undersigned personally appeared, Edmund
O. Dregni, to me well known and acknowledged that he executed the
foregoing certificate as his own free act and deed.

Joseph B. Pinger
Notary Public, Hennepin Co., Minn.
My Commission expires, JOSEPH B. PINGER, Notary Public, Hennepin County, Minn. My Commission Expires Dec. 13, 1942.

Accepted and approved this 8 day of May A.D. 1939.

Mark W. Woodruff } (Plat
Joseph B. Pinger } Commissioners
Milton Kouss } Commissioner of Public Works.

Accepted by the Council, May 9th 1939 -
Approved, May 9th 1939 -
D. R. Ferguson
City Clerk.

All taxes due on this property are paid
MAY 10 1939
DEPARTMENT OF FINANCE
JOHN J. DEAR, CHIEF FINANCE

Taxes for the year 1938 on the lands described within PAID
MAY 10 1939
ELSA M. OBST, Treasurer
RAMSEY COUNTY, MINN.

TAXES PAID AND TRANSFER ENTERED
MAY 10 1939
EUGENE H. ...
RAMSEY COUNTY, MINN.

STATE OF MINNESOTA } ss.
County of Ramsey }
Office of the Register of Deeds
This is to certify that the within instrument was filed for record in this office at St. Paul on the 10 day of May A. D., 1939, at 12 o'clock P. M. and that the same was duly recorded in Book 52 of Plats page 16.
By: J. J. ... Register of Deeds.
Deputy.

947220