


BAUERSCHMIDT'S ADDITION.

ST. PAUL, MINN.

scale 1 inch = 50 feet.
o indicates iron.

William F. Brettschneider, Reg. Surveyor.

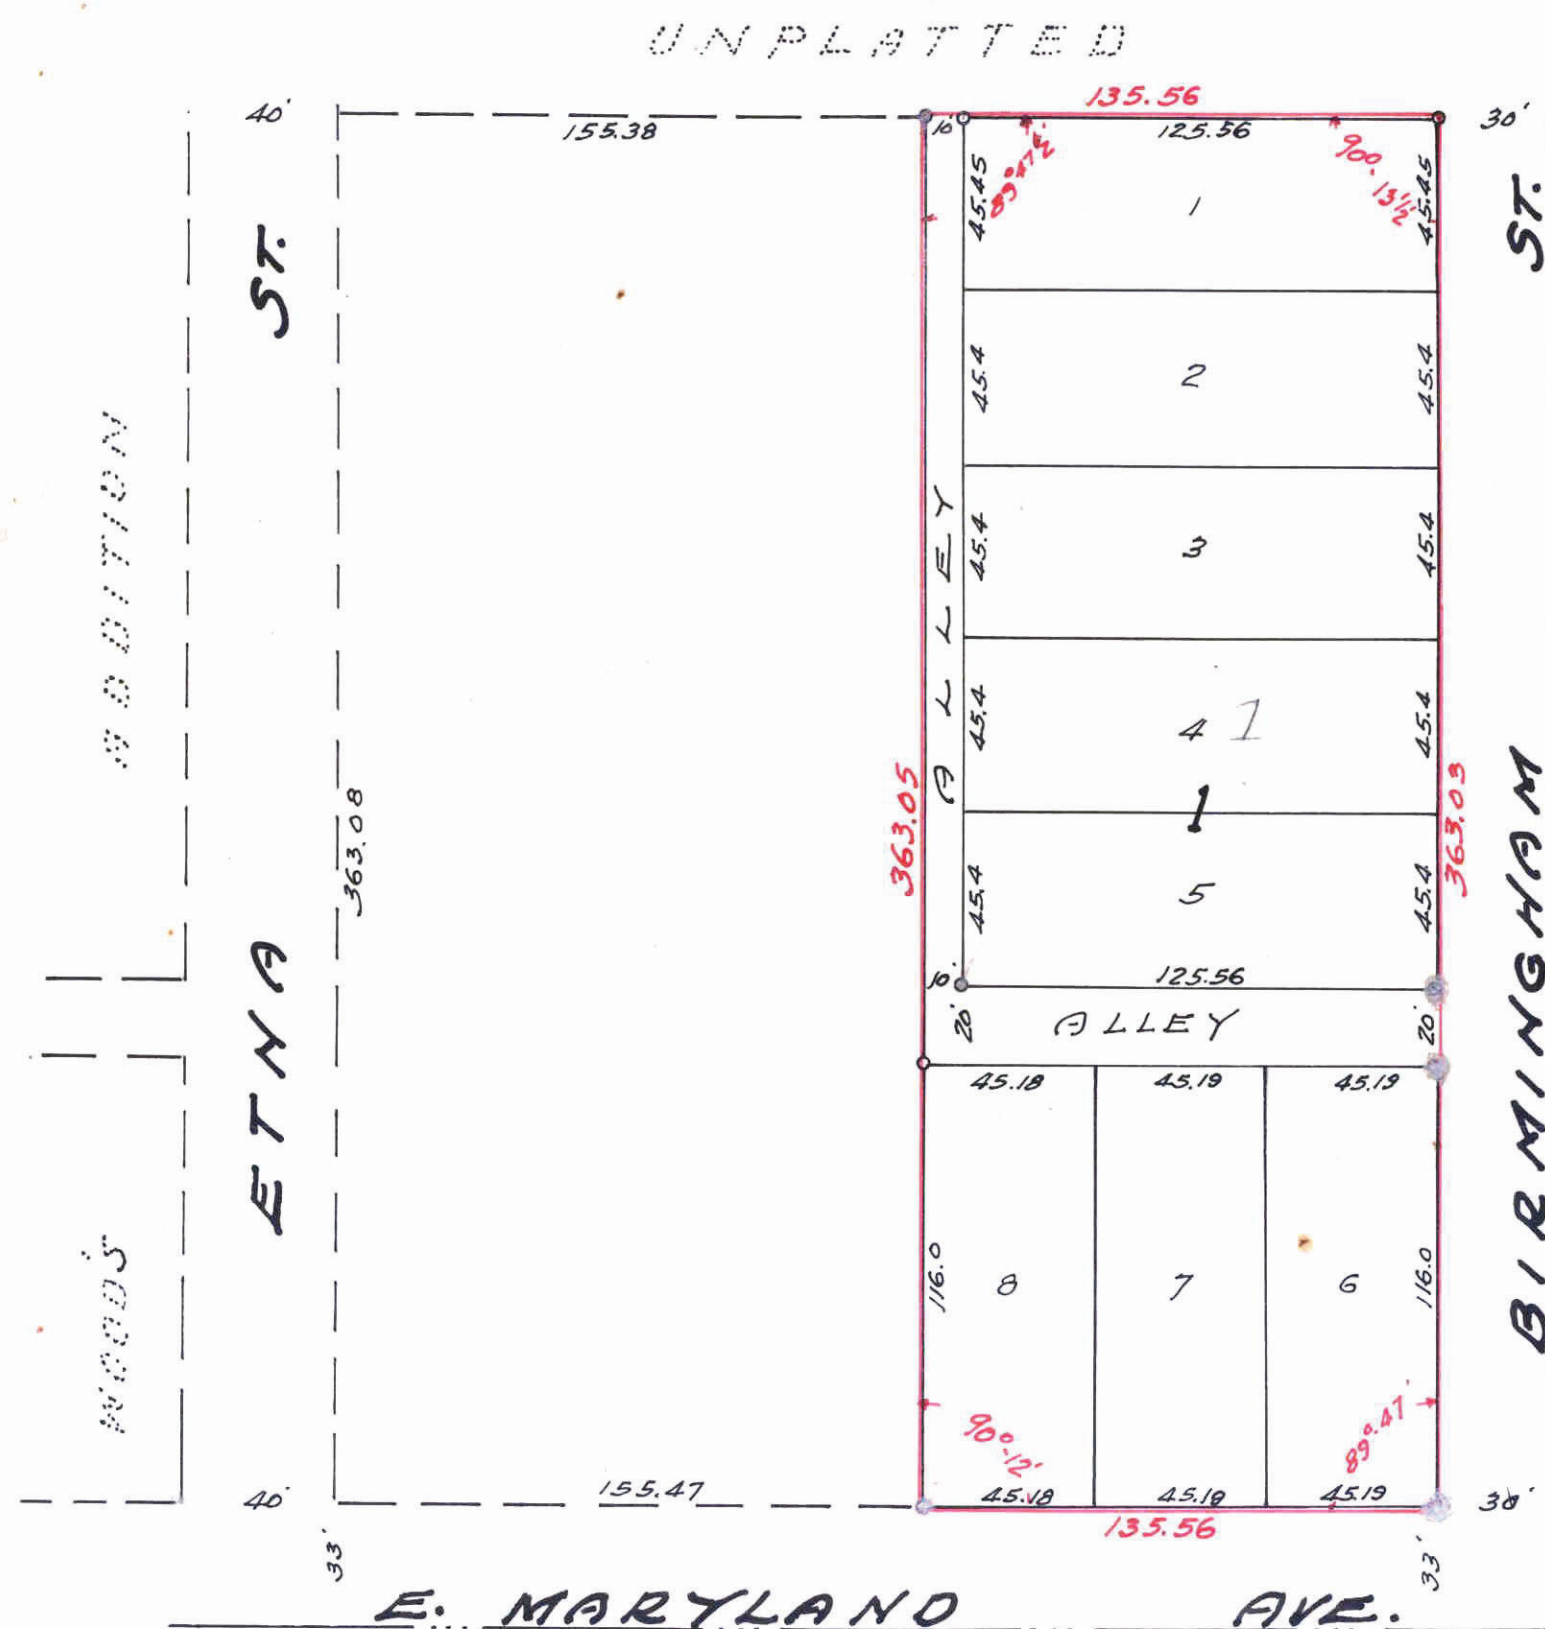

I hereby certify to having surveyed the property described on this plat as Bauerschmidt's Addition, St. Paul, Minn. and have placed irons at the corners as shown and the same is correct. There is no low wet ground nor any traveled road or easement on or across same except as shown.

William F. Brettschneider
Registered Surveyor No. 931

State of Minnesota }
County of Ramsey }

On this 14th day of *May* A.D. 1947, before me personally appeared *William F. Brettschneider* to me well known and acknowledged that he executed the foregoing certificate as his own free act and deed.

ROY A. ERICKSON,
Notary Public, Ramsey County, Minn.
My Commission Expires June 2, 1947.

Roy A. Erickson
Notary Public, Ramsey County, Minnesota.
My Commission Expires _____

This is to certify that we *John Bauerschmidt, and Mary Bauerschmidt, husband and wife*, owners of The East 169.56 feet of the South 3/4 of the East 1/2 of the South-east 1/4 of the Southwest 1/4 of the Southwest 1/4 of Section 22, Township 29, North Range 22 West, except the East 30 feet and the South 33 feet for streets, have caused the same to be surveyed and platted and hereafter known as *Bauerschmidt's Addition, St. Paul, Minnesota*, as shown by this plat, and hereby dedicate to the public and for the public use forever all streets, avenues, alleys, parks, and boulevards as shown.

Witness our hands and seals this 14th day of *May* 1947.

In presence of

John Bauerschmidt
Mary Bauerschmidt
Ethel M. Erickson

State of Minnesota }
County of Ramsey }

On this 14th day of *May* A.D. 1947, before me the undersigned personally appeared *John Bauerschmidt and Mary Bauerschmidt, husband and wife*, to me known to be the persons described in and who executed the foregoing instrument and acknowledged that they executed the same as their free act and deed.

ROY A. ERICKSON,
Notary Public, Ramsey County, Minn.
My Commission Expires June 2, 1947.

Roy A. Erickson
Notary Public, Ramsey County, Minnesota.
My Commission Expires _____

Taxes for the year 1946 on the lands described herein PAID
JUN 6 1947
ELSA M. ORST, Treasurer
RAMSEY COUNTY, MINN.

TAXES PAID AND TRANSFER ENTRIES
JUN 6 - 1947
EUGENE A. MONICK, Auditor
RAMSEY COUNTY, MINN.

All Installments of Assessments due on the within property to date are paid
JUN 6 - 1947
DEPARTMENT OF FINANCE
ST. PAUL, MINN.
JOHN S. FORDAN, COM'R. FINANCE
By *[Signature]*

This plat document is an UNOFFICIAL copy of a Subdivision Plat or Registered Land Survey and is made available for information purposes only.
To obtain an official copy please contact the Ramsey County Recorder's Office.

STATE OF MINNESOTA 188.
County of Ramsey
Office of the Register of Deeds
This is to certify that the within instrument was filed for record in this office at St. Paul on the 9 day of *June* A. D. 1947, at 10:20 o'clock A.M., and that the same was duly recorded in Book *547* of *House Files* Page *115*
By *[Signature]* Register of Deeds
Deputy

Accepted and approved this 4th day of *June* 1947.

George W. Howard
Herbert West
William W. Cooper
James A. Peterson
Plat Commission
Commissioner of Public Works.

Accepted by the Council *June 5* 1947.

Approved *June 5* 1947.
[Signature]
City Clerk.

Accepted and approved by the St. Paul City Planning Board
Secretary.

1220511