


MARTIN & LIENAU'S
REARRANGEMENT OF BLOCK 32 OF
BROWN & JACKSON'S ADDITION
WEST SAINT PAUL.

ST.
ANDREW
ST.
HOYT

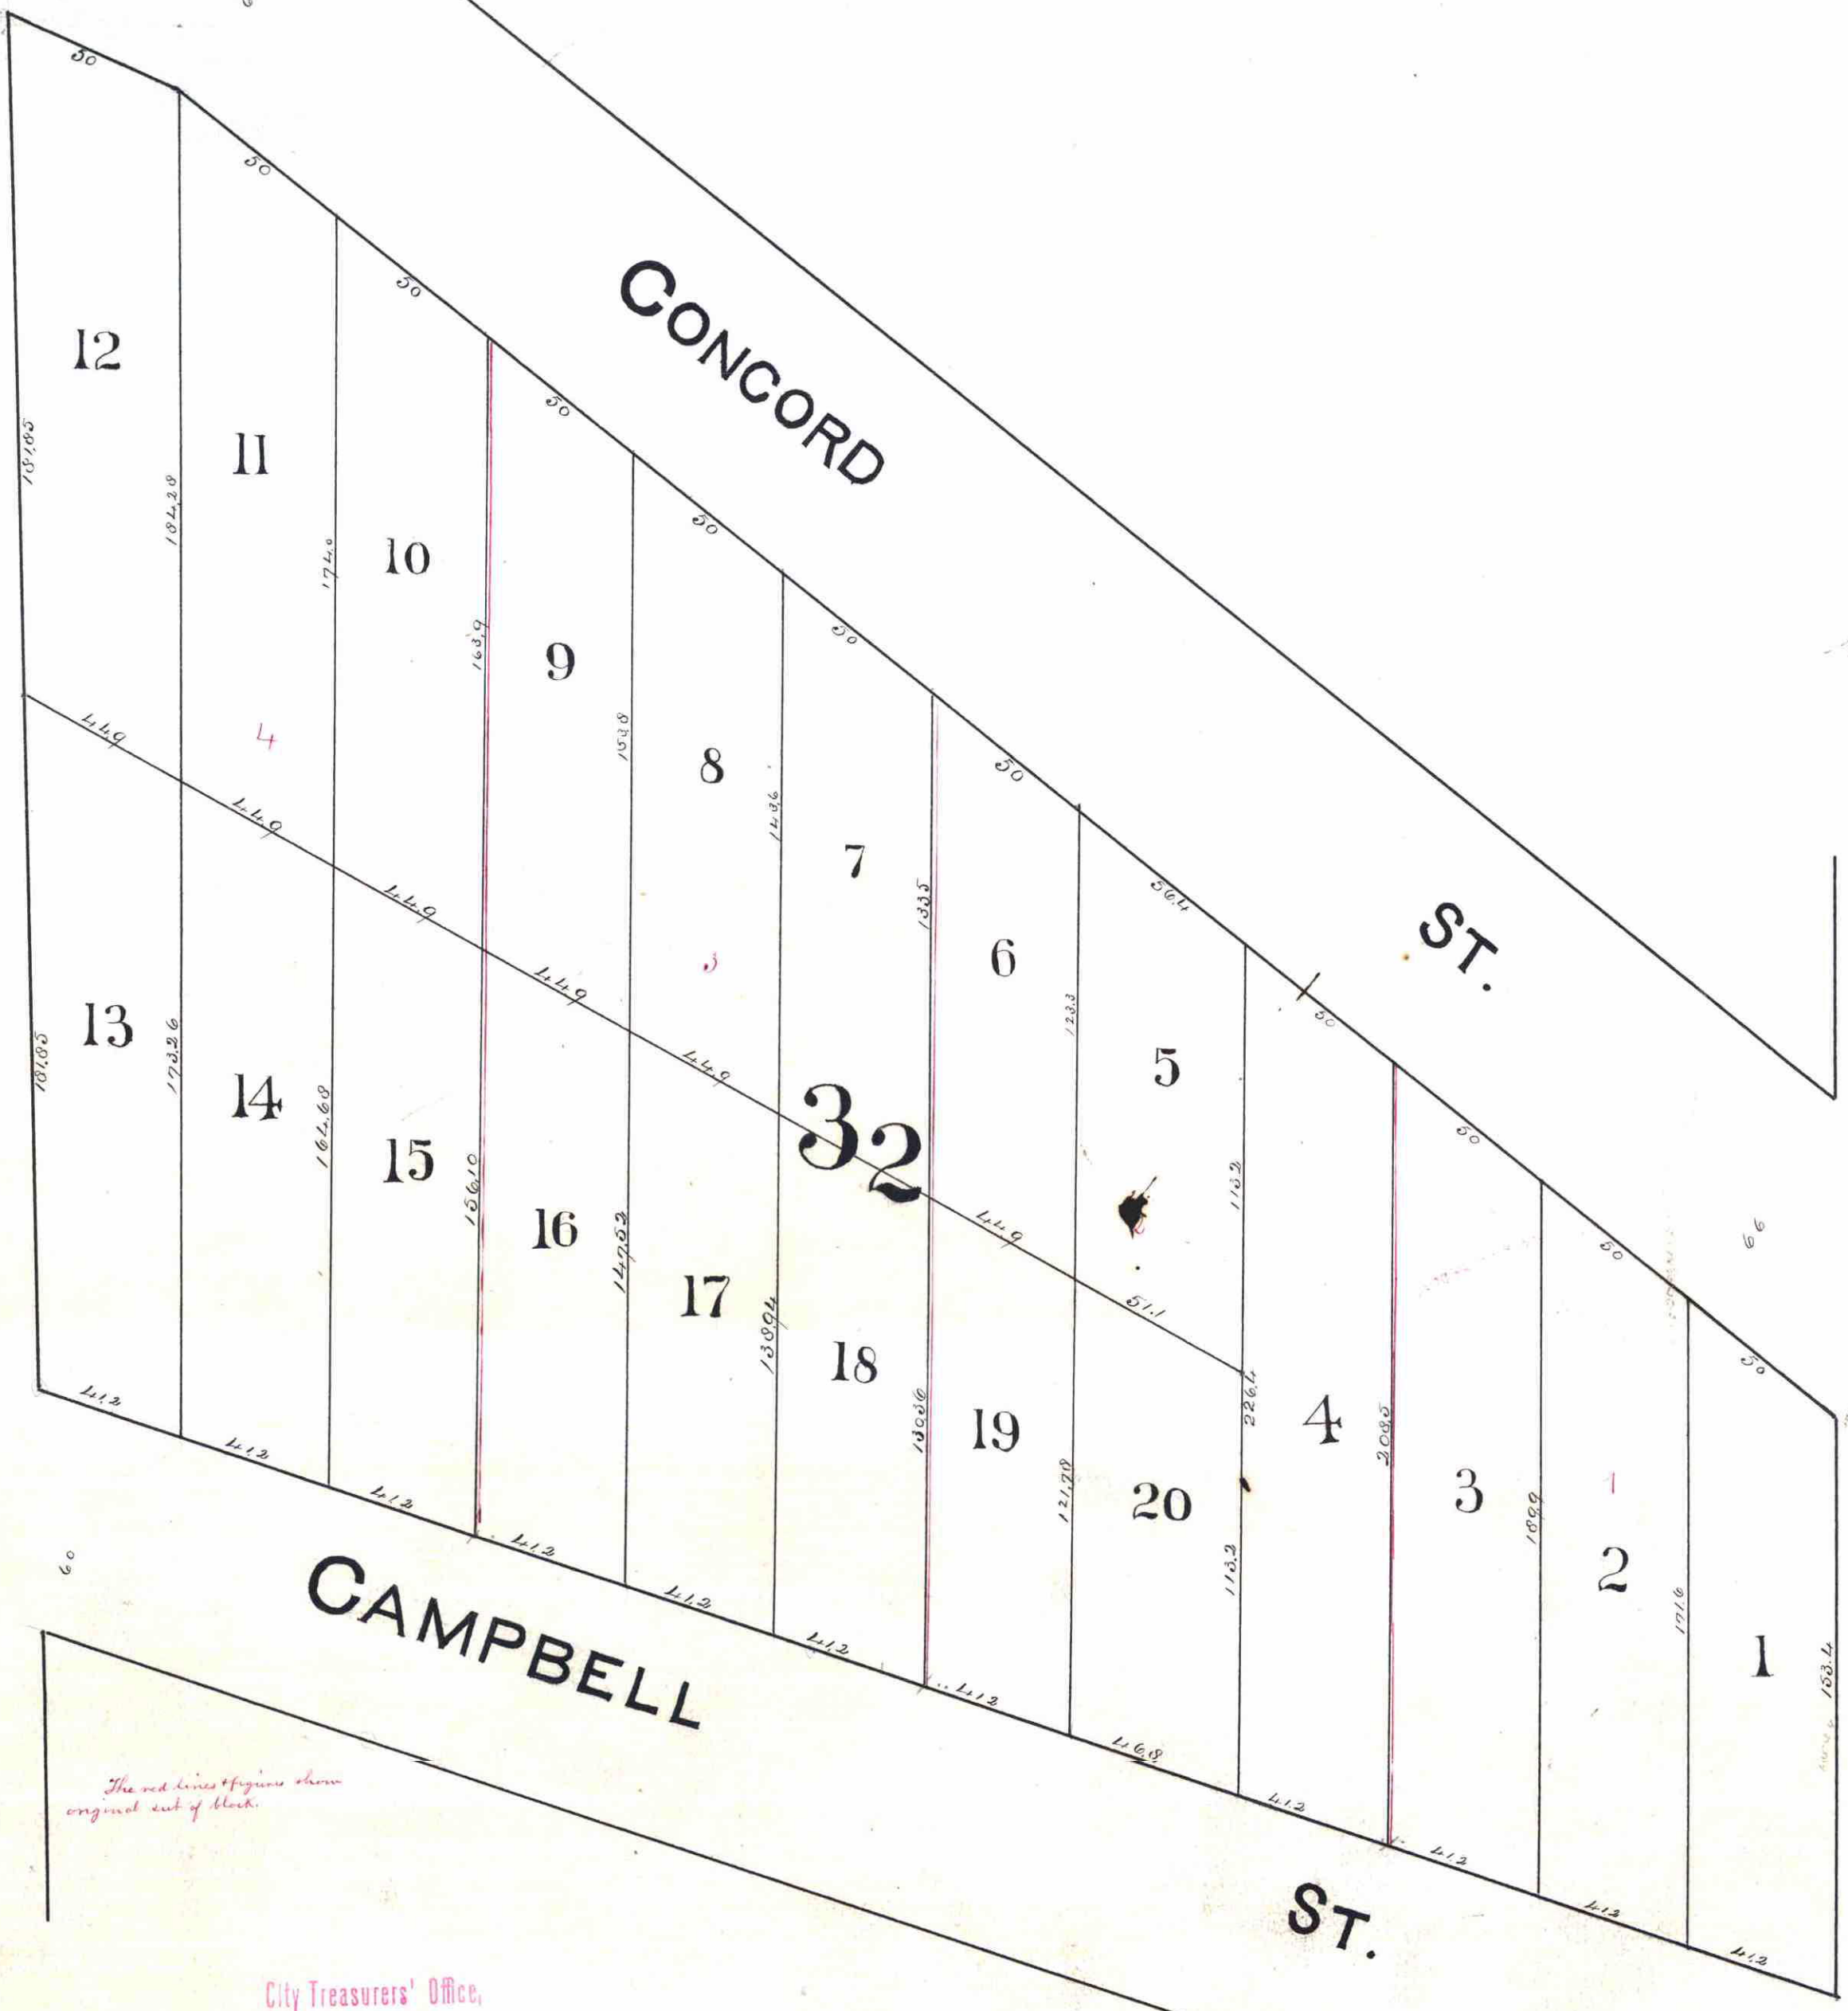

I hereby certify to having surveyed and platted the property described on this map as The Martin and Lienau's Rearrangement of Block 32 of Brown and Jackson's addition to West Saint Paul, Minnesota and have placed iron monuments at the corners as shown on this map, and the same is correct.
J. B. Hawley,
Surveyor.

I hereby certify to having examined this map or plat and recommend its approval.
W. A. Davis
City Engineer.

Approved this 22nd day of Oct^r 1883
S. A. Johnson
Jas. Starkey
Wm. A. Vanlyke
Not Commission

Accepted by the Common Council on the 2nd day of January 1884
City of West Saint Paul

The red lines of figures show original cut of block.

City Treasurers' Office,
ST. PAUL, MINN.
JAN 16 1884
ASSESSMENT PAID.
Shoemaker

We C. H. Lienau President and C. B. Bryant Secretary of the West Side Land and Cottage Company of Saint Paul Minnesota, a corporation duly organized and incorporated under the laws of the state of Minnesota, the owner of Block 32 of Brown and Jackson's Addition to West Saint Paul do hereby certify to having caused the same to be surveyed and platted as Martin and Lienau's Rearrangement of Block 32 of Brown and Jackson's Addition to West Saint Paul Minnesota as herein and hereon indicated.

In witness whereof we have hereunto set our hands and seals this 18th day of October 1883
In the presence of
Chas. W. Spiel
Henry B. Finmore
By C. H. Lienau President
C. B. Bryant Secretary

Be it known that on this 18th day of October A.D. 1883, personally came before me C. H. Lienau, President and C. B. Bryant Secretary of the West Side Land and Cottage Company to me personally known to be the President and Secretary of said Corporation described in and who executed the foregoing instrument, and acknowledged that they executed the same freely and voluntarily and as the act and deed of said Corporation, and that the Corporate seal hereunto affixed is the Corporate seal of the said West Side Land and Cottage Company.

Chas. W. Spiel
Notary Public
Ramsey County
Minnesota

Filed for transfer entered this
16th day of January 1884
J. J. McCurdy
Clerk

STATE OF MINNESOTA,
County of Ramsey,
OFFICE OF THE REGISTER OF DEEDS.
This is to certify that the within instrument was filed for record in my office, at St. Paul, on the 16th day of January, A. D. 1884, and is duly recorded in Book 22 of Town Plat page 6
R. W. Miller
Register of Deeds.
By _____ Deputy.