


# FOOSHE'S EAST HOME ADDITION No. 3.

SAINT PAUL, MINN.

HAROLD PURTELL, REG. ENGINEER.

SCALE 1" = 60'  
O INDICATES IRON

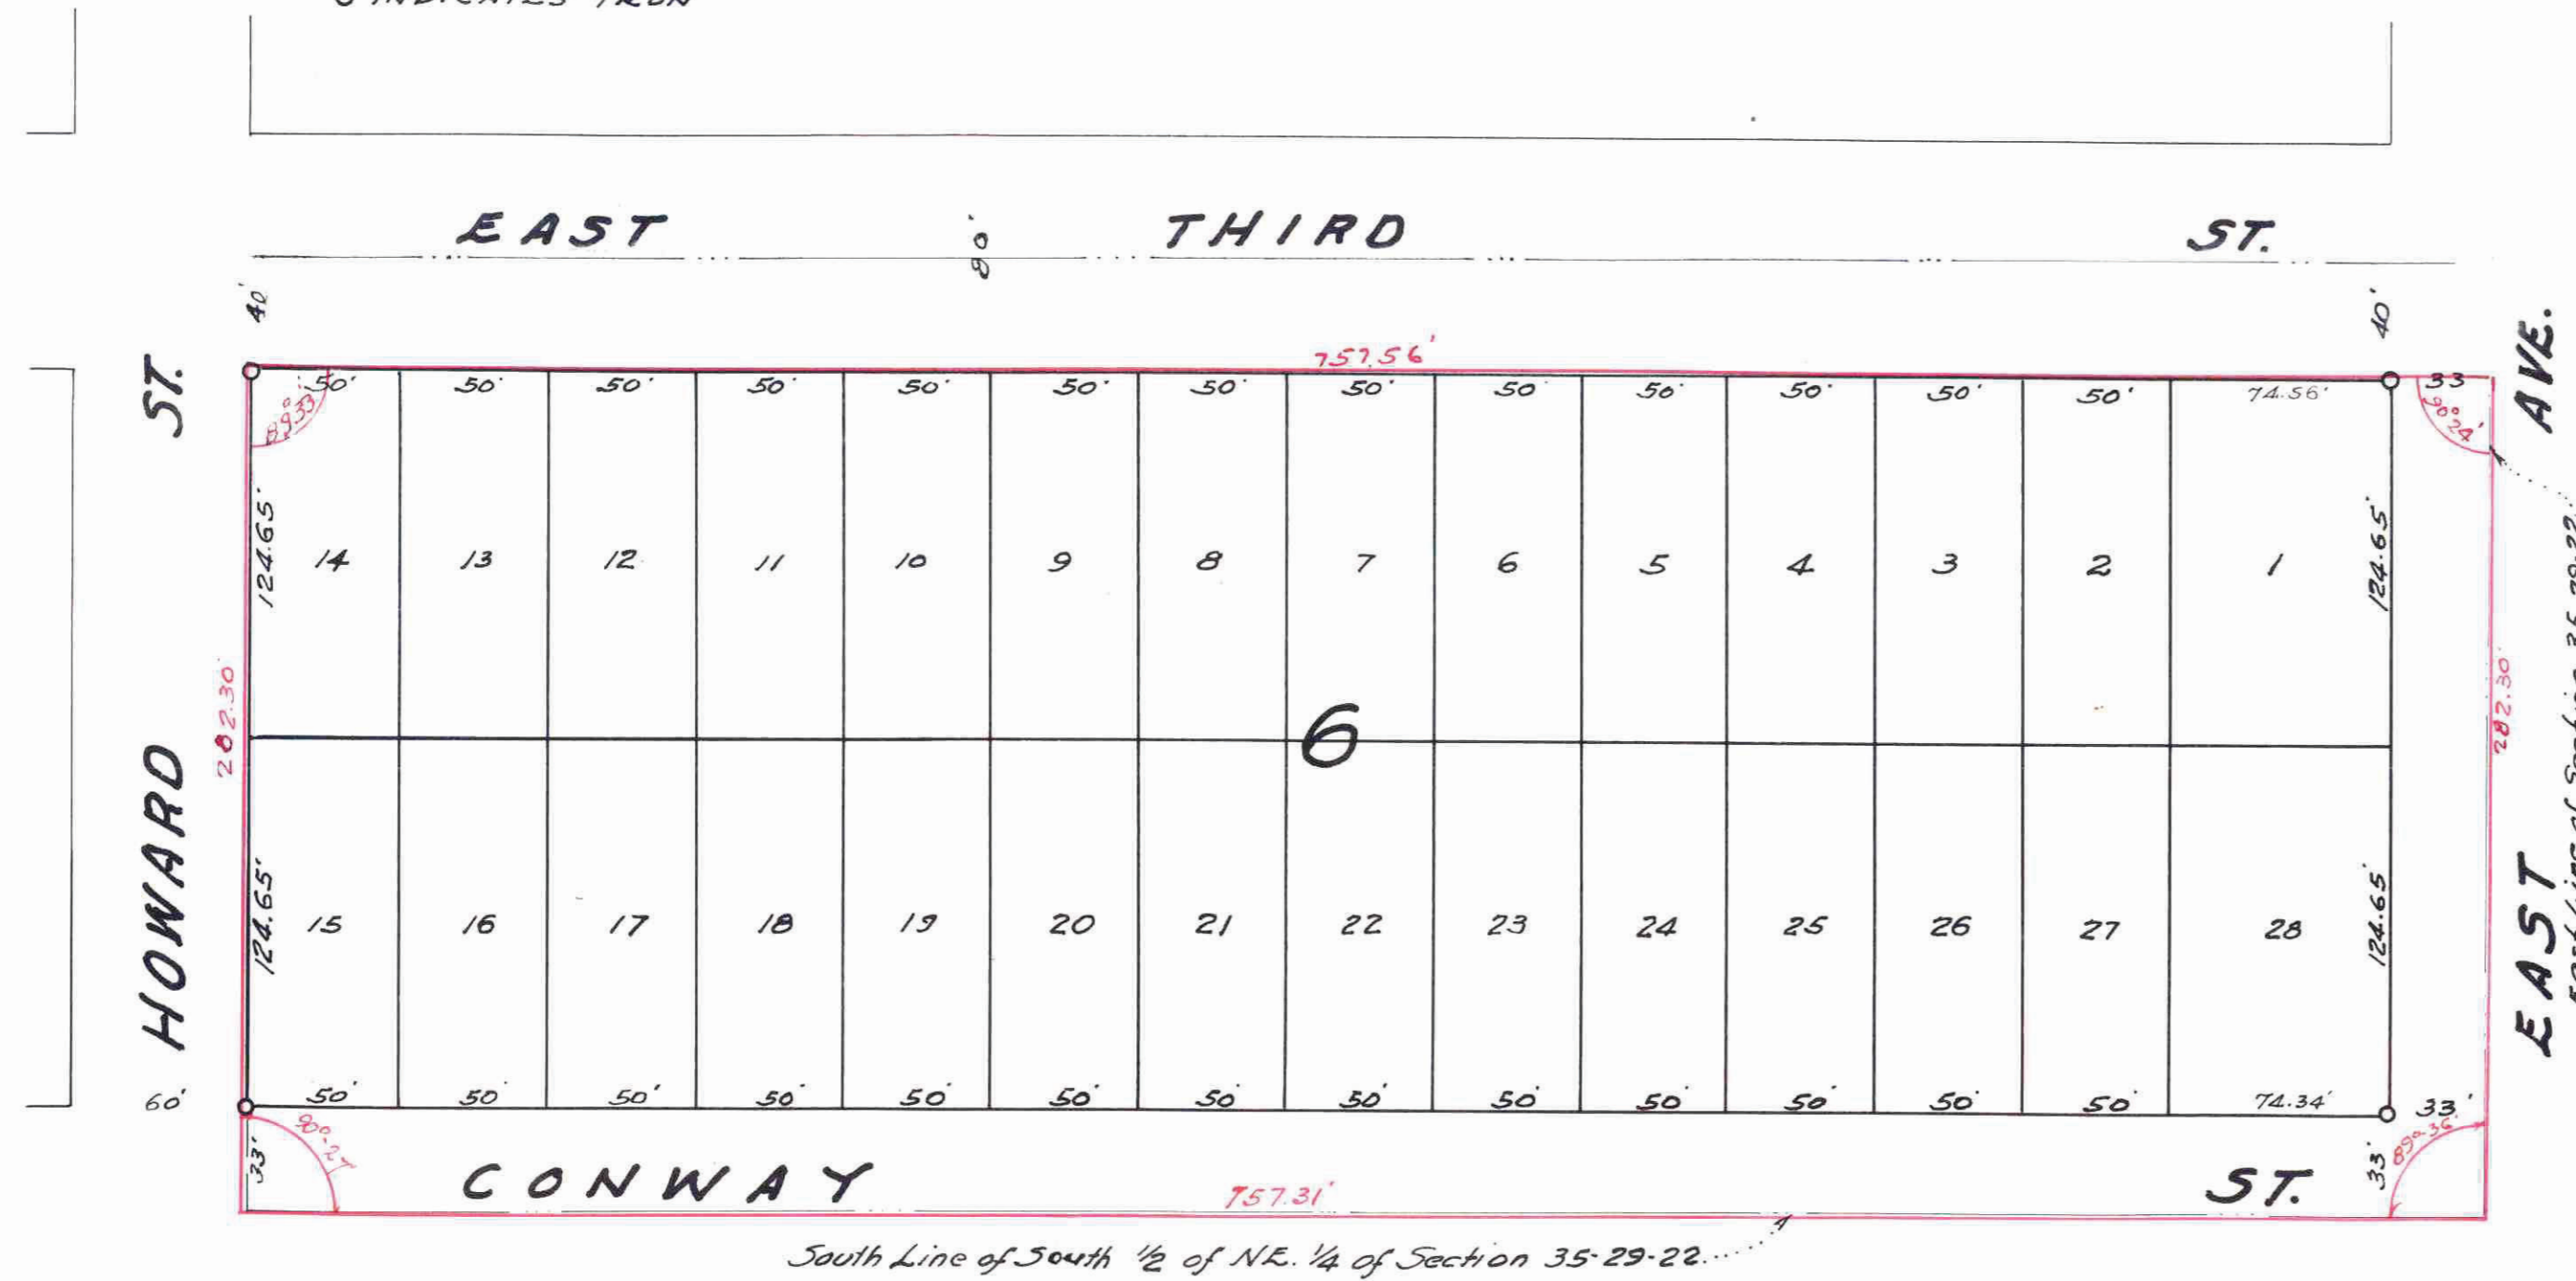

I hereby certify to having surveyed the property described on this plat as Fooshe's East Home Addition No. 3, and have placed iron at the corners as shown and the same is correct. There is no low wet ground nor any traveled road on or across same except as shown.

*H. Purcell*  
Registered Engineer & Land Surveyor  
Minnesota Certificate No. 1203.

State of Minnesota } s.s.  
County of Ramsey }

On this 21 day of June, A.D. 1950 before me the undersigned personally appeared H. T. Purcell to me known to be the person described in and who executed the foregoing instrument and acknowledged that he executed the same as his free act and deed.

*Gladys M. Aufenast*  
Notary Public, Ramsey County, Minnesota  
My commission expires Nov. 20, 1950

This is to certify that we Peter E. Fooshe and Katherine V. Fooshe husband and wife, and Louis V. Sauer and Elise Kummer Sauer, husband and wife, owners of, All that part of the Northeast quarter (NE 1/4) Section thirty-five (35), Township twenty-nine (29), Range twenty-two (22), lying South of Third Street and East of Howard Street, have caused the same to be surveyed and platted and hereafter known as Fooshe's East Home Addition No. 3, as shown on this plat and hereby dedicate to the public and for public use forever, all streets and avenues as shown.

Witness our hands and seal this 21 day of June, A.D. 1950.

In presence of

*Gladys M. Aufenast* Katherine V. Fooshe  
*Harry W. Nelson* Louis V. Sauer  
Elise Kummer Sauer

State of Minnesota } s.s.  
County of Ramsey }

On this 21 day of June, A.D. 1950 before me the undersigned personally appeared Peter E. Fooshe, Katherine Fooshe, Louis V. Sauer, Elise Kummer Sauer, to me known to be the persons described in and who executed the foregoing instrument and acknowledged that they executed the same as their free act and deed.

*Gladys M. Aufenast*  
Notary Public, Ramsey County, Minnesota  
My commission expires Nov. 20, 1950

GLADYS M. AUFENAST  
Notary Public, Ramsey County, Minn.  
My commission expires Nov. 20, 1950

Accepted and approved this 21<sup>st</sup> day of June, A.D. 1950.

George W. Herrold  
Herbert J. West } Plat Commissioners.  
Abner J. Crampton  
Milton P. ... Commissioner of Public Works.

Accepted by the Council June 22, A.D. 1950.

Approved June 22, A.D. 1950.  
H. T. Purcell  
City Clerk.

All installments of Assessments due on the within property to date are paid  
JUN 23 1950  
DEPARTMENT OF FINANCE  
ST. PAUL, MINN.  
PAT. ...  
By *A. J. ...*

Taxes for the year 1949 on the lands described herein PAID  
JUN 23 1950  
M. OPST, Treasurer  
RAMSEY COUNTY, MINNESOTA

TAXES PAID AND TRANSFER ENTERED  
JUN 23 1950  
EUGENE A. MONICK, Auditor  
RAMSEY COUNTY, MINN.  
By *T. C. Rhodes*

This plat document is an UNOFFICIAL copy of a Subdivision Plat or Registered Land Survey and is made available for information purposes only.  
To obtain an official copy please contact the Ramsey County Recorder's Office.

DOCUMENT NUMBER 280981  
CERTIFICATE NUMBER 126408  
BOOK 314 PAGE 106  
STATE OF MINNESOTA } s.s.  
County of Ramsey }  
OFFICE OF THE REGISTRAR OF TITLES  
This is to certify that on an instrument recorded in the office at St. Paul on the 21 day of June, A.D. 1950 at 10:00 o'clock A.M.  
*R. Bernhard*  
Registrar of Titles

280981