

DONNAY-REITZ ADDITION

SAINT PAUL, MINN. 1234865

T. J. WELCH, REGISTERED SURVEYOR.

SCALE 1" = 50'
● INDICATES IRON.



I hereby certify to having surveyed the property described on this plat as Donnay-Reitz Addition and have placed iron monuments at the corners as shown and the same is correct.
There is no low wet ground nor any traveled road or easement on or across same except as shown.

T. J. Welch
Registered Surveyor
Minnesota Certificate No. 555.

State of Minnesota) s.s.
County of Ramsey)

On this 21 day of June A.D. 1950, before me the undersigned, personally appeared T. J. Welch, to me known to be the person described in and who executed the foregoing instrument and acknowledged that he executed the same as his free act and deed.

Raymond J. Rookstrom
Notary Public, Ramsey County, Minnesota
My commission expires April 15 1952

RAYMOND J. ROOKSTROM,
Notary Public, Ramsey County, Minn.,
My Commission Expires Apr 15, 1952

This is to certify that Donnay-Reitz, Inc. owners of Lots 1-2-3-26-27 and 28, Block 3, and Lots 1-2-3-26-27 and 28, Block 4, all in Fairview South Addition and all that part of vacated alleys and Sedan Street which accrued to the above lots have caused the same to be surveyed and platted and hereafter known as Donnay-Reitz Addition, and hereby dedicate to the public and for the public use forever all Streets and Avenues, alleys as shown.

Witness our hands and seal this 5th day of July A.D. 1950.

All Installments of Assessments due on the within property to date are paid
JUL 12 1950
DEPARTMENT OF FINANCE
ST. PAUL, MINN.
PATE, HODERICK, Com' Finance
By J. J. Gahan

In presence of
J. J. Kane

Martin H. Reitz
President

Alie Beuerman
George A. Donnay
Secretary

Taxes for the year 1949 on the lands described herein PAID
JUL 12 1950
EUGENE A. MONICK, Auditor
RAMSEY COUNTY, MINN.
By J. C. Rhoads

State of Minnesota) s.s.
County of Ramsey)


On this 5th day of July A.D. 1950, before me appeared Martin H. Reitz, and George A. Donnay, who each being duly sworn did say that they are respectively the President and Secretary of Donnay-Reitz, Inc. a Minnesota Corporation, the corporation named in the foregoing instrument and the seal affixed to same instrument is the corporate seal of said corporation and that said instrument was signed and sealed in behalf of said corporation by authority of its Board of Directors, and said President and said Secretary acknowledged said instrument to be the free act and deed of said corporation.

T. J. OANE,
Notary Public, Ramsey County, Minn.
My Commission expires July 30, 1950.

J. J. Kane
Notary Public, Ramsey County, Minnesota.
My commission expires July 30, 1950

Accepted by the Council July 12 A.D. 1950.
Approved July 12 A.D. 1950.

A. T. Ormell
City Clerk

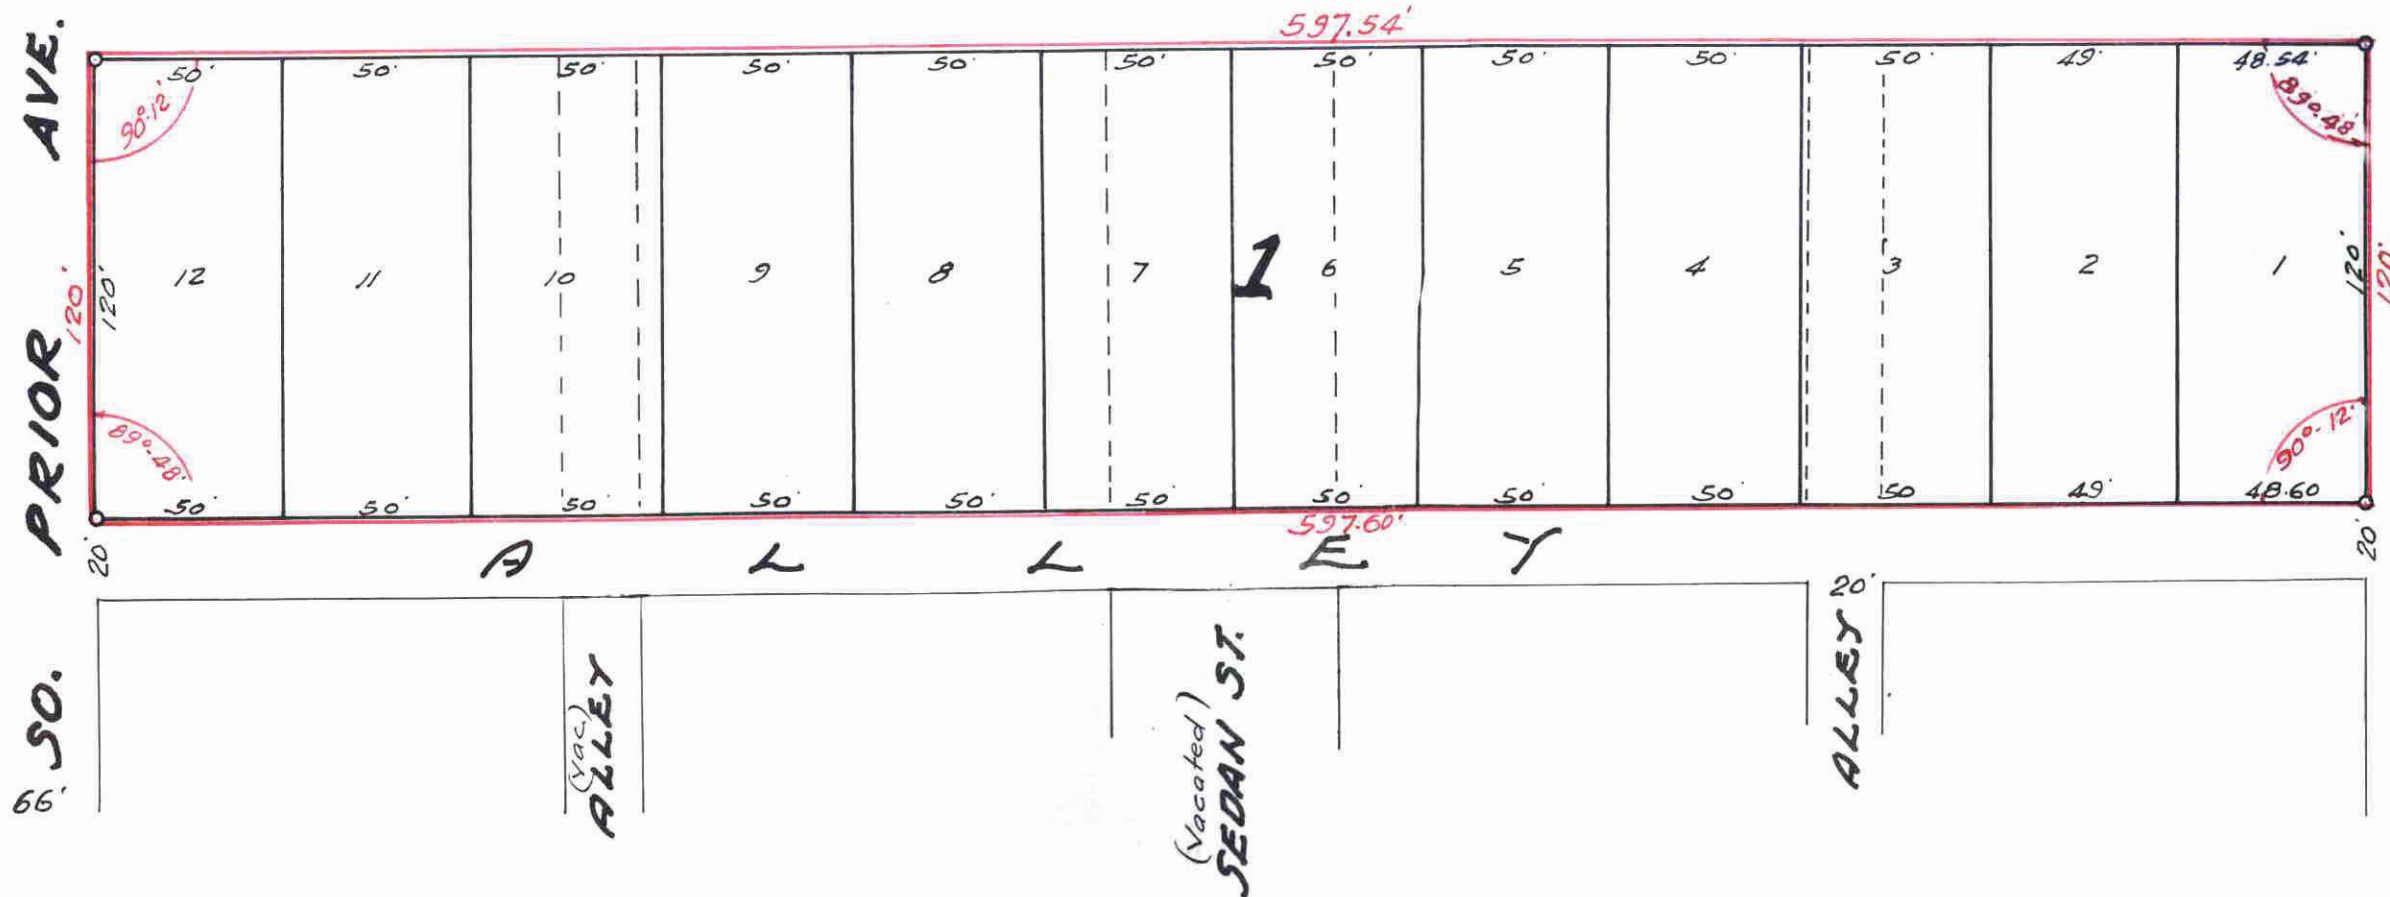

This plat document is an UNOFFICIAL copy of a Subdivision Plat or Registered Land Survey and is made available for information purposes only.
To obtain an official copy please contact the Ramsey County Recorder's Office.

STATE OF MINNESOTA) ss.
County of Ramsey)
Office of the Register of Deeds
This is to certify that the within instrument was filed for record in the office at St. Paul on the 14 day of July A. D. 1950, at 11 o'clock A. M., and that the same was duly recorded in Book 47 of Page 47
John S. Sherman
Register of Deeds
By _____ Deputy

Accepted and approved this 11th day of July A.D. 1950

Evans K. Kerner
Hubert West
Abel D. Crampton
Wilton Ruen
Plat Commission
Commissioner of Public Works.

1234865