

# DONNA'S PLAT

## ST. PAUL, MINN.

1239812

SCALE 1" = 60'

○ INDICATES IRON.



ENGINEERING SERVICE CO.  
W. G. Ramlow,  
REG. SURVEYOR & ENGR.  
Minnesota No. 1150.

I hereby certify to having surveyed the property described on this plat as Donna's Plat and have placed irons at the corners as shown and the same is correct.  
There is no low wet ground nor any traveled road or easement on or across same except as shown.

W. G. Ramlow  
REG. SURVEYOR & ENGR.  
MINNESOTA No. 1150.

State of Minnesota } ss.  
County of Ramsey }

On this 16<sup>th</sup> day of August A.D. 1950, before me the undersigned personally appeared W. G. Ramlow, to me known to be the person described in and who executed the foregoing instrument and acknowledged that he executed the same as his free act and deed.

W. G. Ramlow  
Notary Public Ramsey County, Minn.  
My commission expires \_\_\_\_\_

A. F. SOUCHERAY, Jr.  
Notary Public, Ramsey County, Minn.  
My Commission expires Aug. 7th, 1952

This is to certify that we K. W. McKee, and B. K. McKee, husband and wife, owners of the West Seven hundred sixty seven and eighty five one hundredths (767.85) feet of the South ten (10) rods of the North thirty (30) rods of the Southwest quarter (SW 1/4) of the Southwest quarter (SW 1/4) of Section sixteen (16), Township twenty eight (28), Range twenty three (23), have caused the same to be surveyed and platted and hereafter known as Donna's Plat, as shown by this plat and hereby dedicate to the Public and for public use forever, all streets, avenues, alleys, as shown, reserving to the State of Minnesota, in trust for the taxing districts concerned, all mineral and mineral rights, as provided in Section 10, Chapter 306, Laws of 1935.

Witness our hand and seal this 23<sup>rd</sup> day of SEPTEMBER, A.D. 1950.

In presence of  
Louis Tucker K. W. McKee  
Robert Elliott B. K. McKee


State of Minnesota } ss.  
County of Ramsey }

On this 23<sup>rd</sup> day of SEPTEMBER, A.D. 1950, before me the undersigned personally appeared K. W. McKee and B. K. McKee, husband and wife to me known to be the persons described in and who executed the foregoing instrument and acknowledged that they executed the same as their free act and deed.

Robert Elliott  
Notary Public, Ramsey County, Minn.  
My commission expires \_\_\_\_\_

ROBT. ELLIOTT, JR.  
Notary Public, Ramsey County, Minn.  
My Commission Expires March 29, 1953.

STATE OF MINNESOTA } ss.  
County of Ramsey }  
Office of the Register of Deeds  
This is to certify that the within instrument was filed for record in this office at St. Paul on the 13 day of September, A. D. 1950, at 10 o'clock A. M. and that the same was duly recorded in Book 611 of 1950 Page 121.  
Robert Elliott  
Register of Deeds  
By \_\_\_\_\_ Deputy

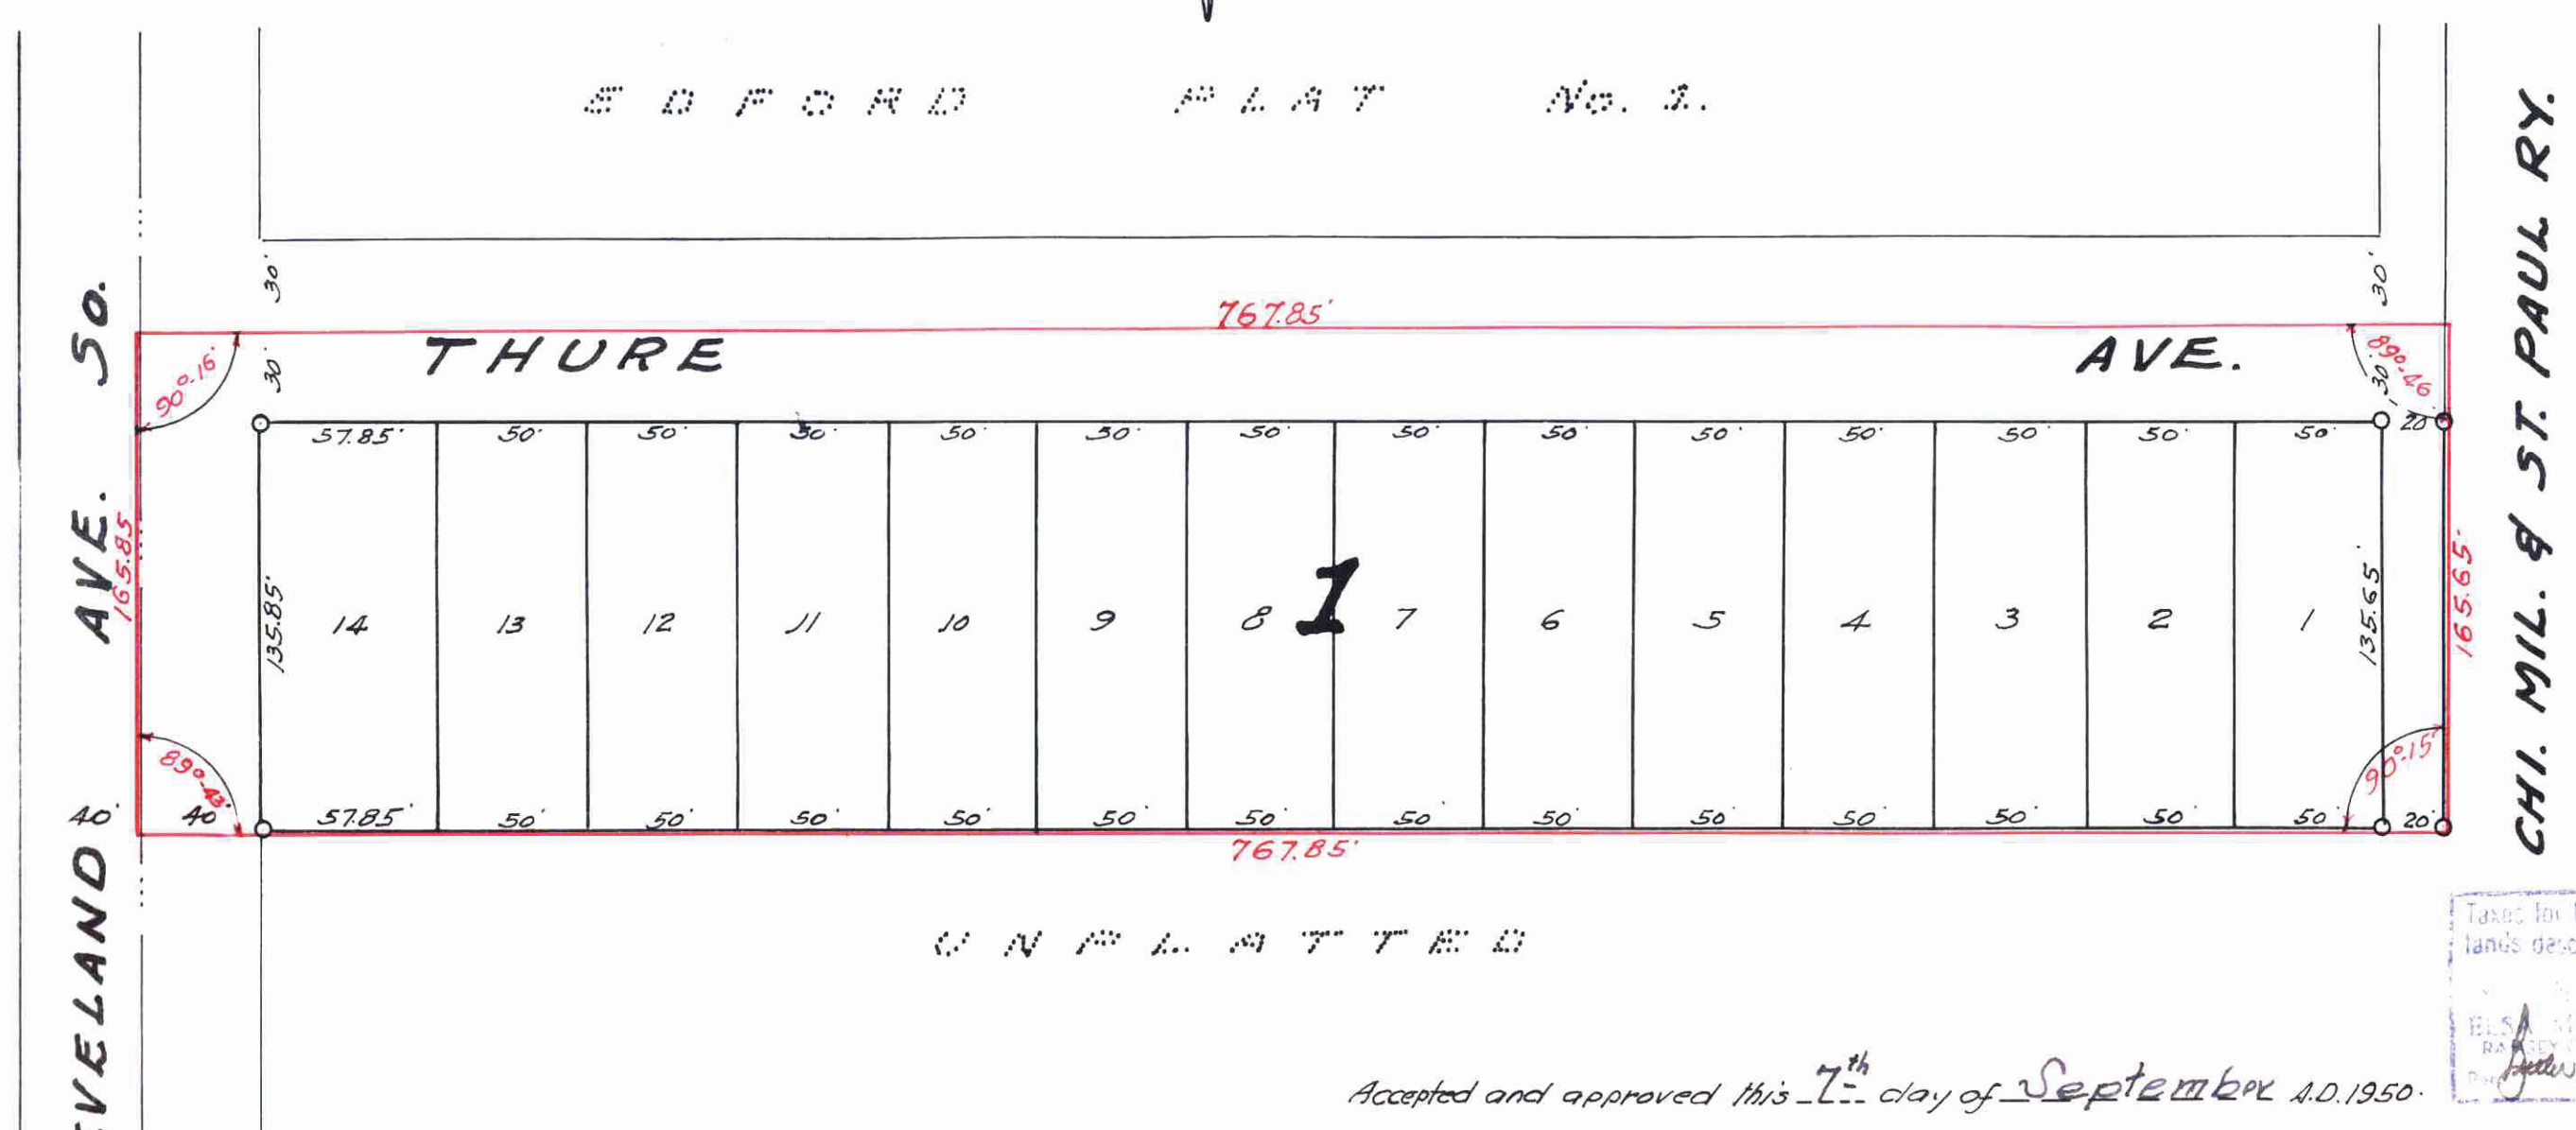

UNPLATTED


George Zimmerman  
Herbert West } Plat Commissioners.  
Alfred C. Crumpton  
Arthur Rorer } Commissioner of Public Works.

Accepted by the Council September 8, A.D. 1950.

Approved September 8, A.D. 1950.

W. J. O'Rourke  
City Clerk.

Taxes for the year 1950 on the lands described herein PAID

TAXES PAID AND TRANSFER ENTERED  
SEP 5 - 1950  
EUGENE A. MONICK, Auditor  
RAMSEY COUNTY, MINN.  
By T. C. Rhodes

All installments of Assessments due on the within property to date are paid  
SEP 11 1950  
DEPARTMENT OF FINANCE  
STATE OF MINN.  
PATE, ANDERSON & CO., Finance  
By W. G. Ramlow

This plat document is an UNOFFICIAL copy of a Subdivision Plat or Registered Land Survey and is made available for information purposes only.  
To obtain an official copy please contact the Ramsey County Recorder's Office.



1239812