


LANE - NORTON ADDITION

SAINT PAUL, MINNESOTA

BY
THE E. B. McDONOUGH CO.

See Surveyor's Certificate Doc. # 1527051
Book 1716 page 710 File No. 10353

• INDICATES IRON MONUMENT.
SCALE: 1 INCH = 100 FEET.

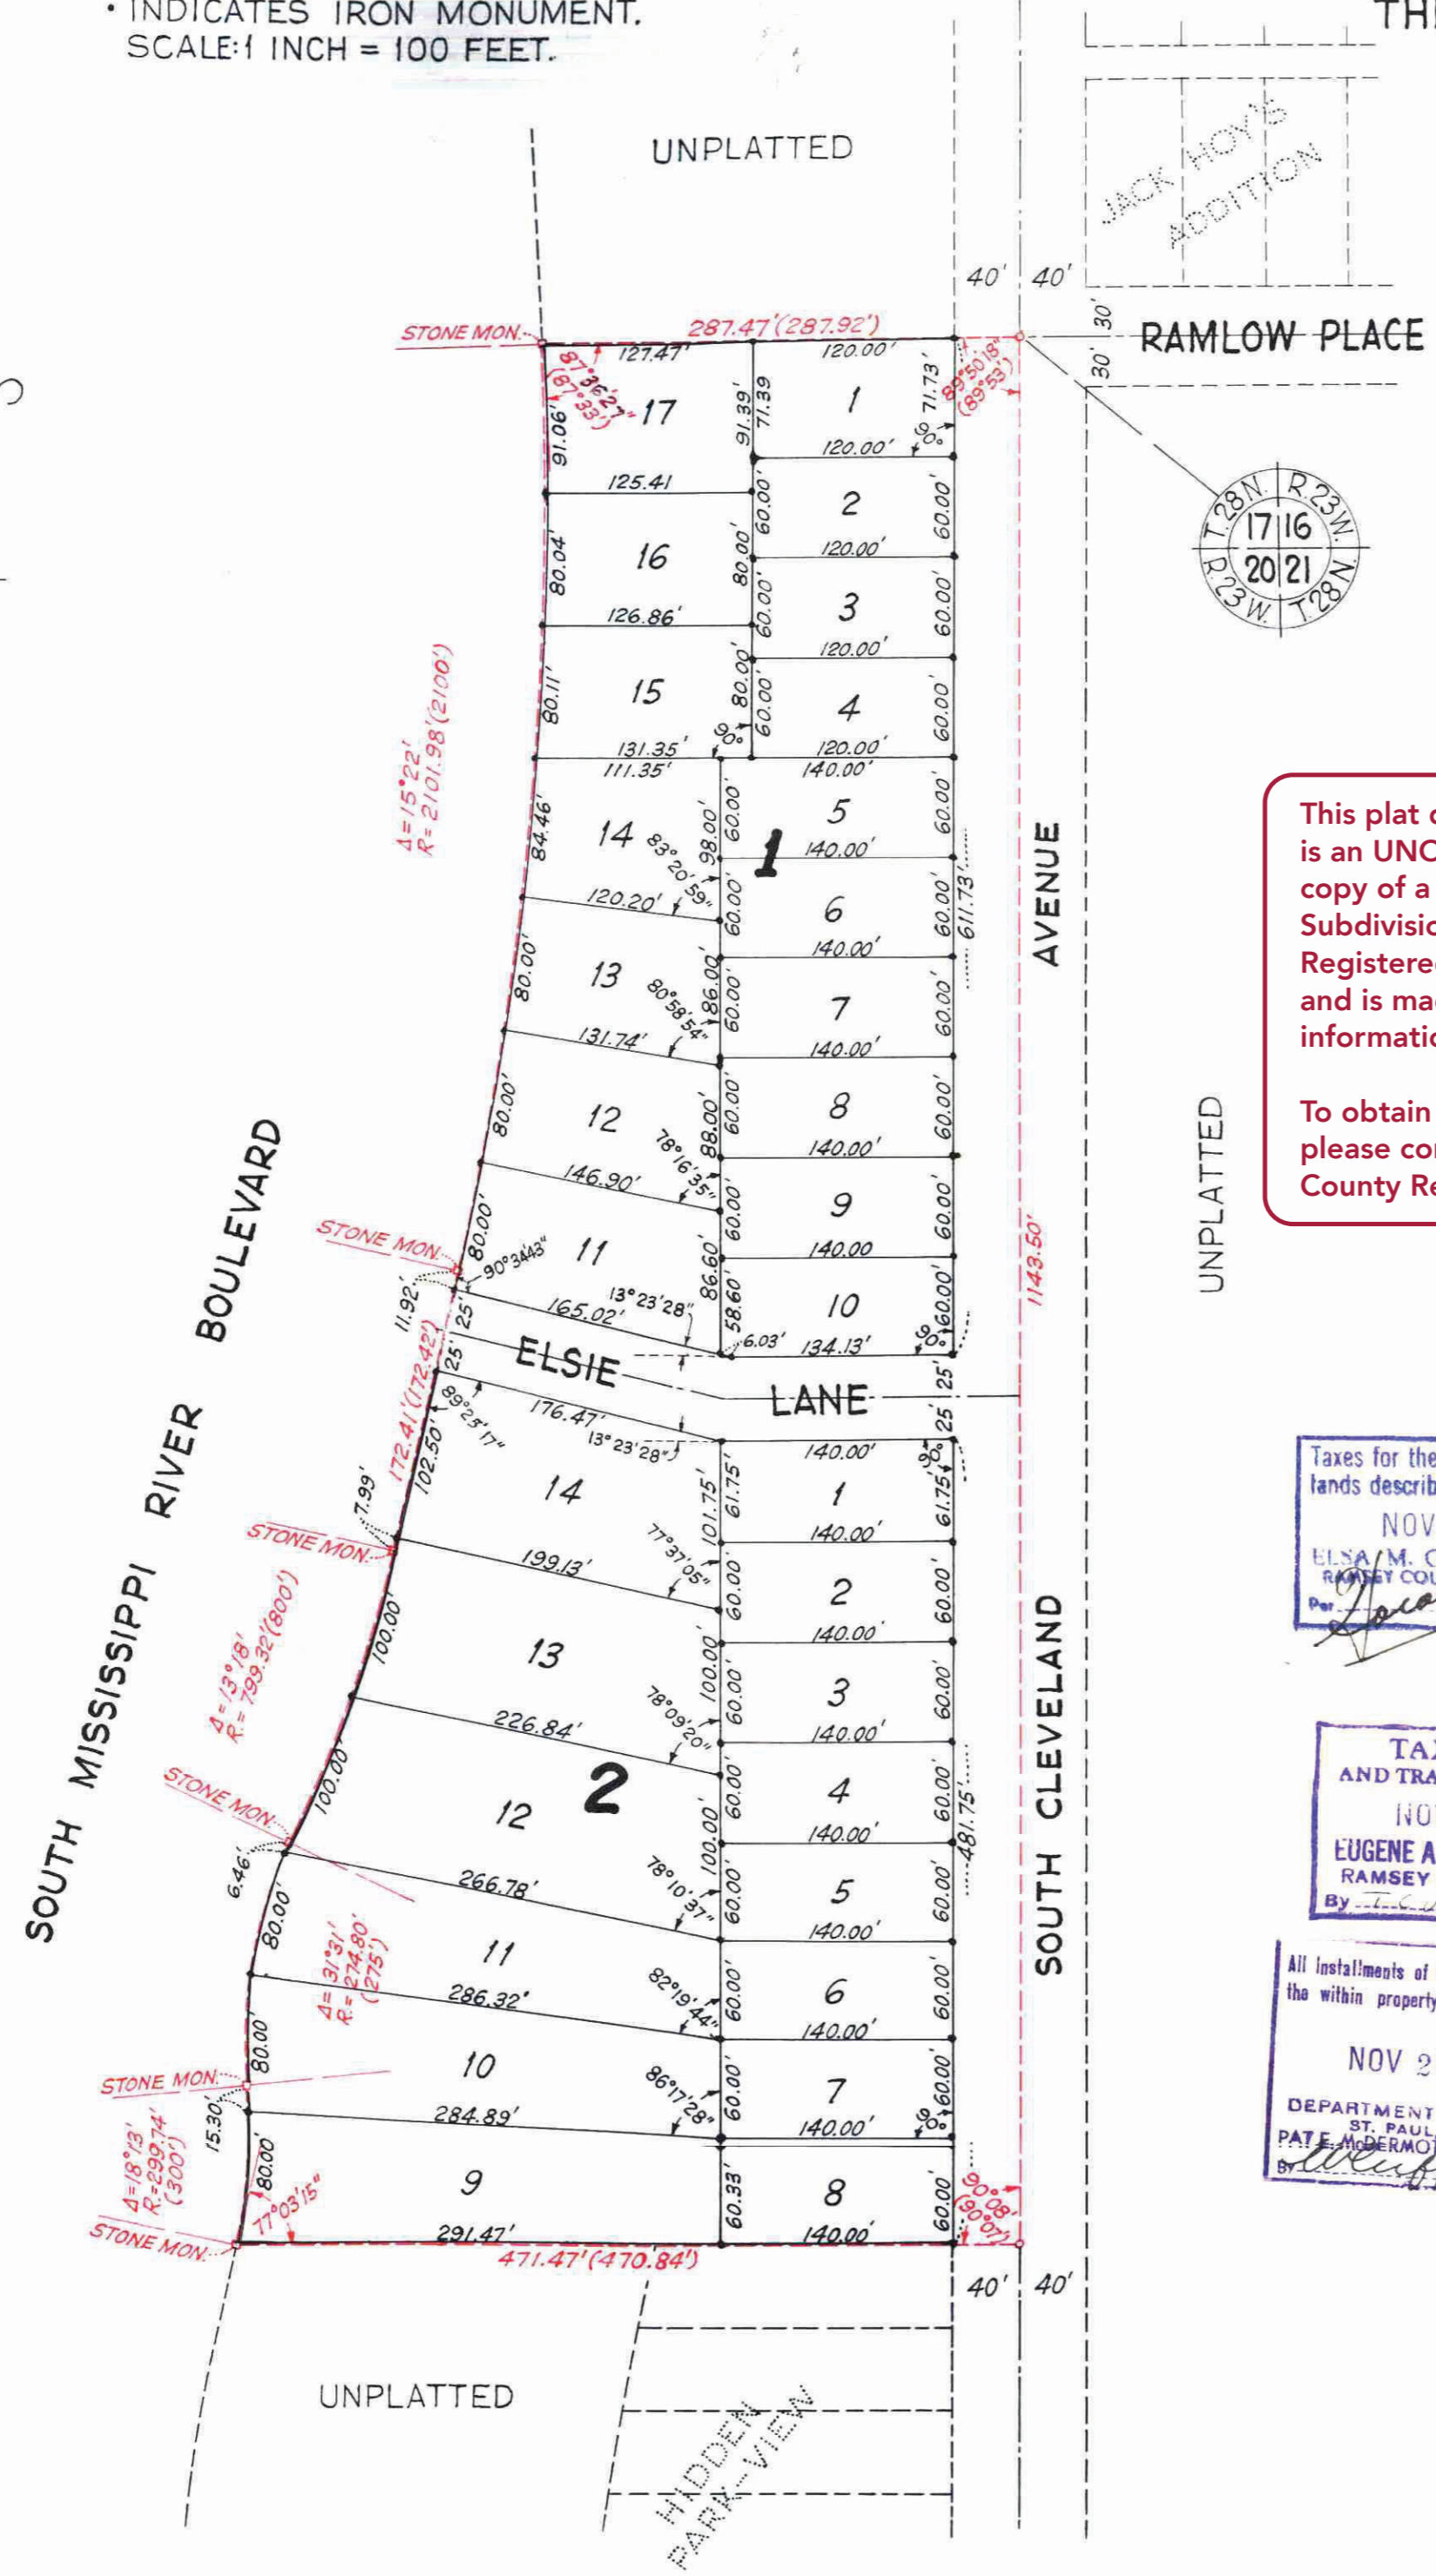

This plat document is an UNOFFICIAL copy of a Subdivision Plat or Registered Land Survey and is made available for information purposes only.

To obtain an official copy please contact the Ramsey County Recorder's Office.

Taxes for the year 1949 on the lands described herein PAID
NOV 25 1950
ELSA M. ORST, Treasurer
RAMSEY COUNTY, MINN.

TAXES PAID AND TRANSFER ENTRIES
NOV 25 1950
EUGENE A. MONICK, Auditor
RAMSEY COUNTY, MINN.

All Installments of Assessments due on the within property to date are paid
NOV 23 1950
DEPARTMENT OF FINANCE
ST. PAUL, MINN.
PAT E. BERMOJ, Com. Finance

"I hereby certify to having surveyed the property described on this plat as Lane-Norton Addition and have placed irons at the corners as shown and the same is correct. There is no low wet ground nor any traveled road or easement on or across same except as shown."

REGISTERED LAND SURVEYOR
MINNESOTA CERTIFICATE NO. 1990

This is to certify that I, Don W. Norton, unmarried, owner of:
All that part of Government Lot One (1), of Section Twenty (20), in Township Twenty-eight (28), Range Twenty-three (23), lying north of a line drawn as follows: Commencing at a point on the west line of Cleveland Avenue eleven hundred-forty-three and one-half (1143½) feet south of the point where said west line of Cleveland Avenue intersects the north line of said Lot One (1), not including Islands, and excepting that portion of said Lot One (1) taken by the City of St. Paul for Mississippi River Boulevard No. 2.; have caused the same to be surveyed and platted and hereafter known as Lane-Norton Addition, as shown by this plat, and hereby dedicate to the public and for the public use forever all streets, avenues, alleys, parks and boulevards as shown.

Witness our hands and seal this 22 day November of 1950

In presence of
Don E. Rane
E. B. McDonough

Accepted and approved this 27th day of November 1950.

George H. Herrold
Herbert West } Plat Commission

Milton Rove Commissioner of Public Works

STATE OF MINNESOTA
County of Ramsey
Office of the Registrar of Deeds
This is to certify that the within instrument was filed for record in this office at St. Paul on the 30 day of Nov A. D. 1950, at 3 o'clock P. M., and that the same was recorded in Book of
Clay Bunker
Deputy

State of Minnesota,
County of Ramsey
On this 22 day of November A. D. 1950, before me the undersigned personally appeared Eugene B. McDonough to me known to be the person described in and who executed the foregoing instrument and acknowledged that he executed the same as his free act and deed.

E. B. McDonough
NOTARY PUBLIC, RAMSEY COUNTY, MINN.
MY COMMISSION EXPIRES June 16th 1956

State of Minnesota,
County of Ramsey
On this 22 day of November A. D. 1950, before me the undersigned personally appeared Don W. Norton to me known to be the person described in and who executed the foregoing instrument and acknowledged that he executed the same as his free act and deed.

Don W. Norton
NOTARY PUBLIC, RAMSEY COUNTY, MINN.
MY COMMISSION EXPIRES June 16th 1956

Accepted and approved by the St. Paul City Planning Board

P. B. Wickham
Secretary

Accepted by the Council Nov 28th 1950
Approved Nov 28th 1950

A. T. O'Donnell
City Clerk

1240300