


LAKEWOOD HILLS NO. 2

WHITE BEAR TOWNSHIP RAMSEY COUNTY MINNESOTA

° INDICATES IRON MONUMENTS

SCALE: 1"=40'

MILNER W. CARLEY & SON
CIVIL ENGINEERS & SURVEYORS

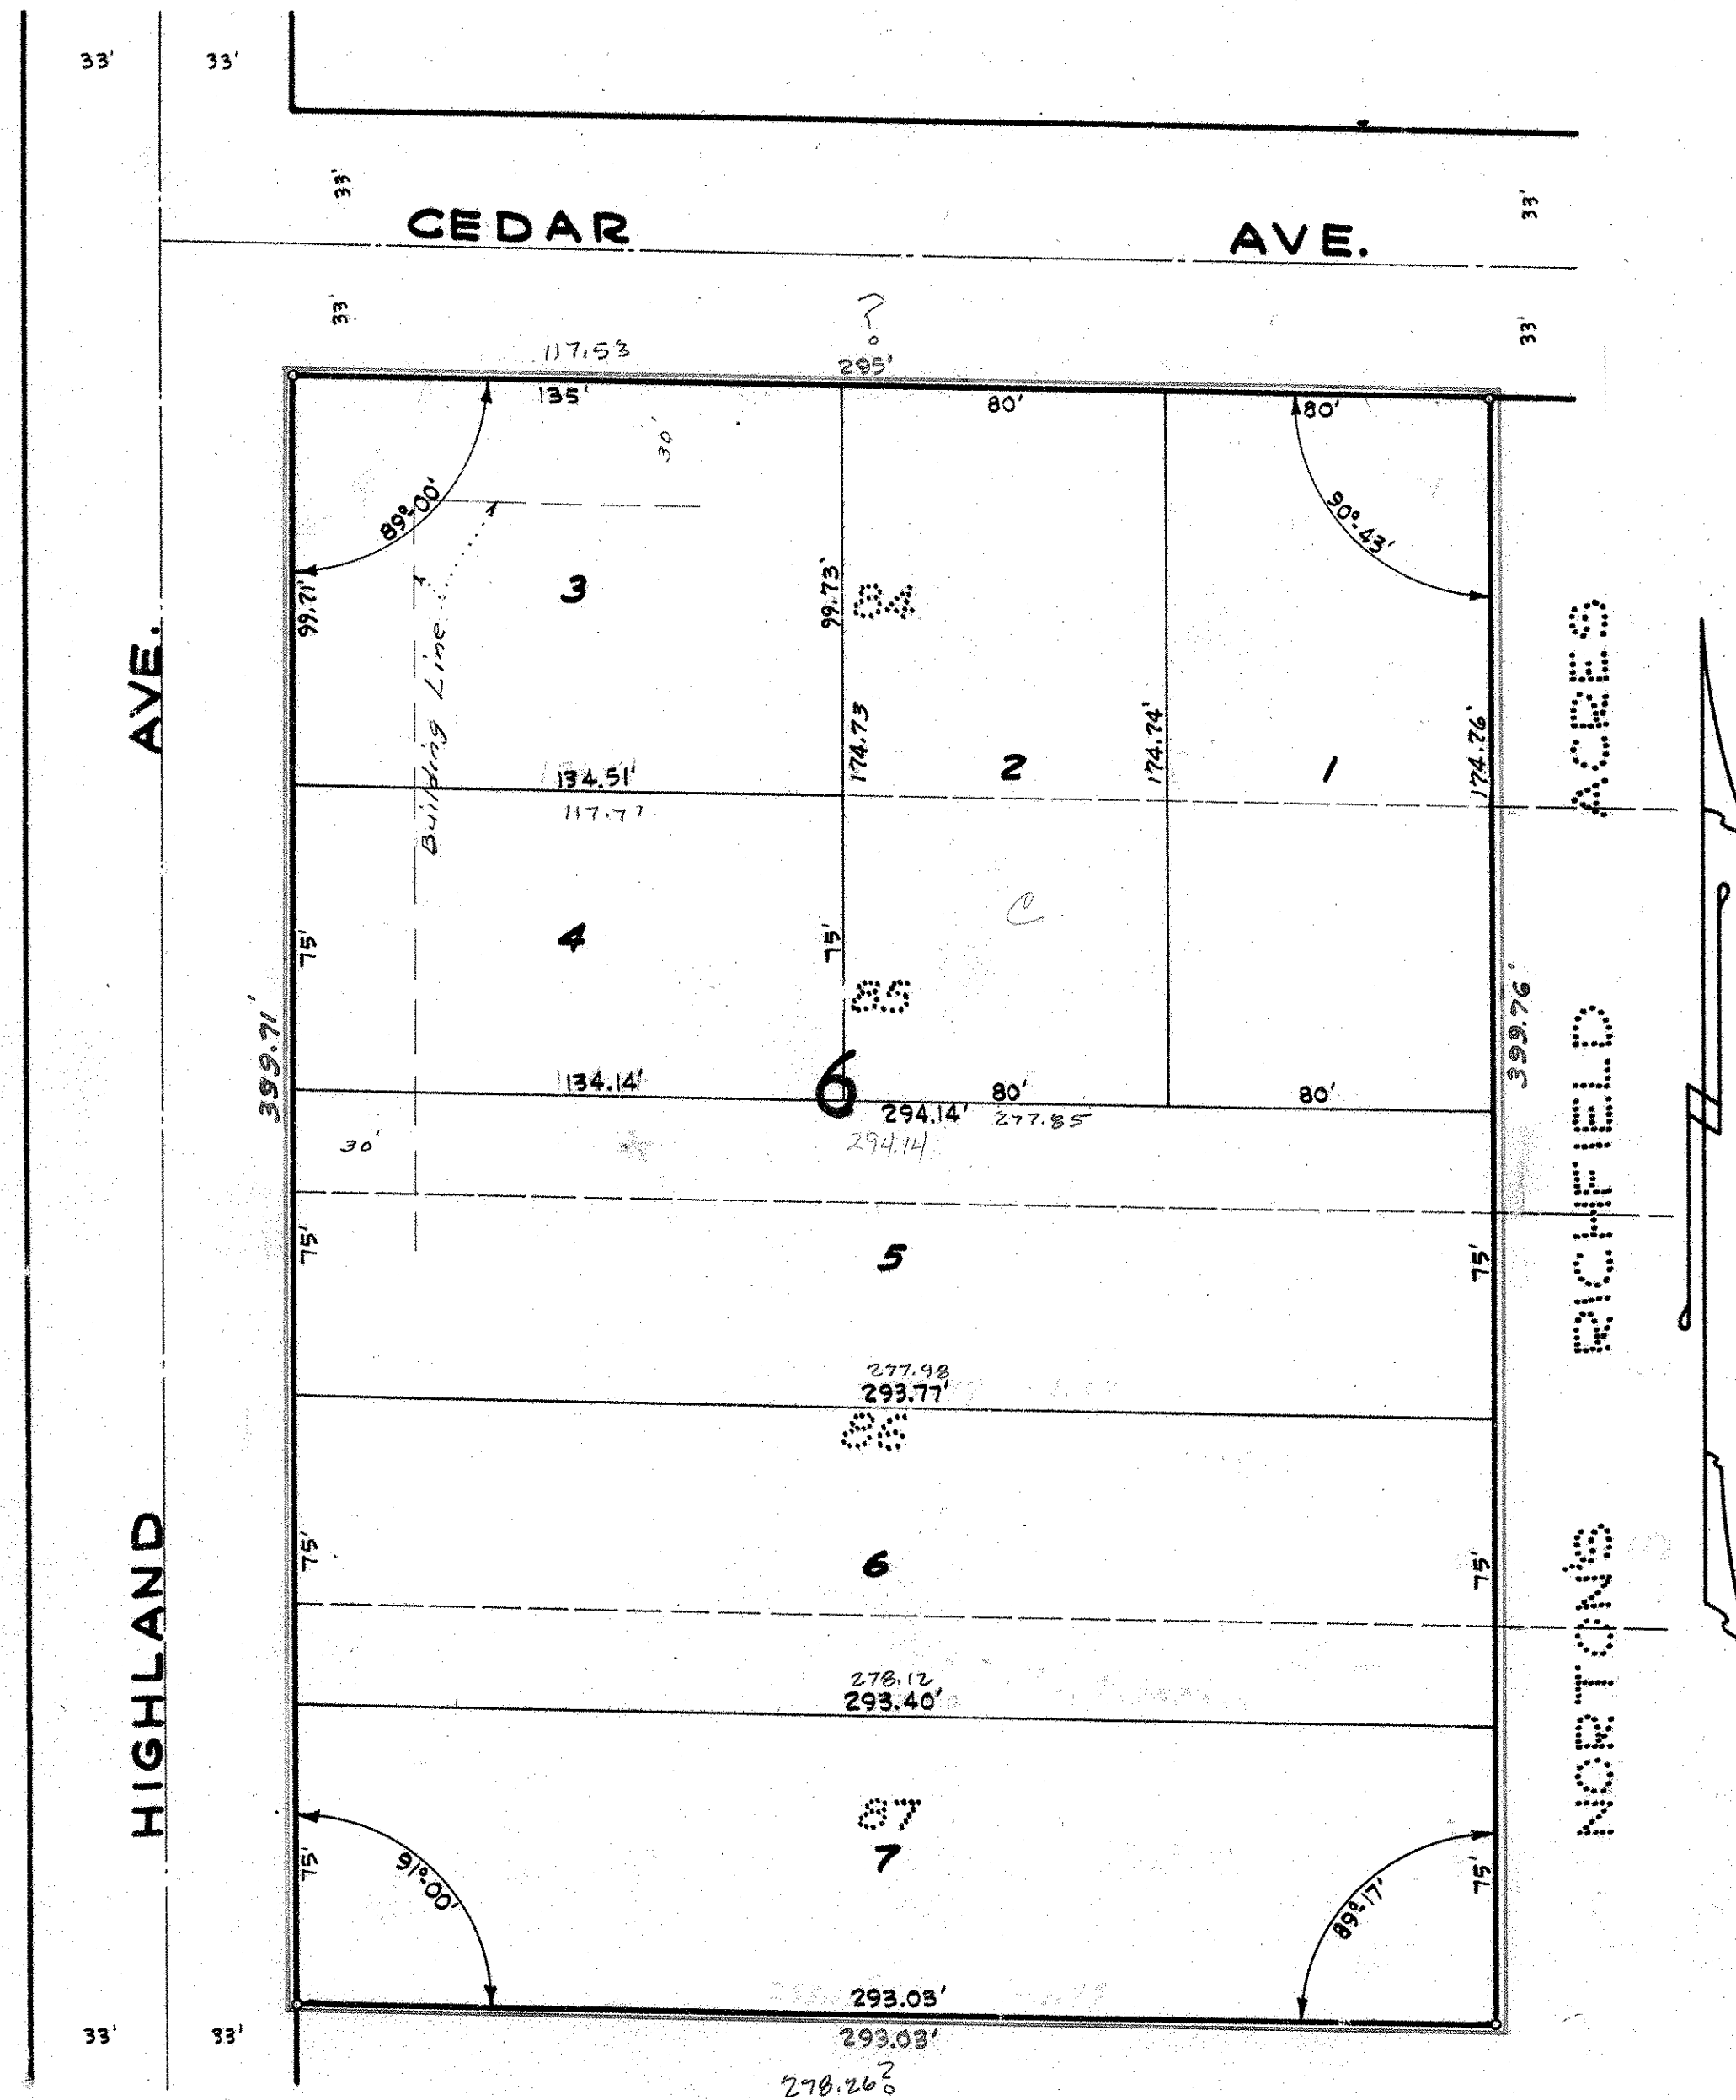

This is to certify that Kenneth W. Bacchus, Inc., owner of: Lots 84, 85, 86 and 87 Norton's Richfield Acres, Ramsey County, Minnesota has caused the same to be surveyed and platted and hereafter known as "LAKEWOOD HILLS NO. 2" and hereby dedicate to the public and for the public use forever all streets and avenues as shown.

Witness our hands and seal this 3rd day of December A. D. 1954.

In presence of:

<u>Donald D. Carley</u>	Kenneth W. Bacchus Inc.
<u>Michael W. Schmitz</u>	<u>Kenneth W. Bacchus</u> President
	<u>Gordon R. Manage</u> Secretary & Treasurer

STATE OF MINNESOTA)
COUNTY OF RAMSEY) SS

On this 3rd day of December A. D. 1954, before me appeared Kenneth W. Bacchus and Gordon R. Manage, who each duly sworn did say that they are respectively the President and Secretary and Treasurer of Kenneth W. Bacchus Inc., a Minnesota corporation, the corporation named in the foregoing instrument and seal affixed to said instrument is the corporate seal of said corporation and that said instrument was signed and sealed in behalf of said corporation by authority of its Board of Directors, and said President and said Secretary and Treasurer acknowledged said instrument to be the free act and deed of said corporation.

Donald D. Carley
Notary Public, Ramsey County, Minn.
My commission expires Mar 3 1956.

I hereby certify to having surveyed the property described on this plat as "LAKEWOOD HILLS NO. 2" and have placed iron monuments on corners as shown and the same is correct. There is no low wet ground nor traveled road or easement on or across same except as shown.

Milner W. Carley
Registered Surveyor
Minnesota Certificate No. 856

STATE OF MINNESOTA)
COUNTY OF RAMSEY) SS

On this 2nd day of December A. D. 1954, before me the undersigned personally appeared Milner W. Carley to me known to be the person described in and who executed the foregoing instrument and acknowledged the same as his free act and deed.

Donald D. Carley
Notary Public, Ramsey County, Minn.
My commission expires Mar 3 1956.

Accepted and approved this 13th day of December A. D. 1954.

Herbert J. West
Alfred D. Hampton
J. D. Loehs
Frank D. Morzittelli

Plat Commission
Commissioner of Public Works.

Accepted and approved by the Township Board of White Bear Township this 6th day of December 1954.

Herman R. Hanson
Clerk of Township

Accepted and approved by the Board of County Commissioners this 20 day of

December 1954.
Edna Amund
County Auditor, Ramsey County, Minnesota.