

WOODLAWN ADDITION


ST. PAUL, MINNESOTA

DOCUMENT NUMBER 342986
 CERTIFICATE NUMBER 27916
 BOOK 316 PAGE 14
 STATE OF MINNESOTA
 Office of the Registrar of Titles
 This is to certify that this instrument was filed in the Office at St. Paul on the 21 day of December A.D. 1954
 at 2:00 o'clock P.M.
 J. E. Barnard
 Registrar of Titles
 Du. N. A. Hodgson
 Deputy

BY
THE E. B. McDONOUGH COMPANY
 ST. PAUL MINNEAPOLIS

SCALE: 1" = 40'
 • = IRON

OR GB 18-7-19

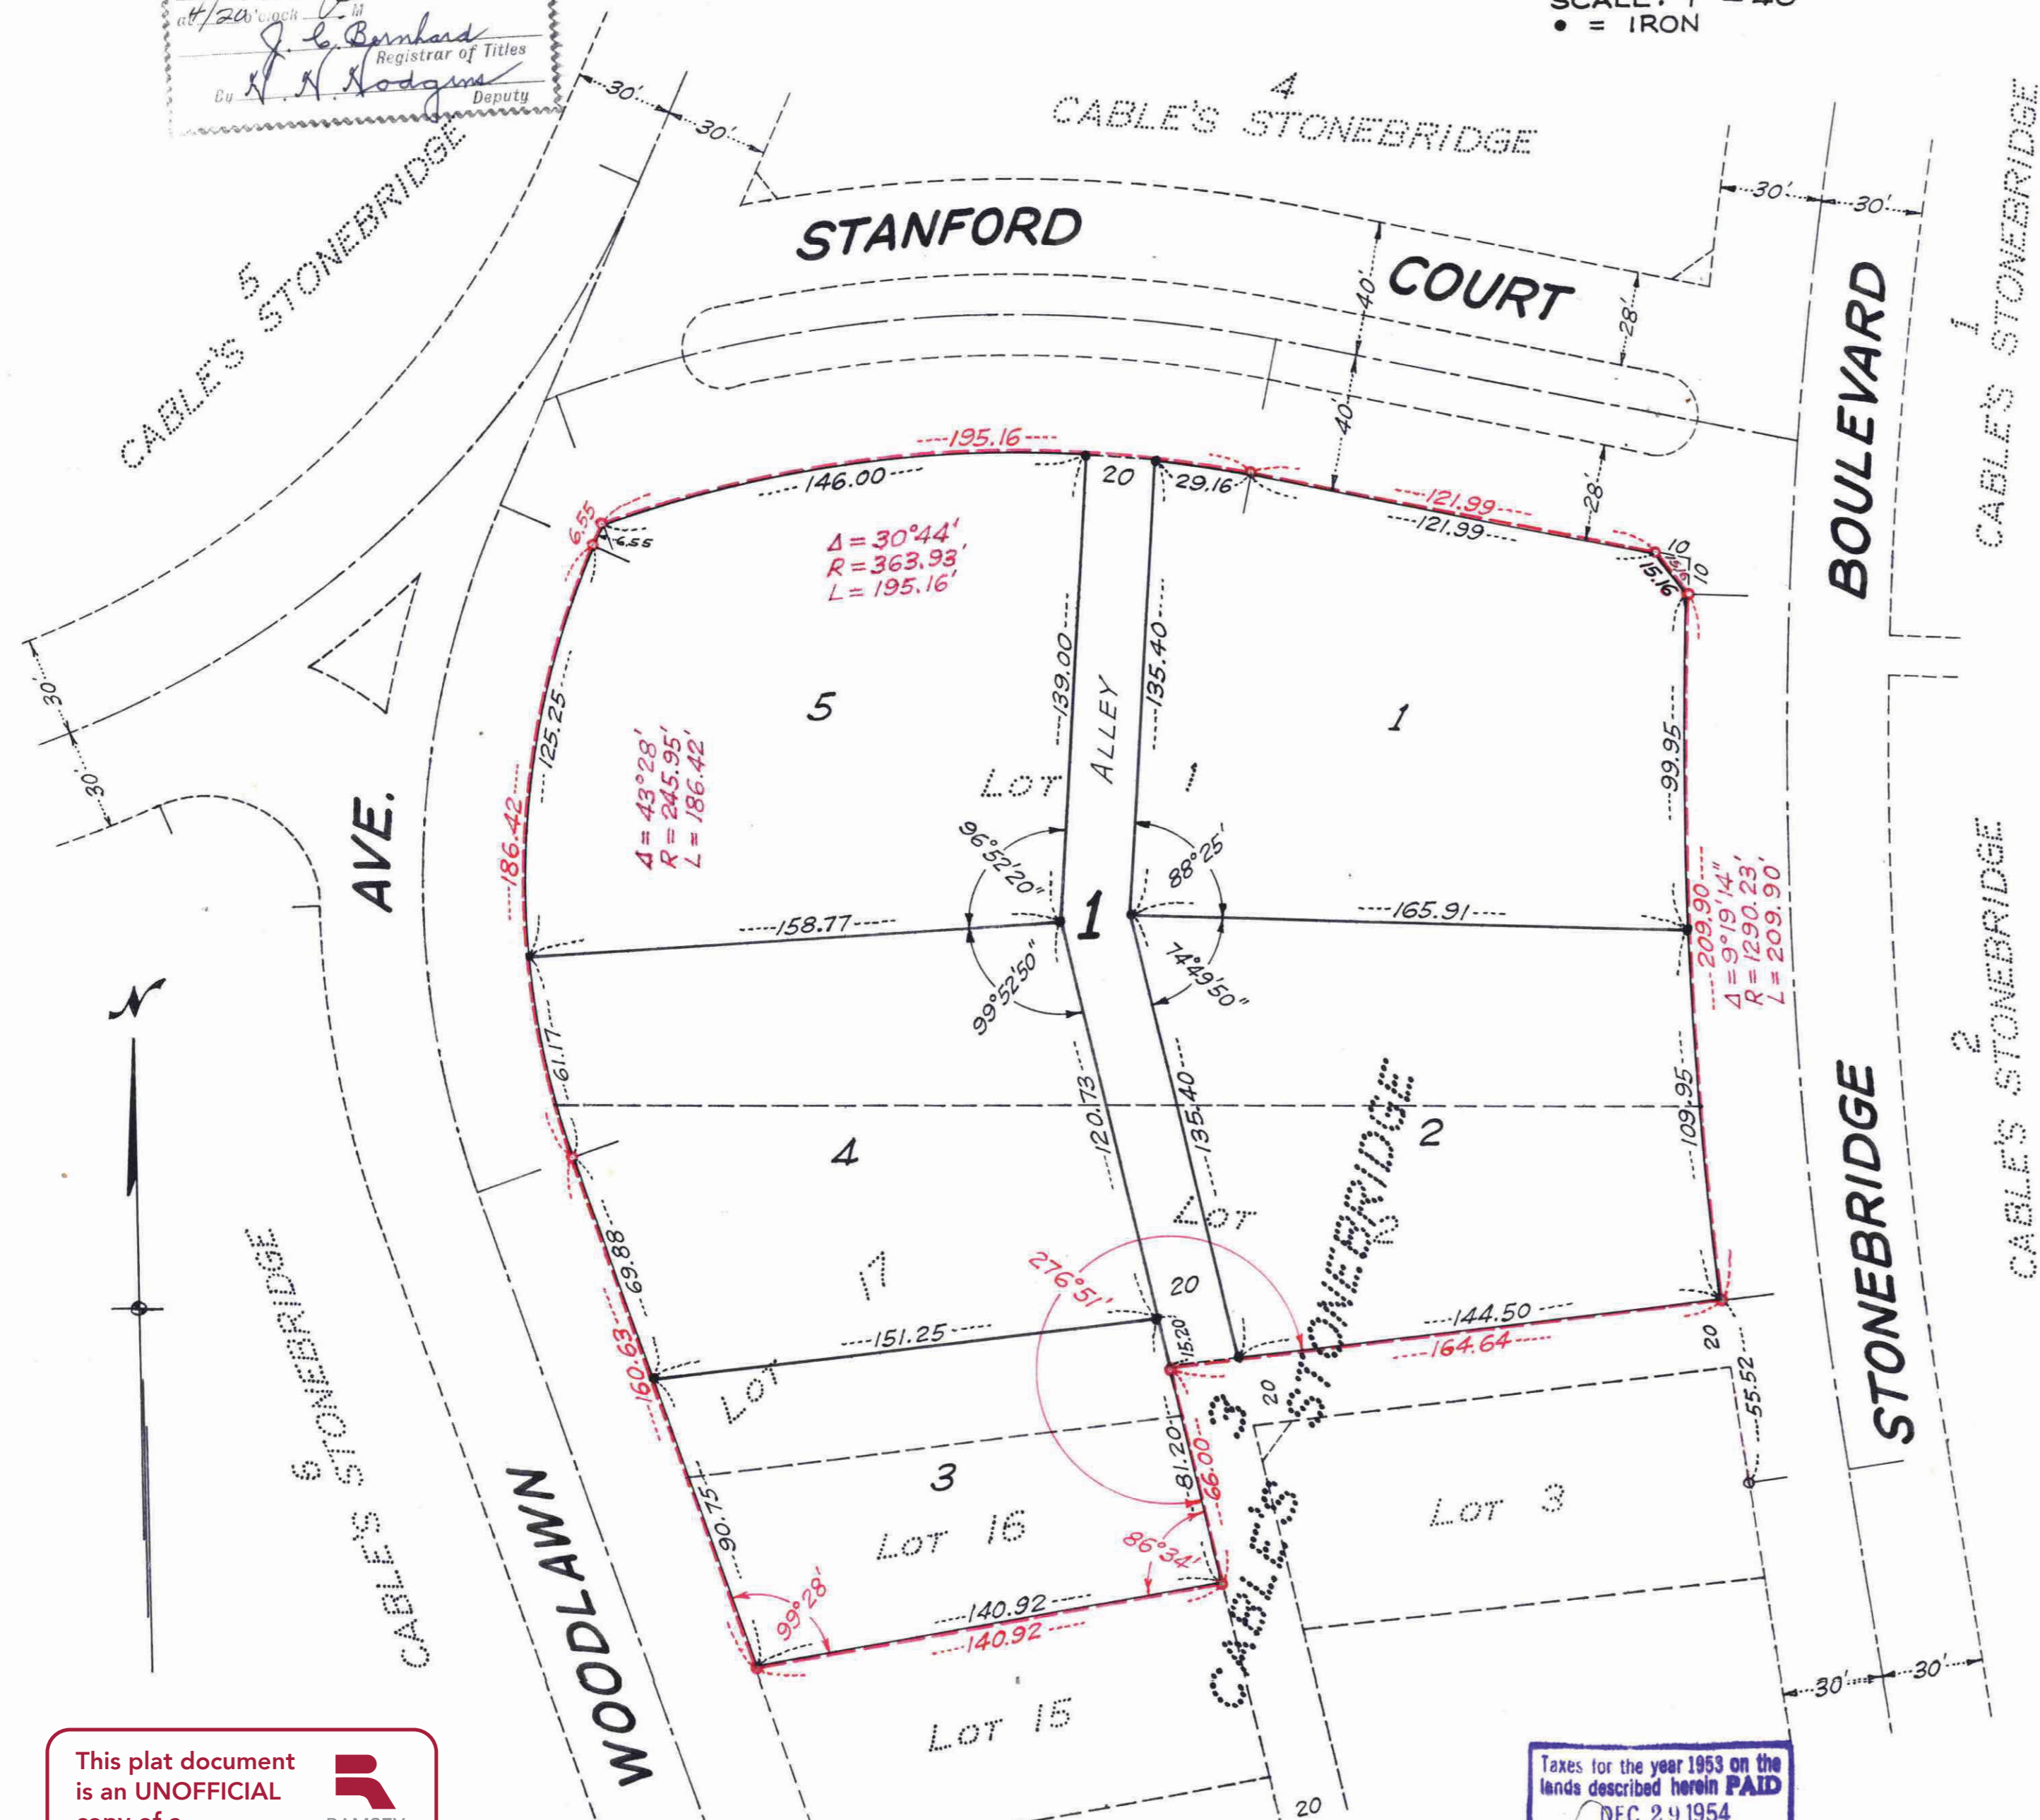

I hereby certify to having surveyed the property described on this plat as "WOODLAWN ADDITION" and have placed iron monuments at the corners shown and the same is correct. There is no low wet ground nor any traveled road or easement on or across same except as shown.
 E. B. McDonough
 Registered Surveyor
 Minnesota Certificate No 1990

State of Minnesota } s.s.
 County of Ramsey }
 On this 21st day of December A.D. 1954, before me, the undersigned, personally appeared E. B. McDonough to me known to be the person described in and who executed the foregoing instrument and acknowledged that he executed the same as his free act and deed.
 Raegen Stacker
 Notary Public, Ramsey County, Minnesota
 My Commission expires August 19, 1959

This is to certify that we John J. Wolkerstorfer and Rosalie O. Wolkerstorfer, husband and wife, owners of Lot sixteen (16) and the Southerly thirty (30) feet of Lot seventeen (17), Block three (3), Cable's Stonebridge have caused the same to be surveyed and platted and hereafter known as "WOODLAWN ADDITION" as shown by this plat, and hereby dedicate to the public and for the public use forever all streets, avenues, alleys, parks and boulevards as shown.

Witness our hands and seal this 21st day of December 1954.
 In presence of
 Raegen Stacker
 State of Minnesota } s.s.
 County of Ramsey }
 John J. Wolkerstorfer
 Rosalie O. Wolkerstorfer

On this 27th day of December A.D. 1954 before me the undersigned personally appeared John J. Wolkerstorfer and Rosalie O. Wolkerstorfer to me known to be the persons described in and who executed the foregoing instrument and acknowledged that they executed the same as their free act and deed.
 Raegen Stacker
 Notary Public, Ramsey County, Minnesota
 My Commission expires August 19, 1959

This is to certify that we John J. Wolkerstorfer, Gordon E. Strate and N. Paul Delander, as Trustees, owners of Lots one (1) and two (2), and Lot seventeen (17) except the Southerly thirty (30) feet thereof, Block three (3), Cable's Stonebridge have caused the same to be surveyed and platted and hereafter known as "WOODLAWN ADDITION" as shown by this plat, and hereby dedicate to the public and for the public use forever all streets, avenues, alleys, parks and boulevards as shown.

Witness our hands and seal this 27th day of December 1954.
 In presence of
 Raegen Stacker
 Fred Silvestri
 State of Minnesota } s.s.
 County of Ramsey }
 John J. Wolkerstorfer
 Gordon E. Strate
 N. Paul Delander

On this 27th day of December A.D. 1954 before me the undersigned personally appeared John J. Wolkerstorfer, Gordon E. Strate and N. Paul Delander, to me known to be the persons described in and who executed the foregoing instrument and acknowledged that they executed the same as their free act and deed as said Trustees.
 Raegen Stacker
 Notary Public, Ramsey County, Minnesota
 My Commission expires August 19, 1959

Accepted and approved this 28th day of December A.D. 1954.
 Plat Commission
 Commissioner of Public Works
 Accepted by the Council
 Approved December 29th 1954
 City Clerk

This plat document is an UNOFFICIAL copy of a Subdivision Plat or Registered Land Survey and is made available for information purposes only.
 To obtain an official copy please contact the Ramsey County Recorder's Office.

342986

TAXES PAID AND TRANSFER ENTERED DEC 29 1954
 EUGENE A. MONYCK, Auditor
 RAMSEY COUNTY, MINN.

Taxes for the year 1953 on the lands described herein PAID DEC 29 1954
 ELVA M. QUIST, Treasurer
 RAMSEY COUNTY, MINNESOTA

DEC 26 1954