
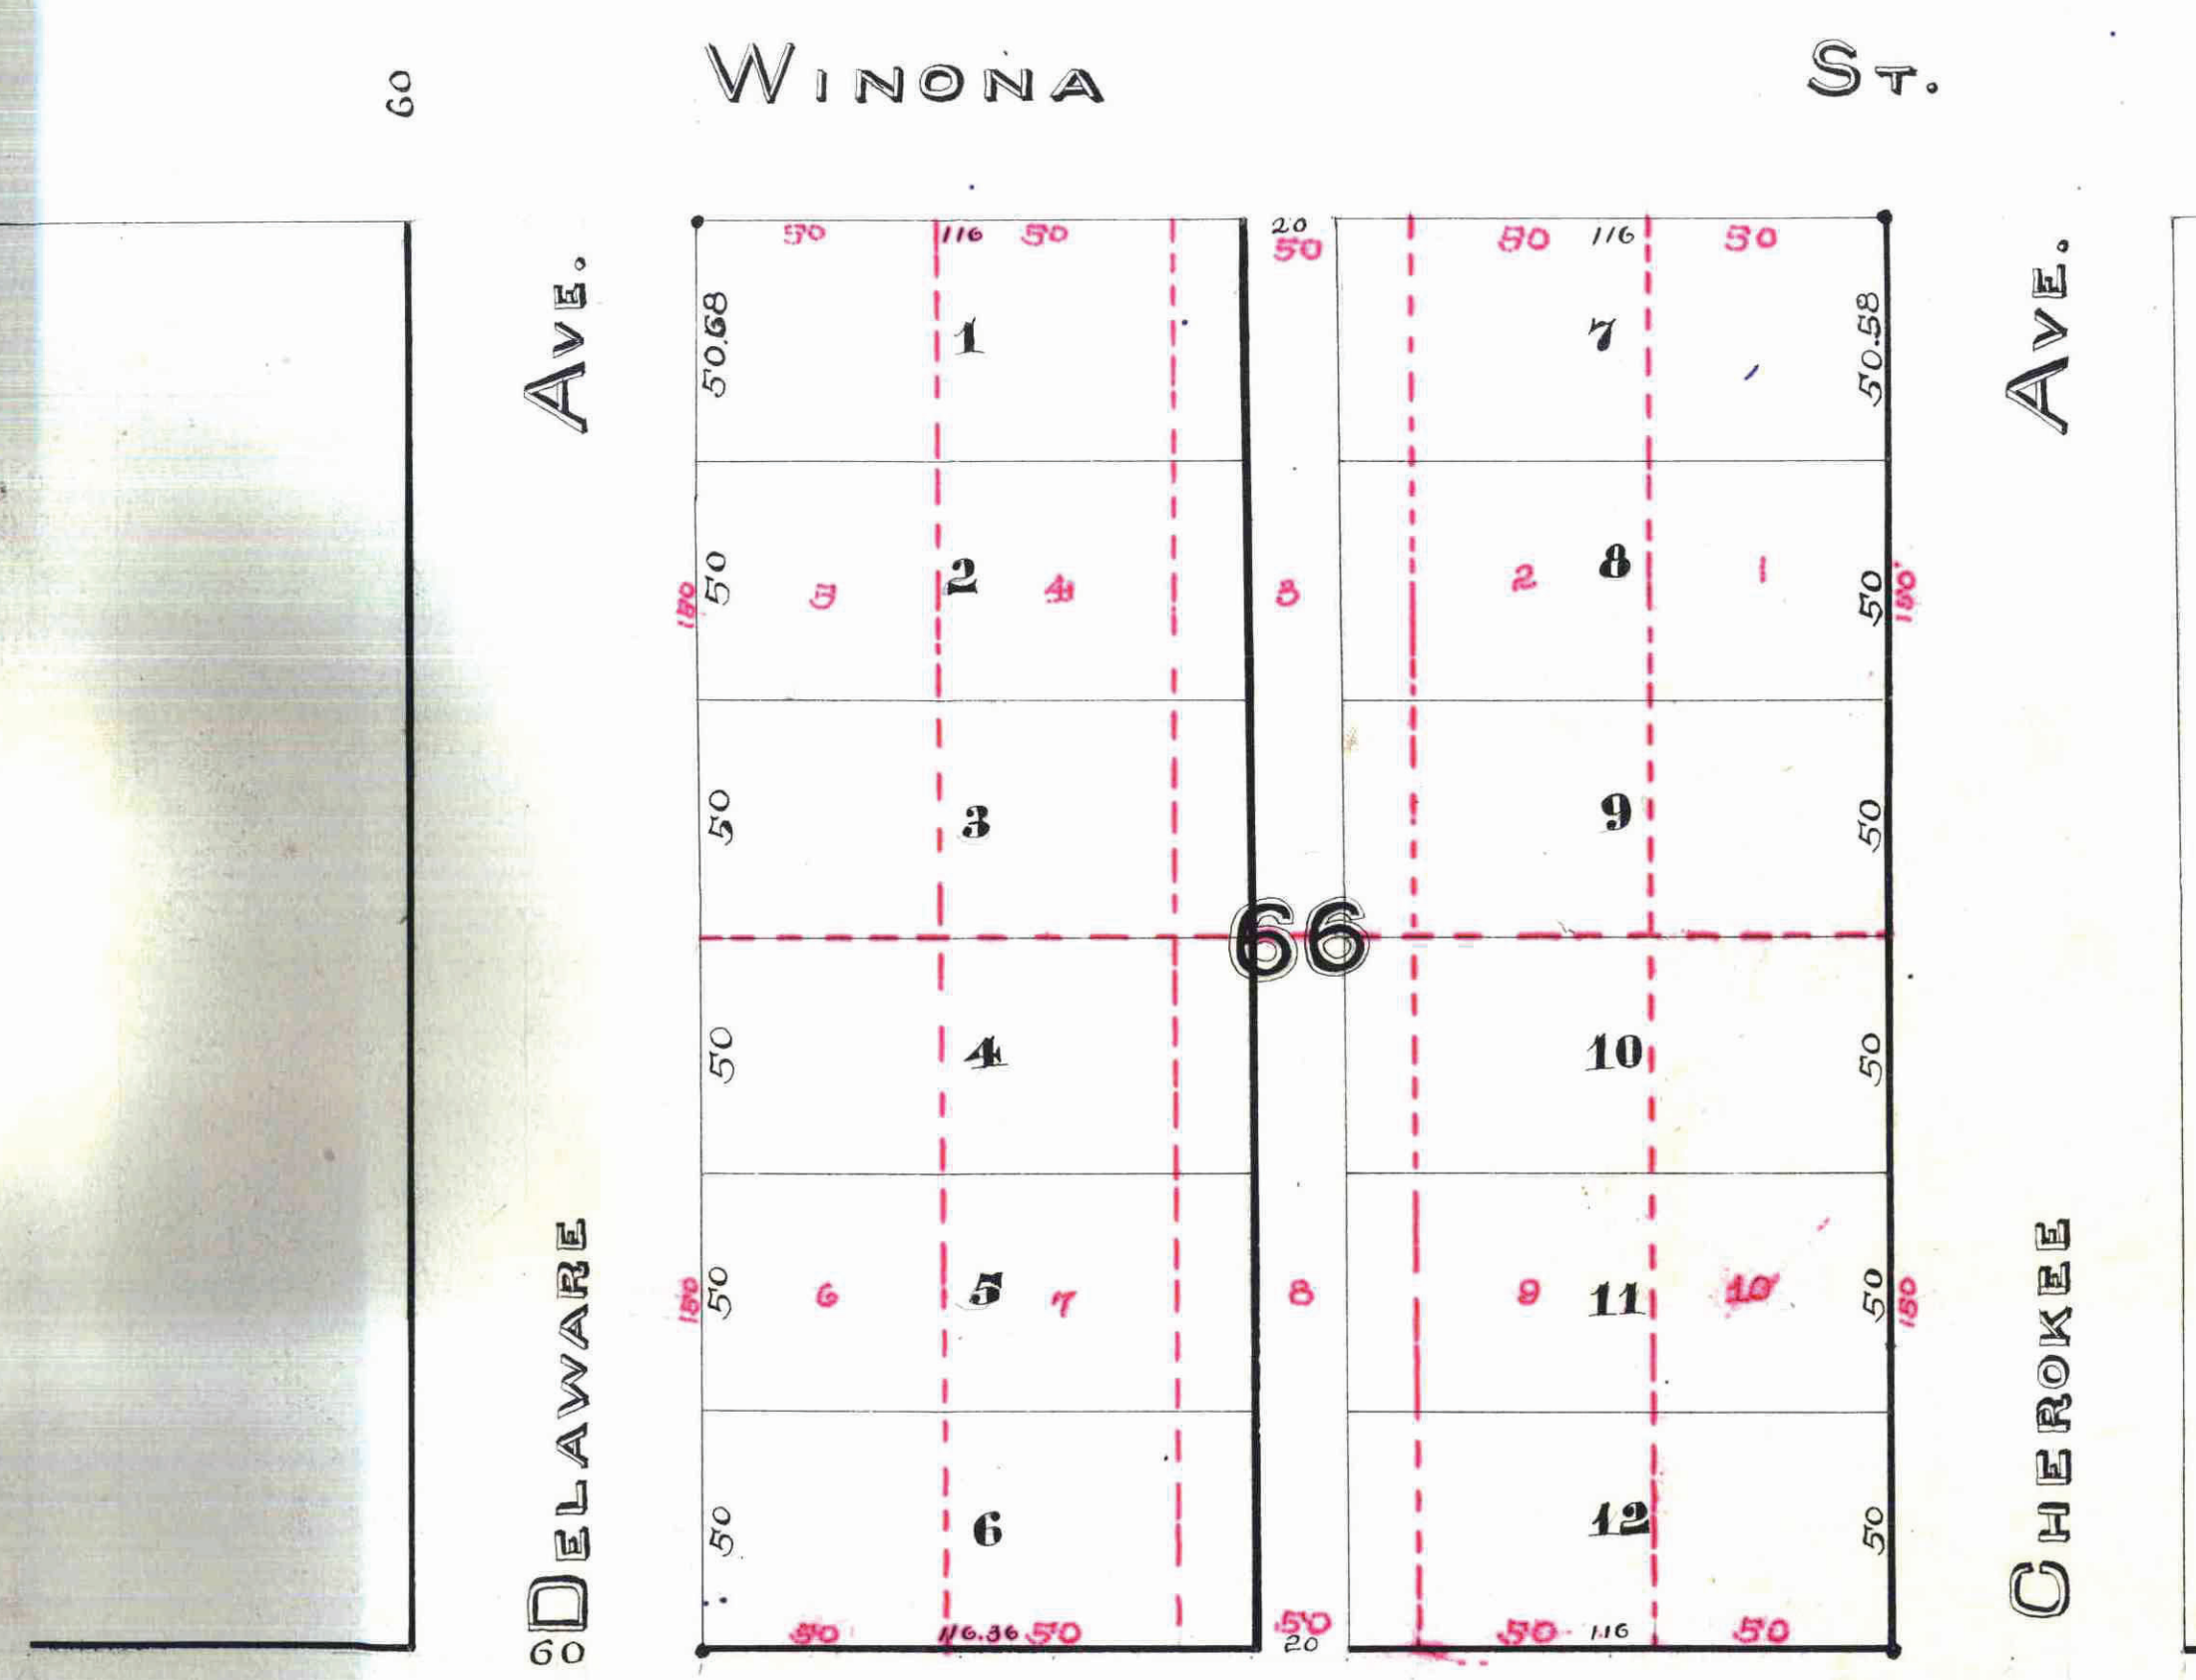


P. R. McDONNELL'S REARRANGEMENT

BLOCK 66 BANNING & OLIVIER'S ADD. TO

WEST ST. PAUL.
SCALE 1 INCH 40 FEET.

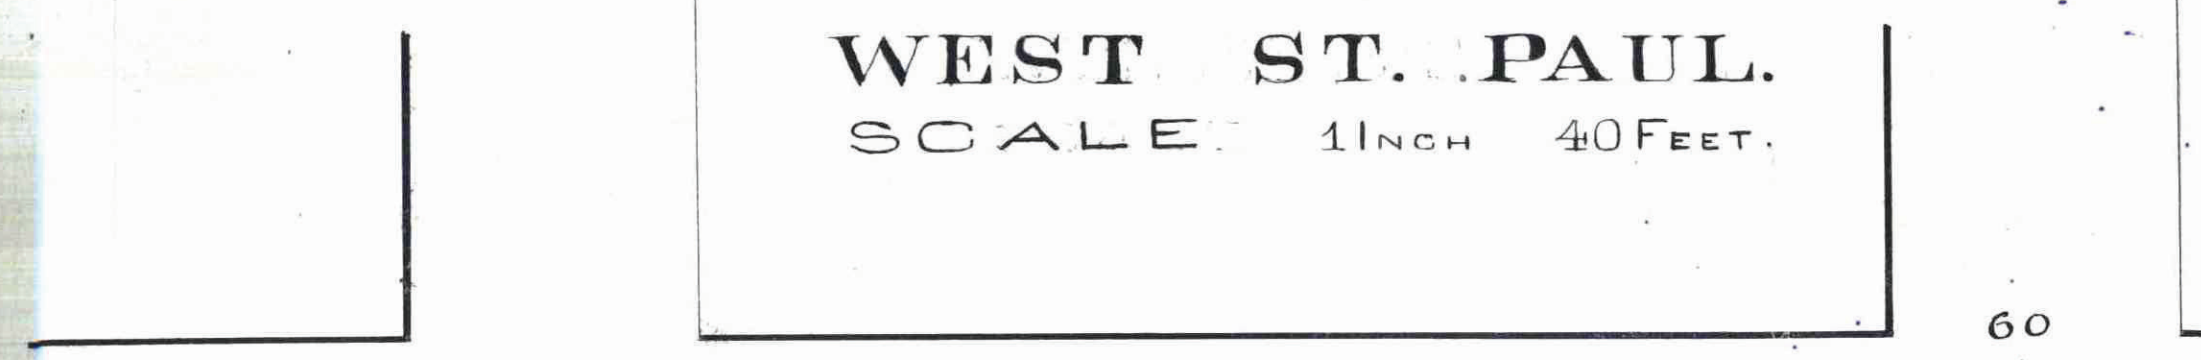

We the undersigned owners of Block 66 Banning and Olivier's Addition to west Saint Paul Minnesota do hereby certify to having caused the same to be surveyed and platted as P. R. McDonnell's Rearrangement, as herein and hereon indicated, and we do hereby give and dedicate to the public and for the public use forever all the streets and alleys as hereon this map or plat laid out and designated.

In witness whereof we have hereunto set our hands and seals this 27th day of February A.D. 1884.
In presence of
H. Phillips } *Patrick R. McDonnell* (Seal)
F. Sibold } *Mary E. McDonnell* (Seal)

State of Minnesota }
County of Ramsey } Be it known that on this 27th day of February A.D. 1884 before me personally came Patrick R. McDonnell and Mary E. McDonnell his wife to me known to be the identical persons described, and who acknowledged to having executed the foregoing instrument as their free act and deed for the uses and purposes therein expressed.

Fredrick Sibold
Notary Public

I hereby certify to having surveyed and platted the piece of property described on this map as P. R. McDonnell's Rearrangement, and have placed iron monuments at the corners of the block as shown on this plat, and the same is correct.
J. B. Hawley
Surveyor.

State of Minnesota }
County of Ramsey } Be it known that on this 3rd day of March A.D. 1884. Personally appeared before me the undersigned J. B. Hawley to me well known to be the identical person who surveyed and platted the here on designated and described piece or parcel of land and who executed the certificate of the survey thereof and he acknowledges the same to be true and correct and his free act and deed for the uses and purposes therein expressed.

J. B. Hawley
Notary Public

Approved, signed and accepted by this commission.
March 3rd A.D. 1884.
J. P. Hanson }
Joe Starkup } Plat Commission.

Approved by the City Council on this 3rd day of March, A.D. 1884.
George H. ... City Clerk
City St. Paul

I certify to having examined the above plat and recommend its approval.
March 4th 1884.
W. A. ... City Engineer,
City St. Paul

This plat document is an UNOFFICIAL copy of a Subdivision Plat or Registered Land Survey and is made available for information purposes only.
To obtain an official copy please contact the Ramsey County Recorder's Office.



Note
• = Iron monument

STATE OF MINNESOTA
County of Ramsey
OFFICE OF THE REGISTER OF DEEDS
This is to certify that the within instrument was filed for Record in this office, at St. Paul, on the 26th day of May A.D. 1884 at 2³⁰ clock P.M., and that the same was duly recorded in Book 12 of Plat pages 22
R. C. Wiley Registrar of Deeds.
By _____

CITY TREASURERS OFFICE
ST. PAUL, MINN.
MAY 26 1884
ASSESSMENTS PAID
George Rie City Treas.
Chapin Deputy

J. ... and transfer entered
this 26th day of May 1884
J. J. McCarty
County Clerk
St. Paul