


# EASTVIEW ADDITION NO. 2 ST. PAUL MINN.

This plat document is an UNOFFICIAL copy of a Subdivision Plat or Registered Land Survey and is made available for information purposes only.  
To obtain an official copy please contact the Ramsey County Recorder's Office.

SCALE 1 IN. = 50 FT.  
° INDICATES IRON MON.

JOHN A. WIELDE  
SURVEYOR

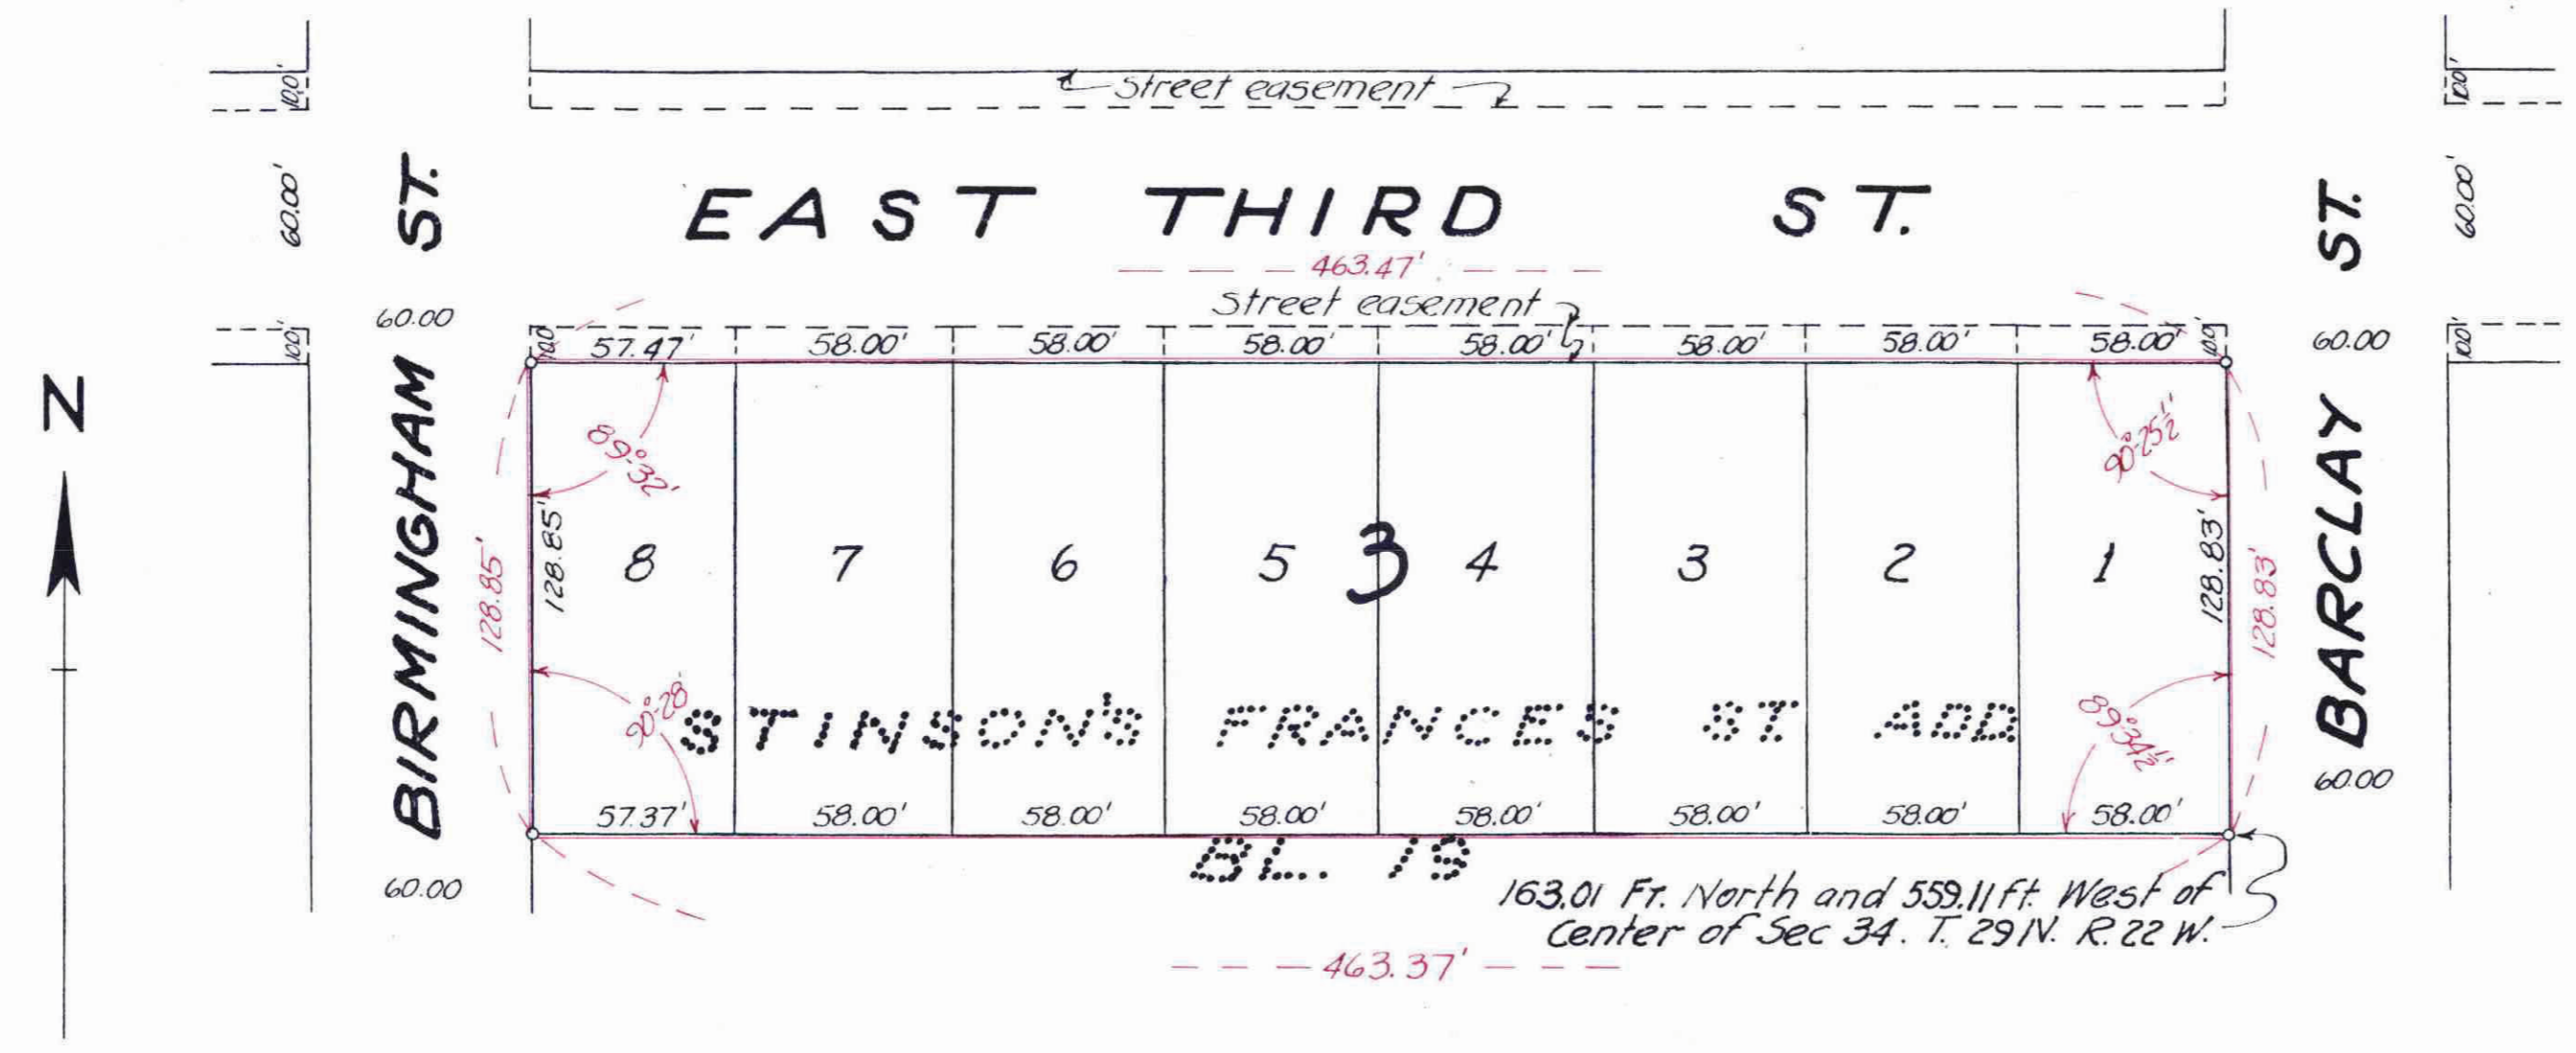

Accepted by the council April 1 A.D. 1955  
Approved April 1 A.D. 1955  
Joseph R. Oronski City Clerk

Accepted and approved this 30th day of March A.D. 1955  
Herbert West  
Alfred D. Bergquist  
C. D. Fred } Plat Commission  
Frank D. Magistella Commissioner of Public Works

I hereby certify to having surveyed the property described on this plat as Eastview Addition No. 2 and have placed iron monuments at the corners shown and the same is correct. There is no low wet ground nor any travelled road or easement on or across same except as shown.

John A. Wielde  
Registered Surveyor  
Minnesota Certificate No. 3443

This is to certify that Edward M. Smith and Maxine C. Smith, husband and wife, owners of the North half (N. 1/2) of Block Nineteen (19) in Stinson's Frances Street Addition to St Paul, Ramsey Co., Minn., according to the recorded plat thereof on file and of record in the office of Register of Deeds in and for said County have caused the same to be surveyed and platted and hereafter known as Eastview Addition No. 2 as shown by this plat, and hereby dedicates to the public and for the public use forever all streets and avenues as shown.

Witness our hands and seal this 26th day of March 1955.  
In presence of

Jeanette M. Schmidt  
John L. Schmidt, Jr.  
State of Minnesota, ss.  
County of Ramsey

Edward M. Smith  
Maxine C. Smith

State of Minnesota } ss.  
County of Ramsey }  
On this 26th day of March A.D. 1955 before me, the undersigned, personally appeared John A. Wielde to me known to be the person described in and who executed the foregoing instrument and acknowledged that he executed the same as his free act and deed.

John A. Schmid, Jr.  
Notary Public, Ramsey County, Minnesota  
My commission expires

On this 26th day of March A.D. 1955 before me the undersigned personally appeared Edward M. Smith and Maxine C. Smith to me known to be the persons described in and who executed the foregoing instrument and acknowledged that they executed the same as their free act and deed.

John A. Schmid, Jr.  
Notary Public, Ramsey County, Minnesota  
My commission expires

DOCUMENT NUMBER 346161  
CERTIFICATE NUMBER 57898  
BOOK 362 PAGE 188  
STATE OF MINNESOTA  
County of Ramsey  
OFFICE OF THE REGISTRAR OF TITLES  
This is to certify that the within instrument was filed in this office at St. Paul on the 4th day of April A.D. 1955 at 2 o'clock PM  
Ed J. Johnson  
Registrar of Titles  
Deputy

Taxes for the year 1954 on the lands described herein PAID  
APR 4 1955  
OTTO W. ROHLAND, JR., Treasurer  
RAMSEY COUNTY, MINNESOTA

TAXES PAID  
AND TRANSFER ENTERED  
APR 4 1955  
EUGENE A. MONICK, Auditor  
RAMSEY COUNTY, MINN.

All Installments of Assessments due on the within property in date are paid  
APR - 5 1955  
DEPARTMENT OF FINANCE  
RAMSEY COUNTY, MINN.  
Ed J. Johnson

191943

JOHN A. SCHMID, Jr.  
Notary Public, Ramsey County, Minn.  
My commission expires Sept. 26, 1958

JOHN A. SCHMID, Jr.  
Notary Public, Ramsey County, Minn.  
My commission expires Sept. 26, 1958