

I hereby certify to having surveyed the property described on this Plat as ALADDIN HOMESITES Roseville Ramsey County Minnesota and have placed iron monuments at all Lot corners as indicated and that the same is correct. There is no wet ground or any travelled road or easement on or across same except as shown

Edgar C. Swenson
Reg. Engr. & Surveyor
Cert. No. 567

State of Minnesota } ss
County of Ramsey }
On this 24th day of Sept AD 1955 before me personally appeared the undersigned Edgar C. Swenson to me known to be the person described in, and who executed the foregoing instrument and acknowledged that he executed the same as his own free act and deed

Notary Public Ramsey County, Minnesota
My Commission Expires Nov. 8, 1957

This is to certify that we Aladdin Improvement Co., Inc. a Minnesota corporation, proprietors of the following described property, The NW 1/4 of the NE 1/4 of Section 11, Township 29, Range 23, excepting therefrom portions thereof described as follows: except the East 26.5 feet of the West 870 feet of the NW 1/4 of said NW 1/4 of the NE 1/4; also except the South 602 feet of the West 693 feet of said NW 1/4 of the NE 1/4; also except the East 2 feet of the South 984.23 feet of the said NW 1/4 of the NE 1/4; also except the South 100 feet of the East 623.10 feet of said NW 1/4 of the NE 1/4; also except that portion of said NW 1/4 of the NE 1/4 lying in the highway known and described as County Road C, have caused the same to be surveyed and platted and hereafter shall be known as Aladdin Homesites as shown by this plat and hereby dedicate to the public for public use forever all streets, Avenues, Roads and easements as shown hereon.

Witness our hands and Seal this 21st day of Sept AD 1955

In presence of
Aladdin Improvement Company
by E. Magnuson
by Norman K. Magnuson

State of Minnesota } ss
County of Ramsey }
On this 21st day of Sept AD 1955 before me appeared E. A. Magnuson and Norman K. Magnuson who each being duly sworn did say that they are respectively the President and Secretary of the Aladdin Improvement Co., a Minnesota Corporation named in the foregoing instrument and the Seal affixed to same instrument is the Corporate seal of said Corporation and that said instrument was signed and sealed in behalf of said Corporation by authority of its Board of Directors and said President and said Secretary acknowledged said instrument to be the free act and deed of said Corporation

Notary Public Ramsey County, Minnesota
My Commission Expires


N. H. SKOGLUND
Notary Public, Ramsey County, Minn.
My Commission Expires Nov. 4, 1955.

Accepted and approved this 24th day of October AD 1955

Herbert West, Plat Commission
C. D. Spahr, Commissioner of Public Works
Frank Margitelli

Accepted and approved by the Council this 13 day of Sept 1955

Village Clerk Roseville

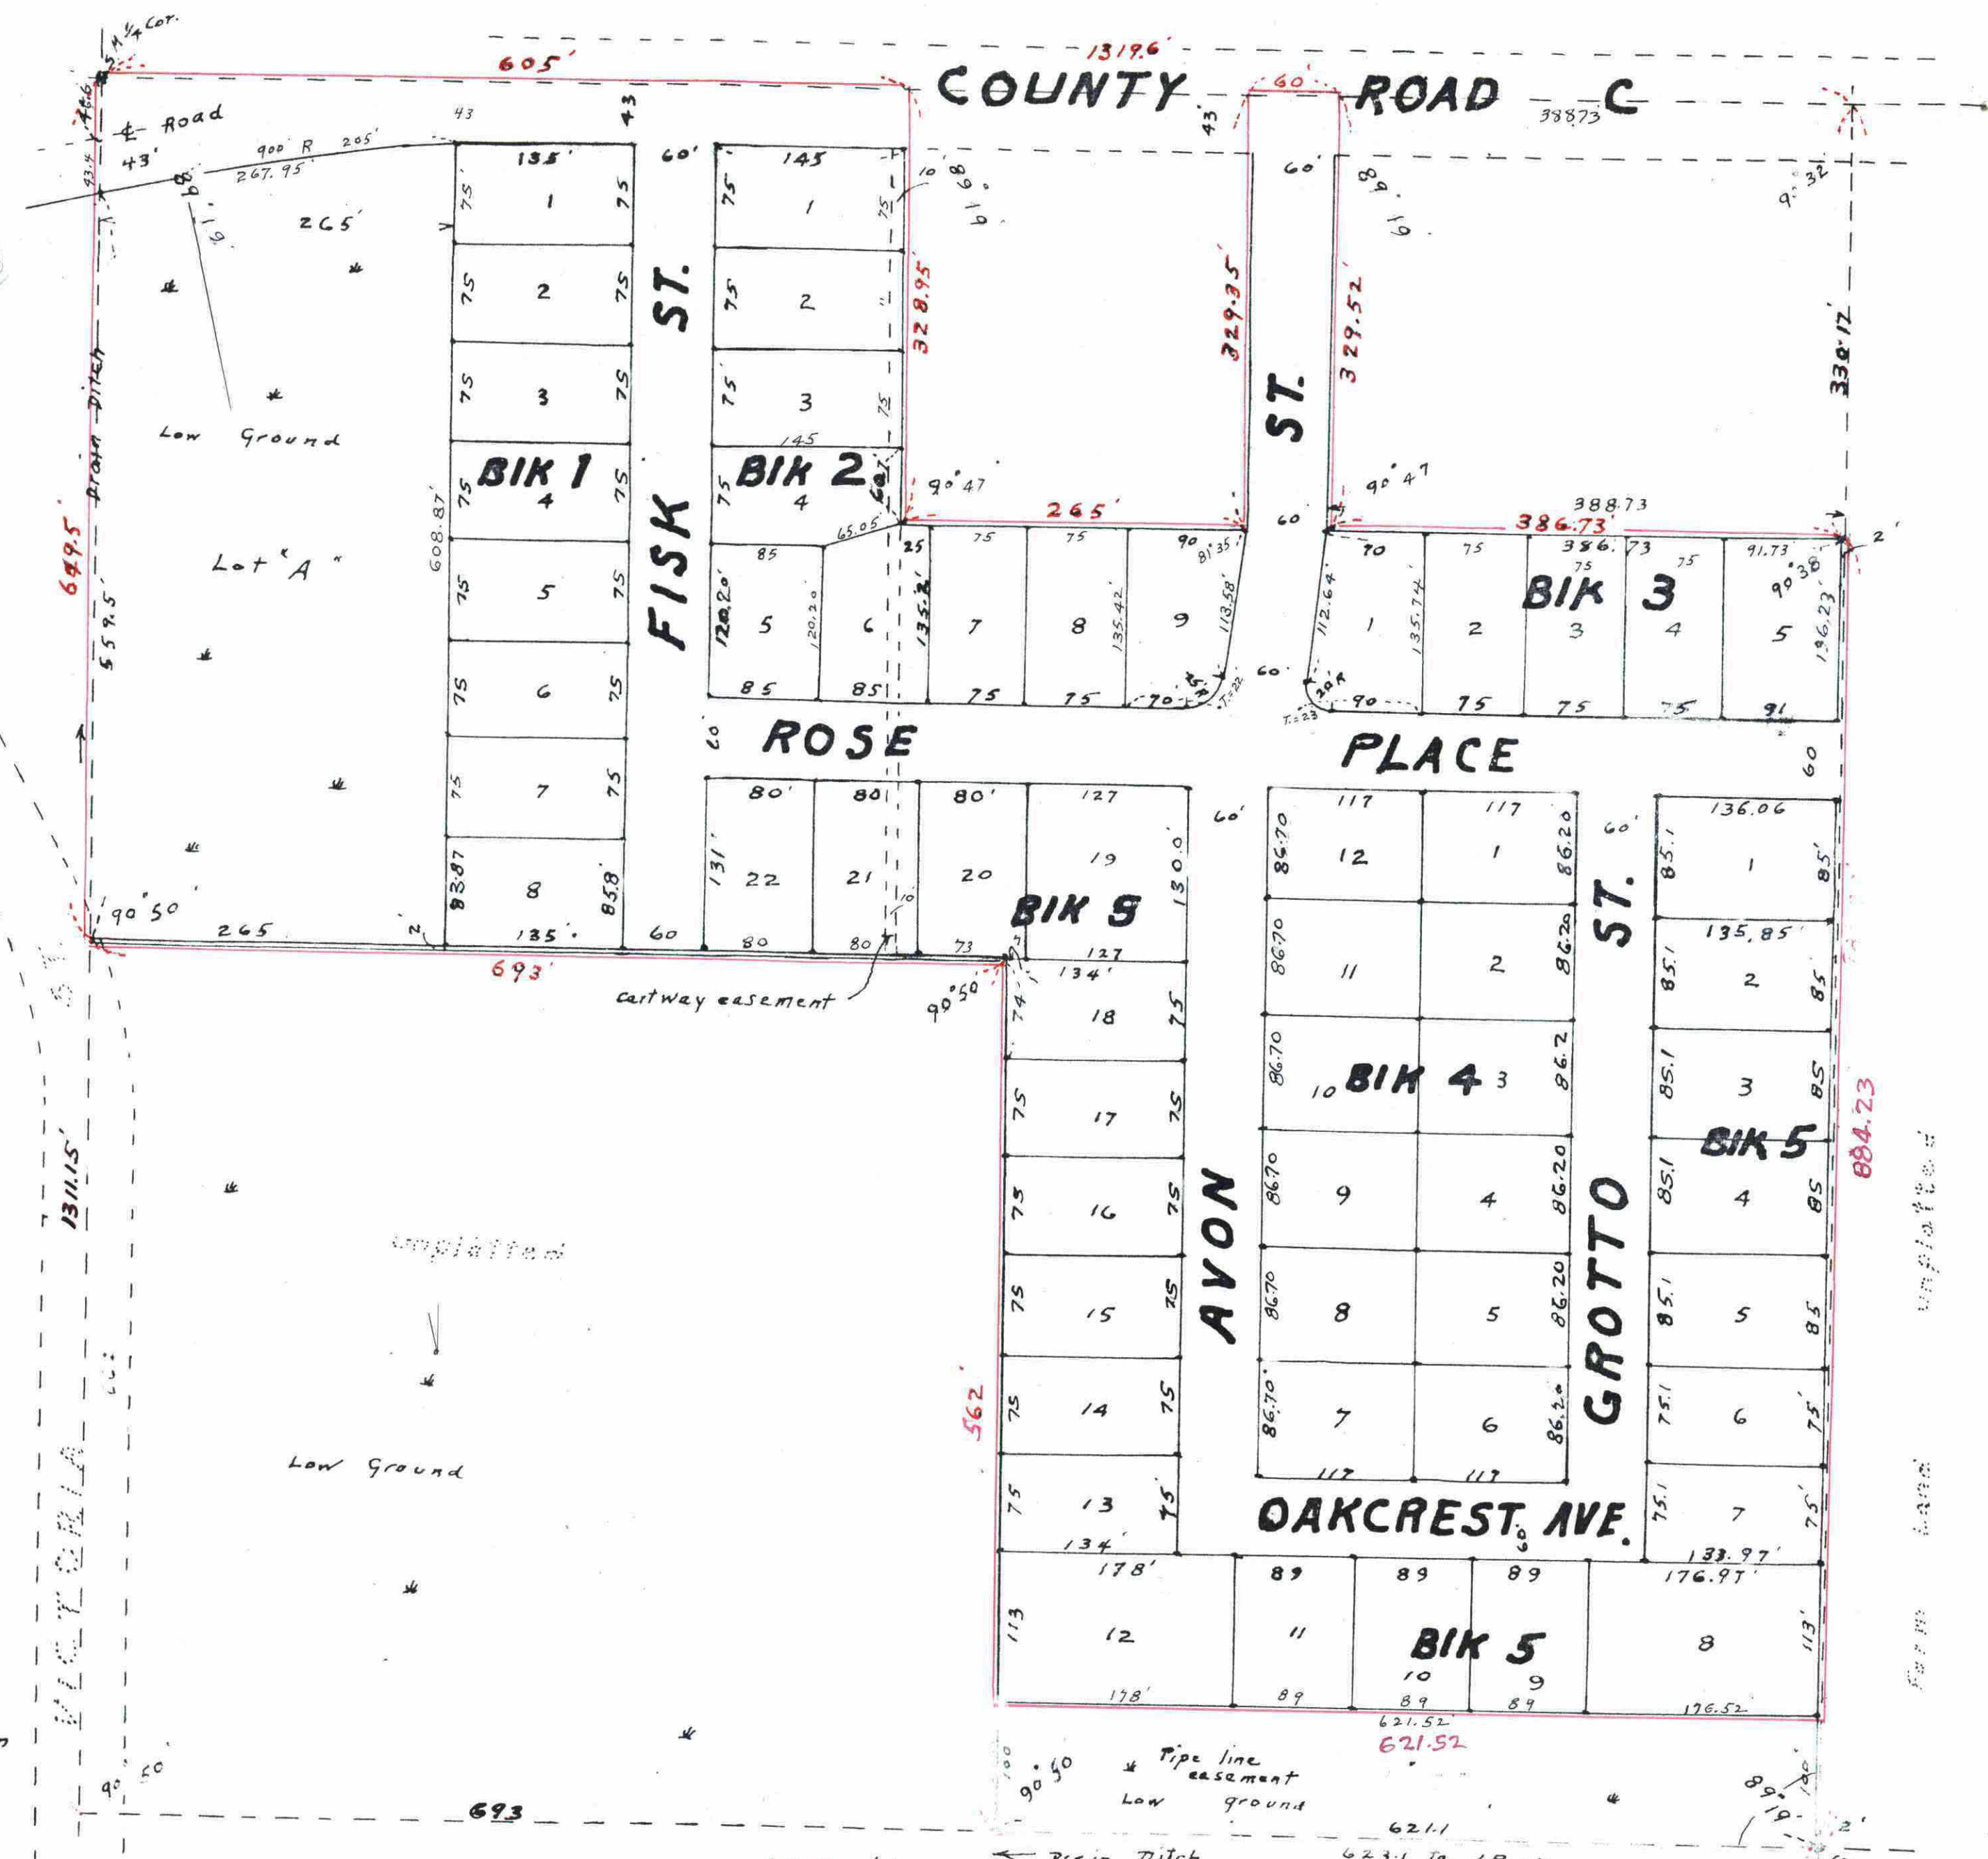

Taxes for the year 1954 on the lands described herein PAID
OCT 26 1955
EUGENE H. MANNIX, Auditor
RAMSEY COUNTY, MINN.

TAXES PAID AND TRANSFER ENTERED
OCT 26 1955
EUGENE H. MANNIX, Auditor
RAMSEY COUNTY, MINN.

ALADDIN HOMESITES
RAMSEY COUNTY, MINN.
Scale 1" = 100 ft. ROSEVILLE
Indicates irons * Low Ground

Edgar C. Swenson
Reg. Surveyor

STATE OF MINNESOTA } ss
County of Ramsey }
Office of the Register of Deeds
This is to certify that the within instrument was filed for record in this office at St. Paul on the 28 day of October A.D. 1955, at 9 o'clock P.M., and that the same was duly recorded in book 68 of Town Plats, page 8
By: [Signature]
Deputy Register of Deeds

1381815