

# EASTVIEW ADDITION NO. 3 ST. PAUL MINNESOTA

SCALE 1 INCH = 100 FEET  
INDICATES IRON MON.

JOHN A. WIELDE  
SURVEYOR

1392147

18

This is to certify that Tobin-Smith Inc., a Minnesota corporation, Owner, and the American National Bank of St. Paul, Minn., Mortgagee, of Block Eighteen (18) in Stinson's Frances Street Addition; and Lots One (1), Two (2), Twenty-one (21) and Twenty-two (22) in Eret's Addition; and Blocks Three (3), Four (4), Seven (7) and Eight (8), and Lots One (1) and Two (2), Block Sixteen (16) in Auditor's Subdivision Number Sixty-two (62) in St. Paul, Ramsey County, Minnesota according to the recorded plat thereof on file and recorded in the office of Register of Deeds in and for said County have caused the same to be surveyed and platted and hereafter known as Eastview Addition No. 3 as shown by this plat and hereby dedicates to the public and for the public use forever all streets and avenues as shown.


Witness our hands and seal this 3rd day of February 1956  
In presence of

Harold E. Heister  
John A. Schmidt  
W. J. Hill  
Thomas Puck

Tobin-Smith, Inc.  
By Edward M. Smith, President  
By Edward C. Smith, Vice Pres.  
The American National Bank of St. Paul  
By F. M. Bies, Vice Pres.  
By A. P. Haller

STATE OF MINNESOTA } ss.  
County of Ramsey }  
Office of the Register of Deeds  

557.29 East and 34.22' South of 1/4 corner between Secs. 33 34, T 29 N R. 22 W.

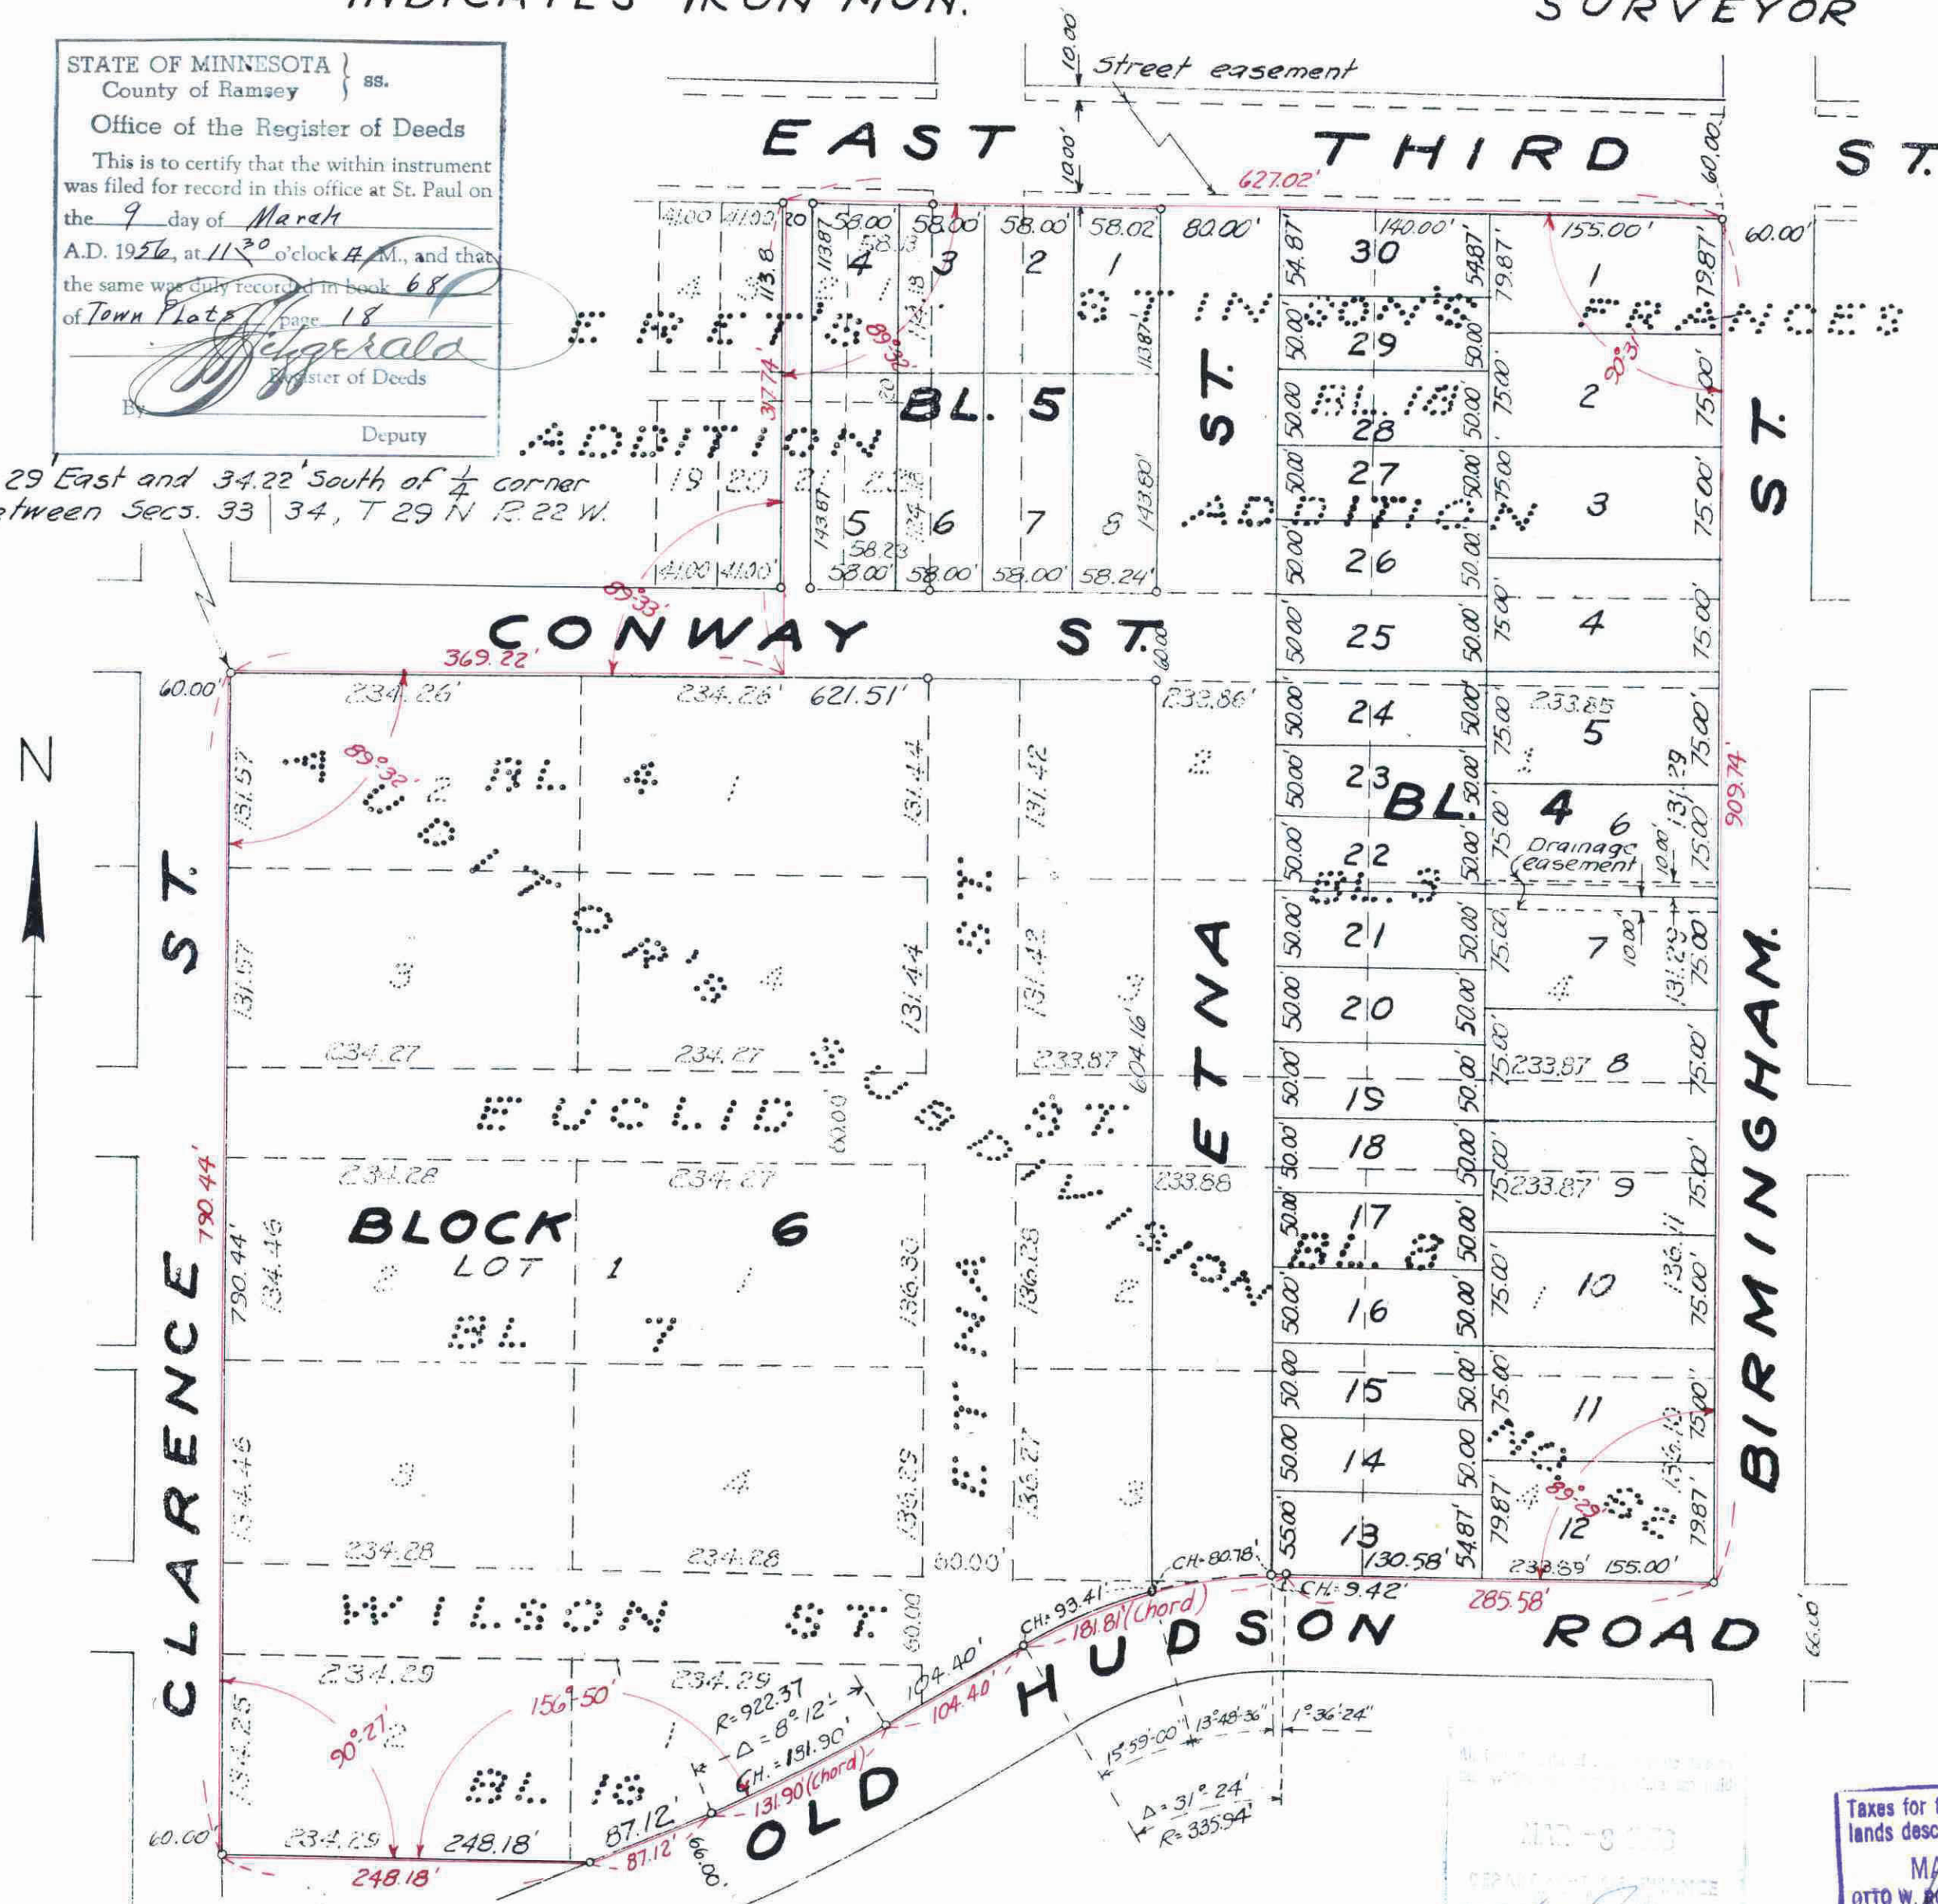

State of Minnesota } ss.  
County of Ramsey }

On this 3rd day of February A.D. 1956 before me a Notary Public within and for said County, personally appeared Edward M. Smith and Chester M. Tobin to me personally known, who, being each by me duly sworn they did say that they are respectively the Vice Pres. and the President of the Corporation named in the foregoing instrument, and that the seal affixed to said instrument is the corporate seal of said corporation, and that said instrument was signed and sealed in behalf of said corporation by authority of its board of directors and said Edward M. Smith and said Chester M. Tobin acknowledged said instrument to be the free act and deed of said corporation.

John A. Schmidt  
Notary Public Ramsey County, Minnesota  
My Commission expires \_\_\_\_\_

State of Minnesota } ss.  
County of Ramsey }

On this 3rd day of February A.D. 1956 before me a Notary Public within and for said County, personally appeared F.M. Bies and A.P. Haller to me personally known, who, being each by me duly sworn they did say that they are respectively the Vice Pres. and the Cashier of the Corporation named in the foregoing instrument, and that the seal affixed to said instrument is the corporate seal of said corporation, and that said instrument was signed and sealed in behalf of said corporation by authority of its board of directors and said F.M. Bies and said A.P. Haller acknowledged said instrument to be the free act and deed of said corporation.

W. J. Hill  
Notary Public Ramsey County, Minnesota  
My Commission expires May 25, 1961

Accepted by the council FEBRUARY 23 A.D. 1956

Approved FEBRUARY 23 A.D. 1956

Joseph R. Okonishi City Clerk

Accepted and approved this 17th day of February A.D. 1956

Herbert S. West  
Alvah D. Coon  
C. D. Forbes  
Frank M. Magistelli  
Plat Commission  
Commissioner of Public Works

Taxes for the year 1955 on the lands described herein PAID  
MAR 8 - 1956  
OTTO W. KOHLAND, JR., Treasurer  
RAMSEY COUNTY, MINNESOTA

TAXES PAID AND TRANSFER ENTERED  
MAR 8 1956  
EUGENE A. MONICK, Auditor  
RAMSEY COUNTY, MINN.

I hereby certify to having surveyed the property described on this plat as Eastview Addition No. 3 and have placed iron monuments at the corners shown and the same is correct. There is no low wet ground nor any travelled road or easement on or across same except as shown.

John A. Wielde  
Registered Surveyor  
Minnesota Certificate No. 3443

State of Minnesota } ss.  
County of Ramsey }

On this 3rd day of February A.D. 1956 before me, the undersigned, personally appeared John A. Wielde to me known to be the person described in and who executed the foregoing instrument and acknowledged that he executed the same as his free act and deed.

John A. Schmidt  
Notary Public, Ramsey County, Minnesota  
My Commission expires \_\_\_\_\_

This plat document is an UNOFFICIAL copy of a Subdivision Plat or Registered Land Survey and is made available for information purposes only.

To obtain an official copy please contact the Ramsey County Recorder's Office.



1392147