


BEL-AIR PARK NO. 2 CITY OF WHITE BEAR LAKE RAMSEY COUNTY, MINNESOTA

SCALE 1"=100'

CHARLES O. GEORGI COMPANY
CIVIL ENGINEERING & LAND SURVEYING

NOT PLATTED

Qtr. Qtr. Line

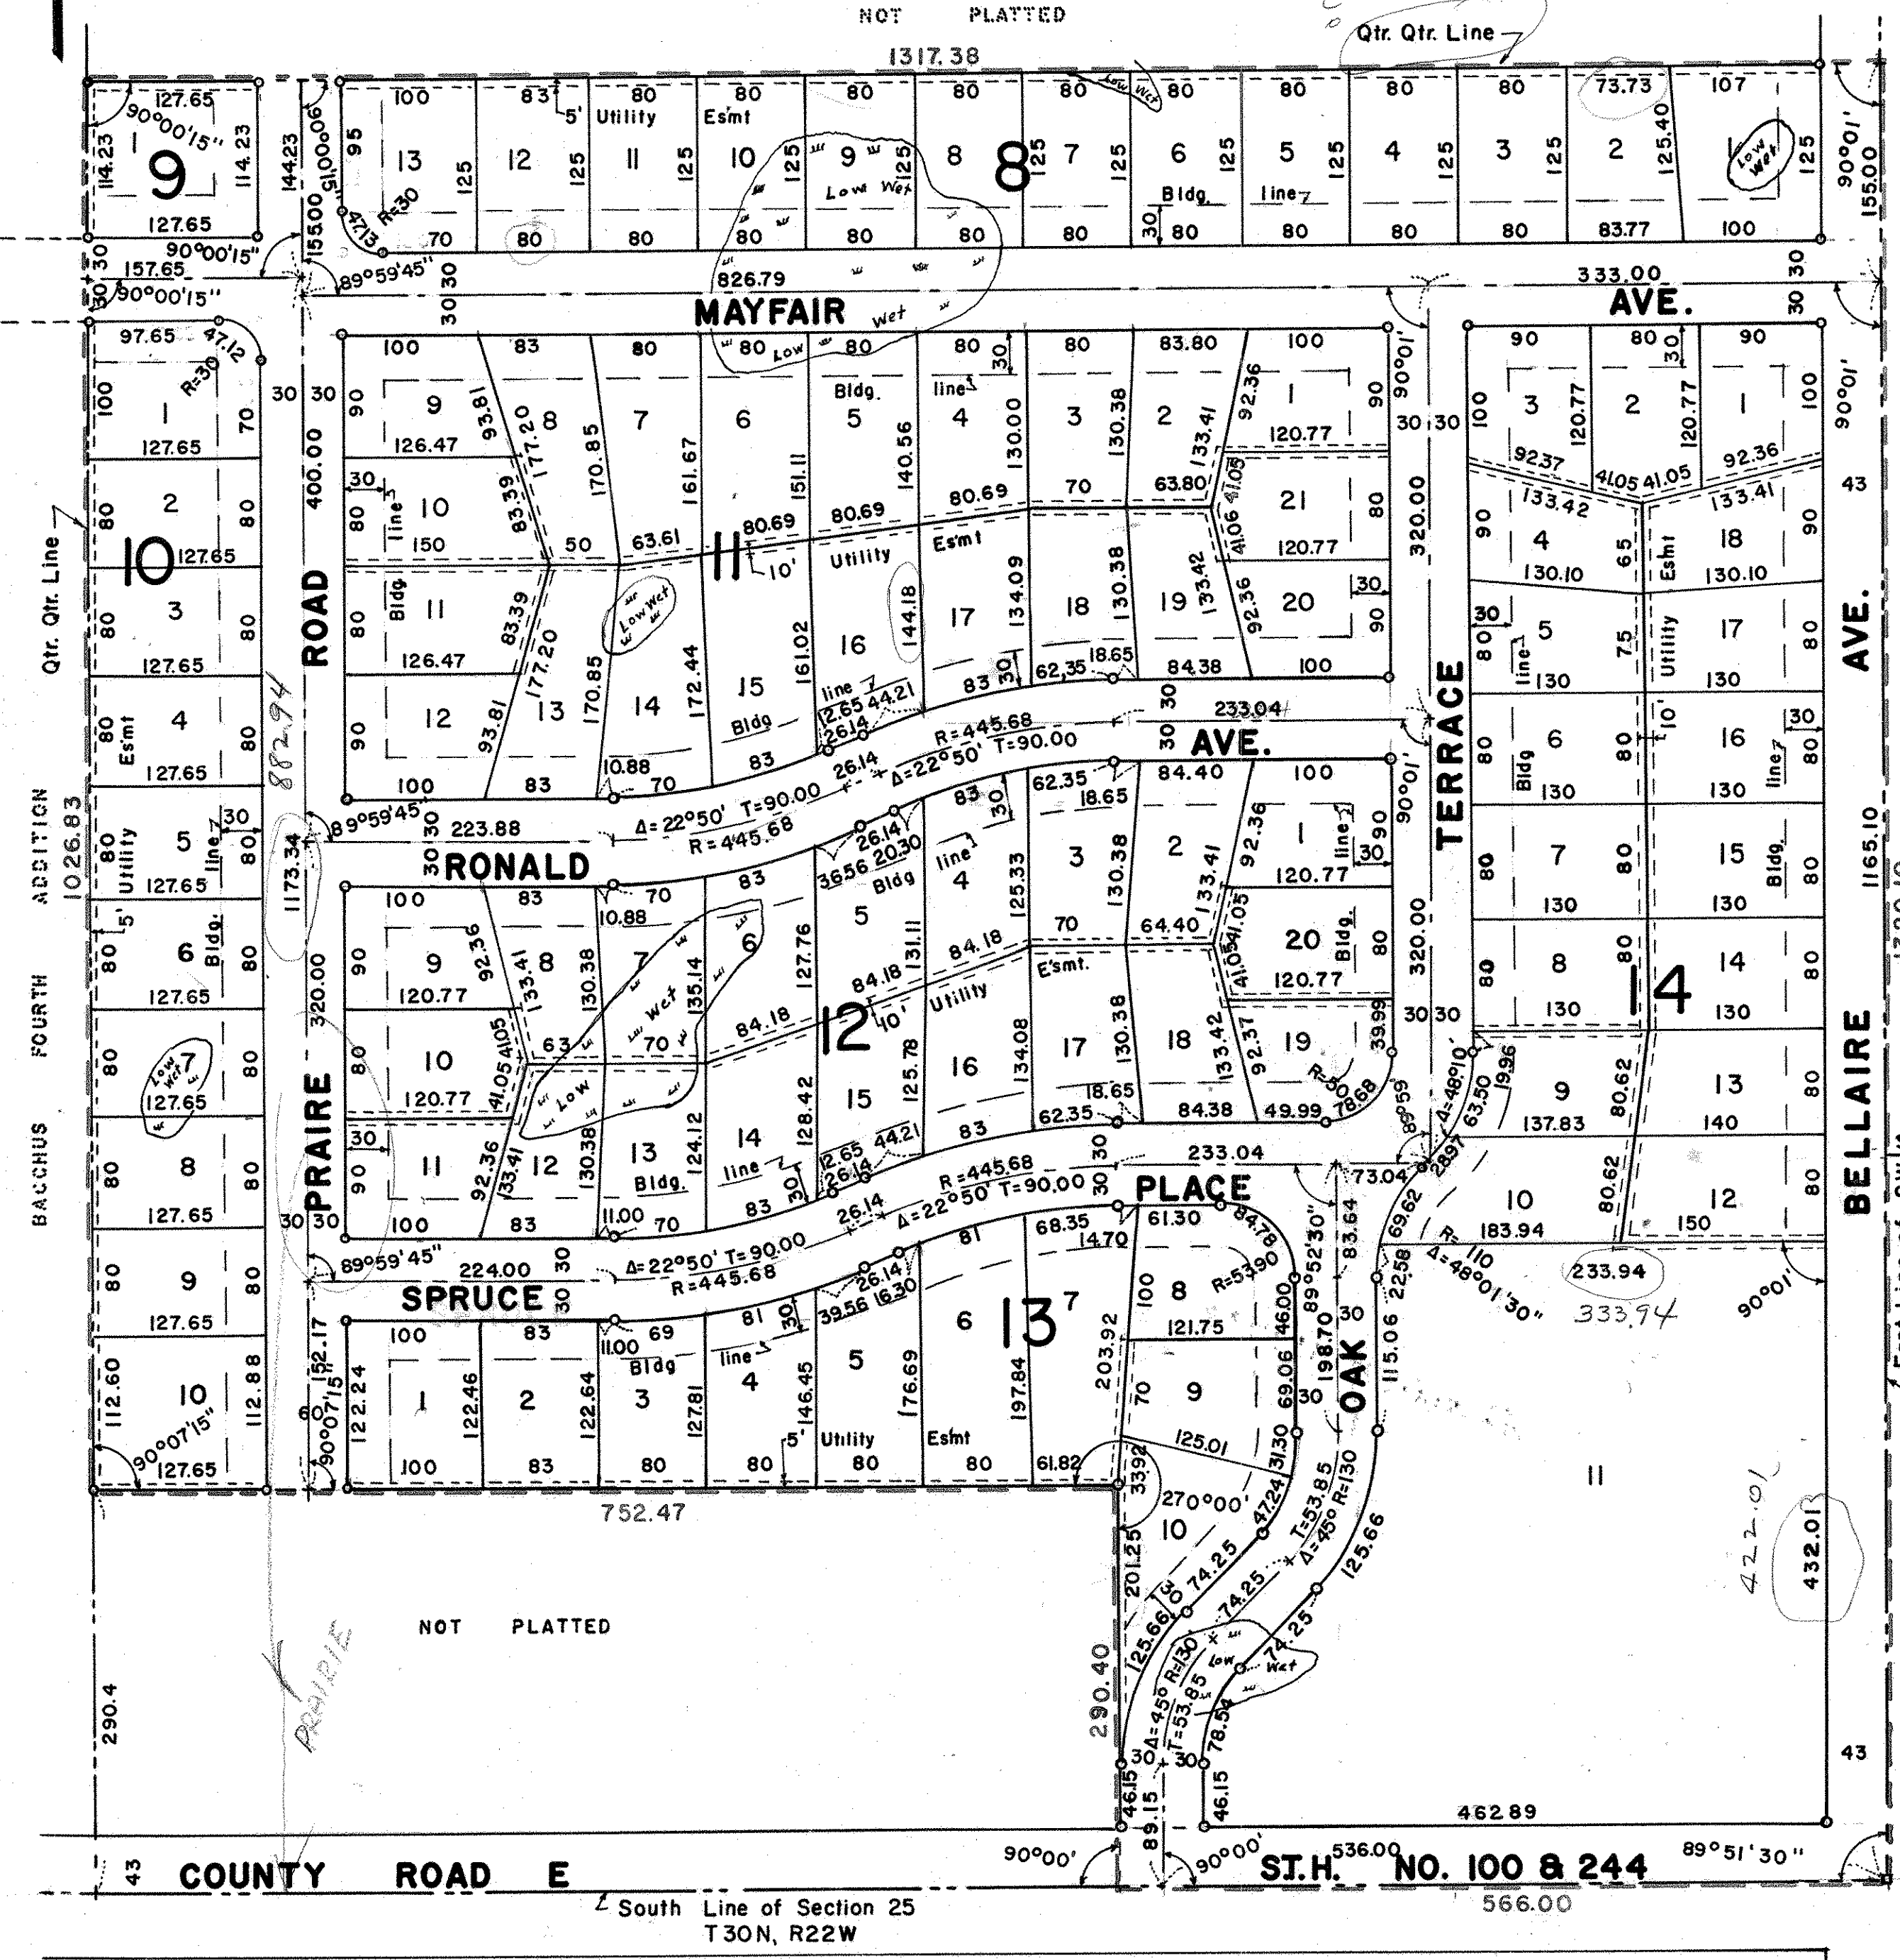

This is to certify that we, THEODORE GLASRUD and LORAIN GLASRUD, his wife; and CYRIL E. SHEEHY and ALVIRA SHEEHY, his wife owners of:

The Southeast 1/4 of the Southwest 1/4 of Section 25, T30N, R22W, except that portion taken for Bellaire Avenue and County Road E, and except that part of the South 290.4 feet lying West of a line extended Northerly at right angles to and from a point on the South line thereof distant 566 feet West of the Southeast corner thereof,

have caused the same to be surveyed and platted and hereafter known as BEL-AIR PARK NO. 2 as shown by this plat, and hereby dedicate to the public and for public use forever all streets, avenues, roads and easements as shown hereon.

Witness our hands and seals this 10th day of August 1959

In the presence of:

Theodor Glasrud
 Loraine Glasrud
 Cyril E. Sheehy
 Alvira S. Sheehy

State of Minnesota)
County of Ramsey)s.s

On this 10th day of November A.D. 1959 before me the undersigned personally appeared Theodore Glasrud and Loraine Glasrud, his wife; and Cyril E. Sheehy and Alvira Sheehy, his wife to me known to be the persons described in and who executed the foregoing instrument and acknowledge that they executed the same as their free act and deed.

Notary Public, Ramsey County, Minn. My Commission expires Sept. 23, 1960

I hereby certify to having surveyed the property described on this plat as Bel-Air Park No. 2 and have placed iron monuments at the corners shown and the same is correct. There is no low wet ground nor any traveled road or easement on or across same except as shown.

Registered Land Surveyor
 Minnesota Certificate No. 3960

State of Minnesota)
County of Ramsey)s.s

On this 12th day of Oct. A.D. 1959 before me the undersigned personally appeared Charles O. Georgi to me known to be the person in and who executed the foregoing instrument and acknowledge that he executed the same as his free act and deed.

Notary Public, Ramsey County, Minn. My Commission Expires June 22, 1962

Accepted and approved by the City Council of the City of WHITE BEAR LAKE on this 13th day of October 1959

City Clerk

Accepted and approved this 17th day of December 1959

Plat Commission
 Commissioner of Public Works

Recorded Dec. 23, 1959
Abstract #1501301

o Denotes Iron Monument
All distances shown on curves are arc lengths