


# WITT'S LAKESIDE MAPLEWOOD, MINN.

SCALE - 1 IN. = 100 FT.  
O INDICATES IRON MONUMENT

R.C. WOLFGRAM  
SURVEYOR

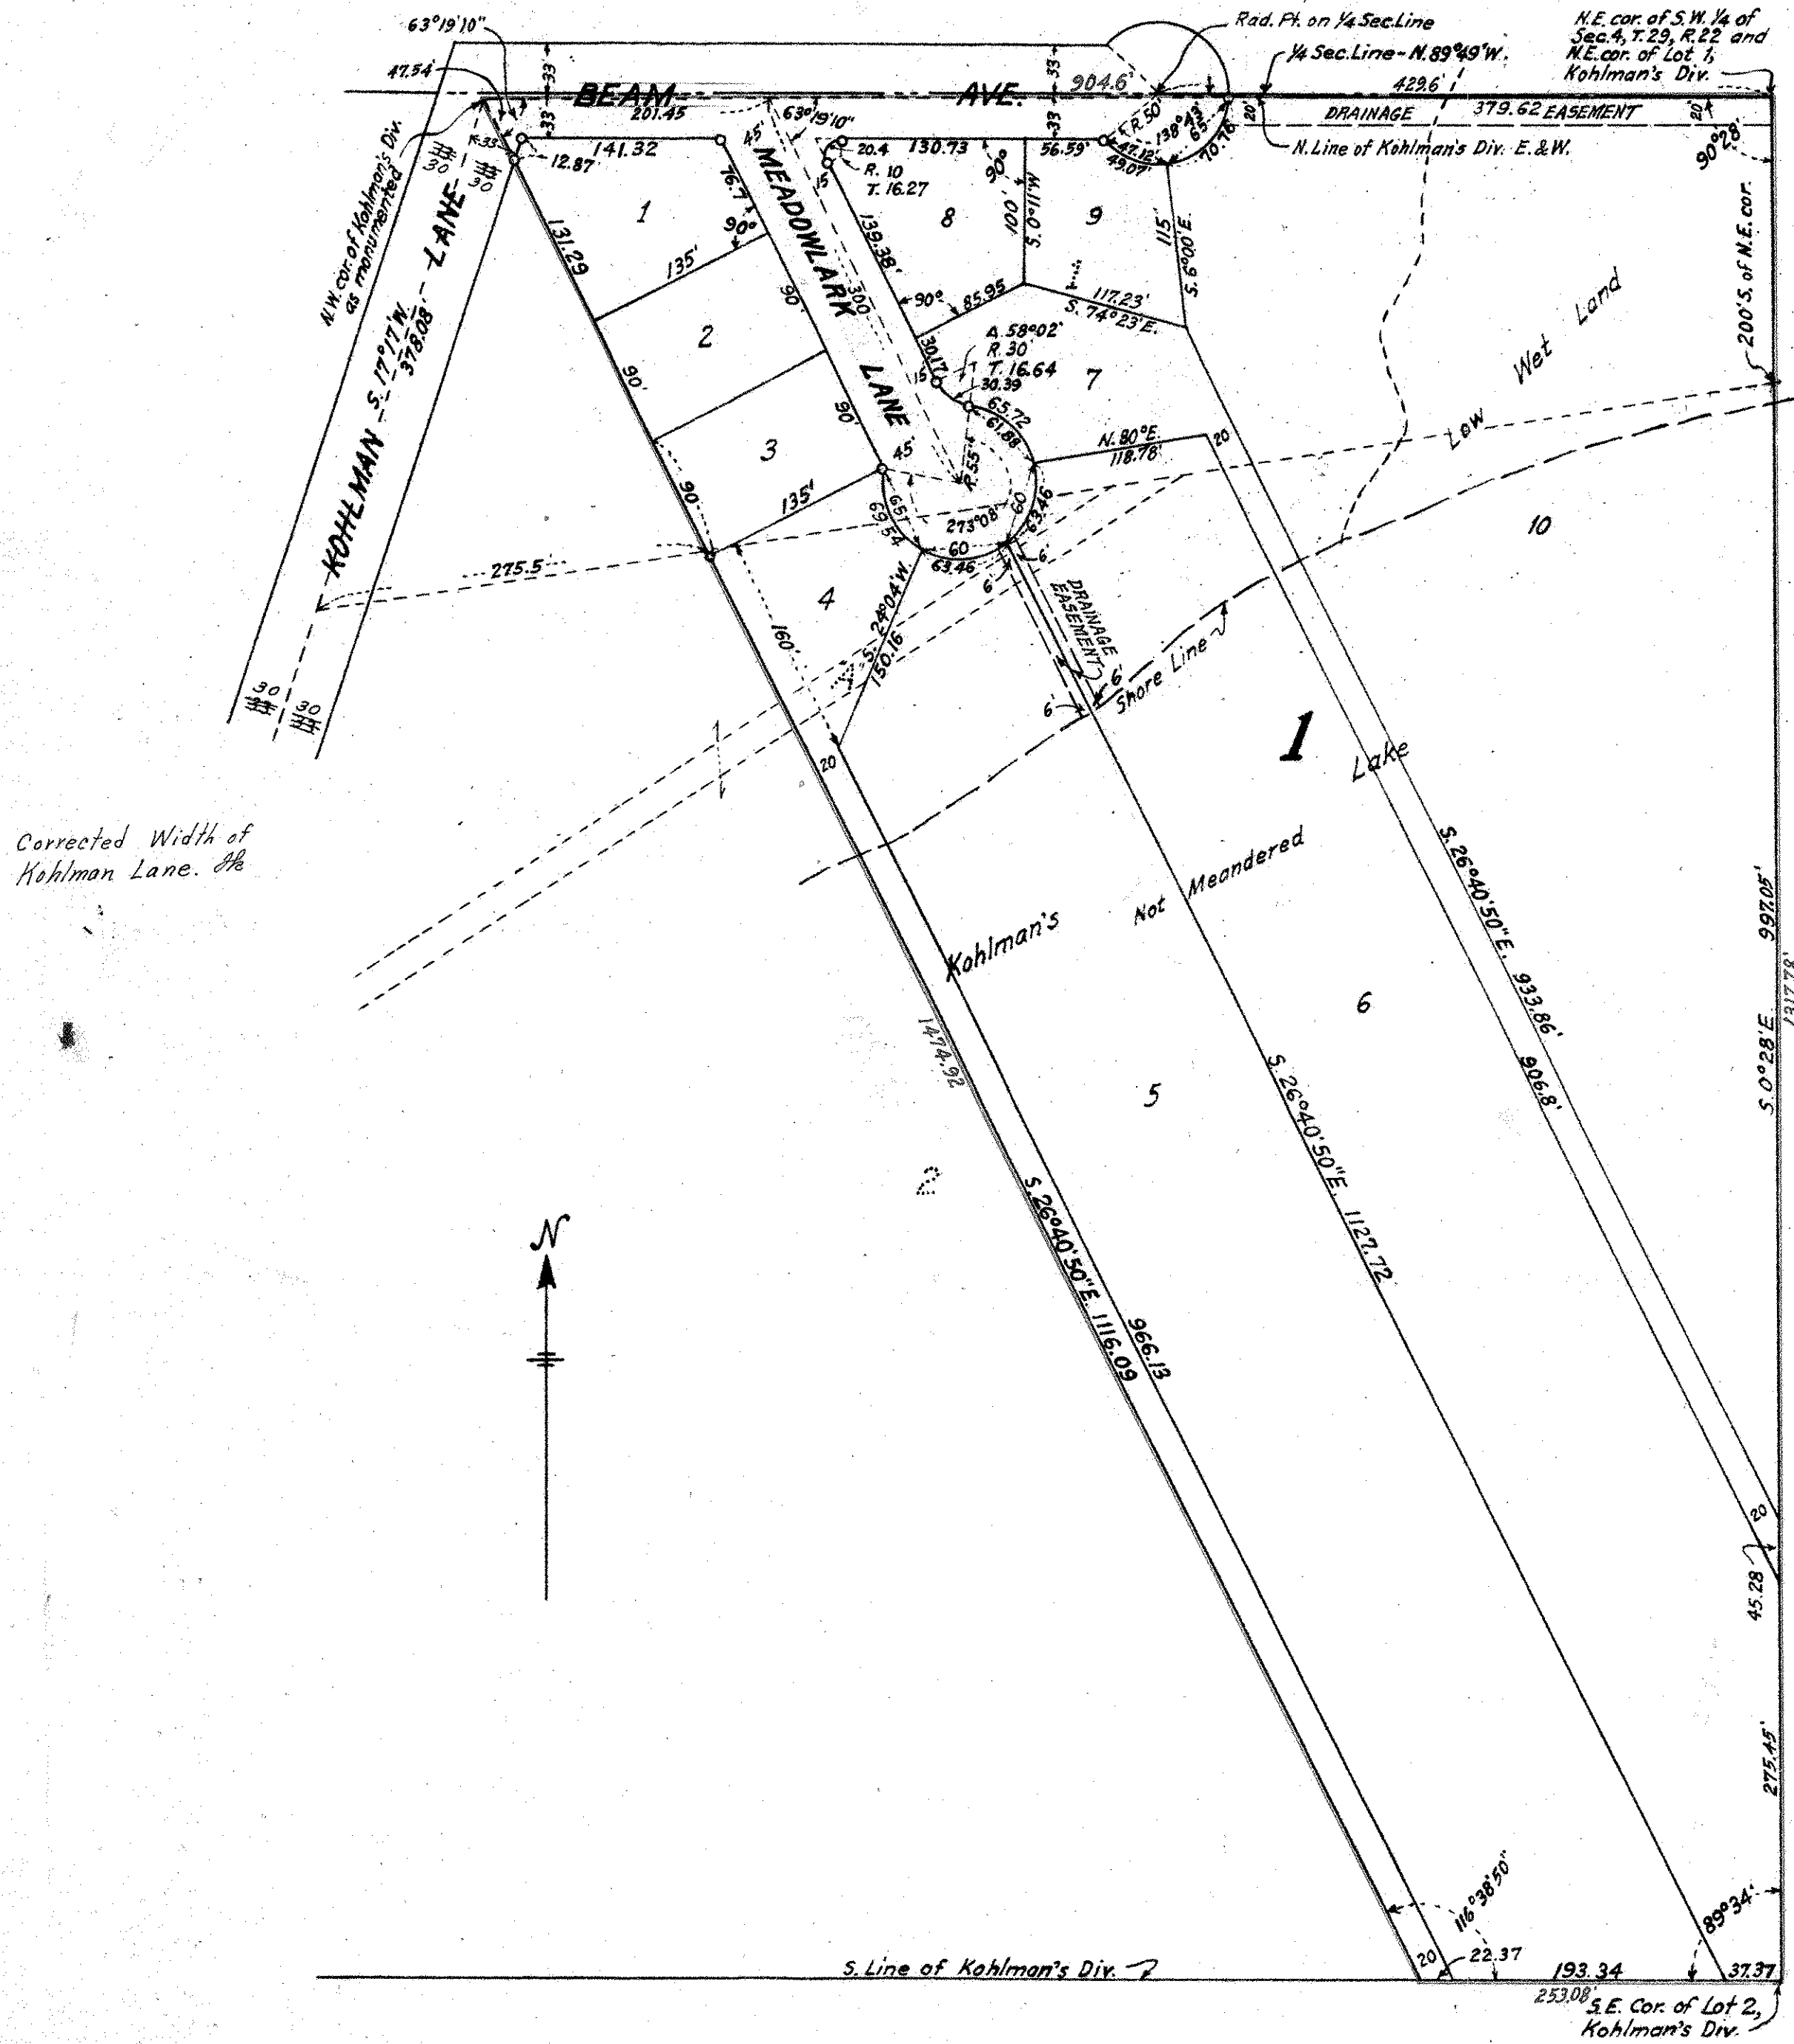

I hereby certify to having surveyed the property described on this plat as Witt's Lakeside and have placed iron monuments at the corners shown and the same is correct.

There is no low wet ground nor any traveled road or easement on or across the same except as shown.

*R.C. Wolgram*  
Registered Land Surveyor  
Minnesota Certificate No. 1340

State of Minnesota } S.S.  
County of Ramsey }  
On this 2 day of July A. D. 1960 before me the undersigned personally appeared R. C. Wolgram, to me known to be the person described in and who executed the foregoing instrument and acknowledged that he executed the same as his free act and deed.

*John P. Dickson*  
Notary Public, Ramsey County, Minnesota.  
My commission expires 6-2-61

This is to certify that we, Frank A. J. Witt and Marie H. Witt, husband and wife, owners of all that part of Lots "A", one (1) and two (2) lying Northeasterly of a line running Southeasterly from the Northwest corner of Lot 1 to the South line of Lot two (2), Kohlman's Division passing through a point on the South line of said Lot one (1) distant 275.5 feet Easterly from the Southwest corner of said Lot one (1), all in Kohlman's Division, according to the plat thereof on file and of record in the office of Register of Deeds in and for Ramsey County, Minnesota, have caused the same to be surveyed and platted and hereafter known as Witt's Lakeside as shown by this plat, and hereby dedicate to the public and for the public use forever all lanes, avenues and drainage easements as shown.

Witness our hands and seals this 12<sup>th</sup> day of July A. D. 1960.

In presence of  
*Edward J. Peiffer*  
*C. Falkmann*  
*Frank A. J. Witt*  
*Marie H. Witt*

State of Minnesota } S.S.  
County of Ramsey }  
On this 12<sup>th</sup> day of July A. D. 1960 before me the undersigned personally appeared Frank A. J. Witt and Marie H. Witt, husband and wife, to me known to be the persons described in and who executed the foregoing instrument and acknowledged that they executed the same as their free act and deed.

*Clarence D. Beckmann*  
Notary Public, Ramsey County, Minnesota.  
My commission expires Jan. 14, 1962

Accepted by the Council August 11 A. D. 1960.

Approved August 11 A. D. 1960.  
*James M. Nelson*  
Village Clerk  
Maplewood, Minnesota.

Accepted and approved this 16<sup>th</sup> day of August A. D. 1960.

*Alvah R. Crampton*  
*Eug. P. ...*  
*B. Pleig*  
*Milton Rosen*  
Flat Commission  
Commissioner of Public Works