

St Paul Minn Dec 4th 1885.

For Deeds correcting the numbering of the Lots in Block 7, see 242 of Deeds page 633-637
M. J. Bell
Register of Deeds

EDMUND RICE'S FOURTH ADDITION

SCALE 1 INCH = 100 FEET.

This plat document is an UNOFFICIAL copy of a Subdivision Plat or Registered Land Survey and is made available for information purposes only.
To obtain an official copy please contact the Ramsey County Recorder's Office.

ADDITION and have placed iron monuments at the corners of each and every block as shown on this map, and the same is correct.
D. L. Curtice, Surveyor.

State of Minnesota } On this 12th day of December A.D. 1885 before me the undersigned personally
County of Ramsey. } appeared D. L. Curtice to me well known, and acknowledged that he executed the foregoing certificate as his own free act and deed.

William C. Easton
Notary Public
Ramsey County Minn.

This is to certify that we Edmund Rice and Anna M. Rice his wife, the owners of Blocks numbered 1, 2, 3, 4, 6, 7, 8, 9, 10, 11, Lots 1, 2, 3 & 4 Block 12, & Lots 1, 2, 3, 4, 5, 6, 10 & 11 Block 17 all in "Edmund Rice's Trout Brook Addition to the City of St Paul" as the same is recorded in the office of the Register of Deeds, Ramsey County, Minn and have caused the same to be surveyed and platted, and hereafter known as EDMUND RICE'S FOURTH ADDITION as shown by this plat and hereby dedicate to the public, and for the public use forever, all the streets and alleys as hereon indicated.

Witness our hands and seals this 12th day of December A.D. 1885.

In presence of
W. C. Easton
Edmund Rice

Anna M. Rice
Edmund Rice

State of Minnesota } On this 12th day of December A.D. 1885 before me the undersigned personally
County of Ramsey. } appeared Edmund Rice and Anna M. Rice his wife to me well known and acknowledged that they executed the foregoing certificate, as their free act and deed for the uses and purposes therein expressed.


William C. Easton
Notary Public
Ramsey County Minn.

Accepted and Approved this 12th day of Dec A.D. 1885
J. S. Johnson
J. W. Ramsey
Jas. Hartney
PLAT Commission.

Thereby recommend the acceptance of the within plat by the Common Council.
Dated St Paul Minn Dec 29th 1885.
L. W. Randall
City Engineer.


Accepted by the Common Council of the City of St Paul on the 29th day of Dec 1885.
W. H. W. W. W.
City Clerk.

St Paul Minn
Taxes paid and Transfers entered.
Dec 31. 1885
Jas O'Brien
County Auditor.
Ramsay Co.
Minn.
City Treasurer.
St Paul.
Minn.

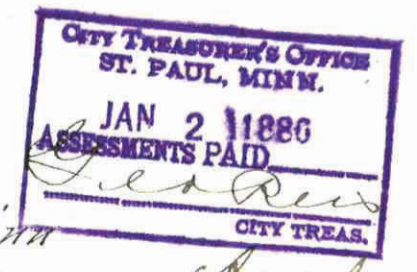

Office of COUNTY TREASURER,
ST. PAUL, MINN.
DEC 11 1885
1884 TAX PAID.
J. H. Winton
County Treas.

STATE OF MINNESOTA, J. J. Rice, Register of Deeds, County of Ramsey.
Office of the Register of Deeds.
This is to certify that the within plat was filed for Record in this Office, at St Paul, on the 12th day of January, A. D. 1886 at 3 o'clock P. M., and that the same was duly recorded in Book 336 of Deeds, pages 326-327.
R. G. Winkley
Register of Deeds.

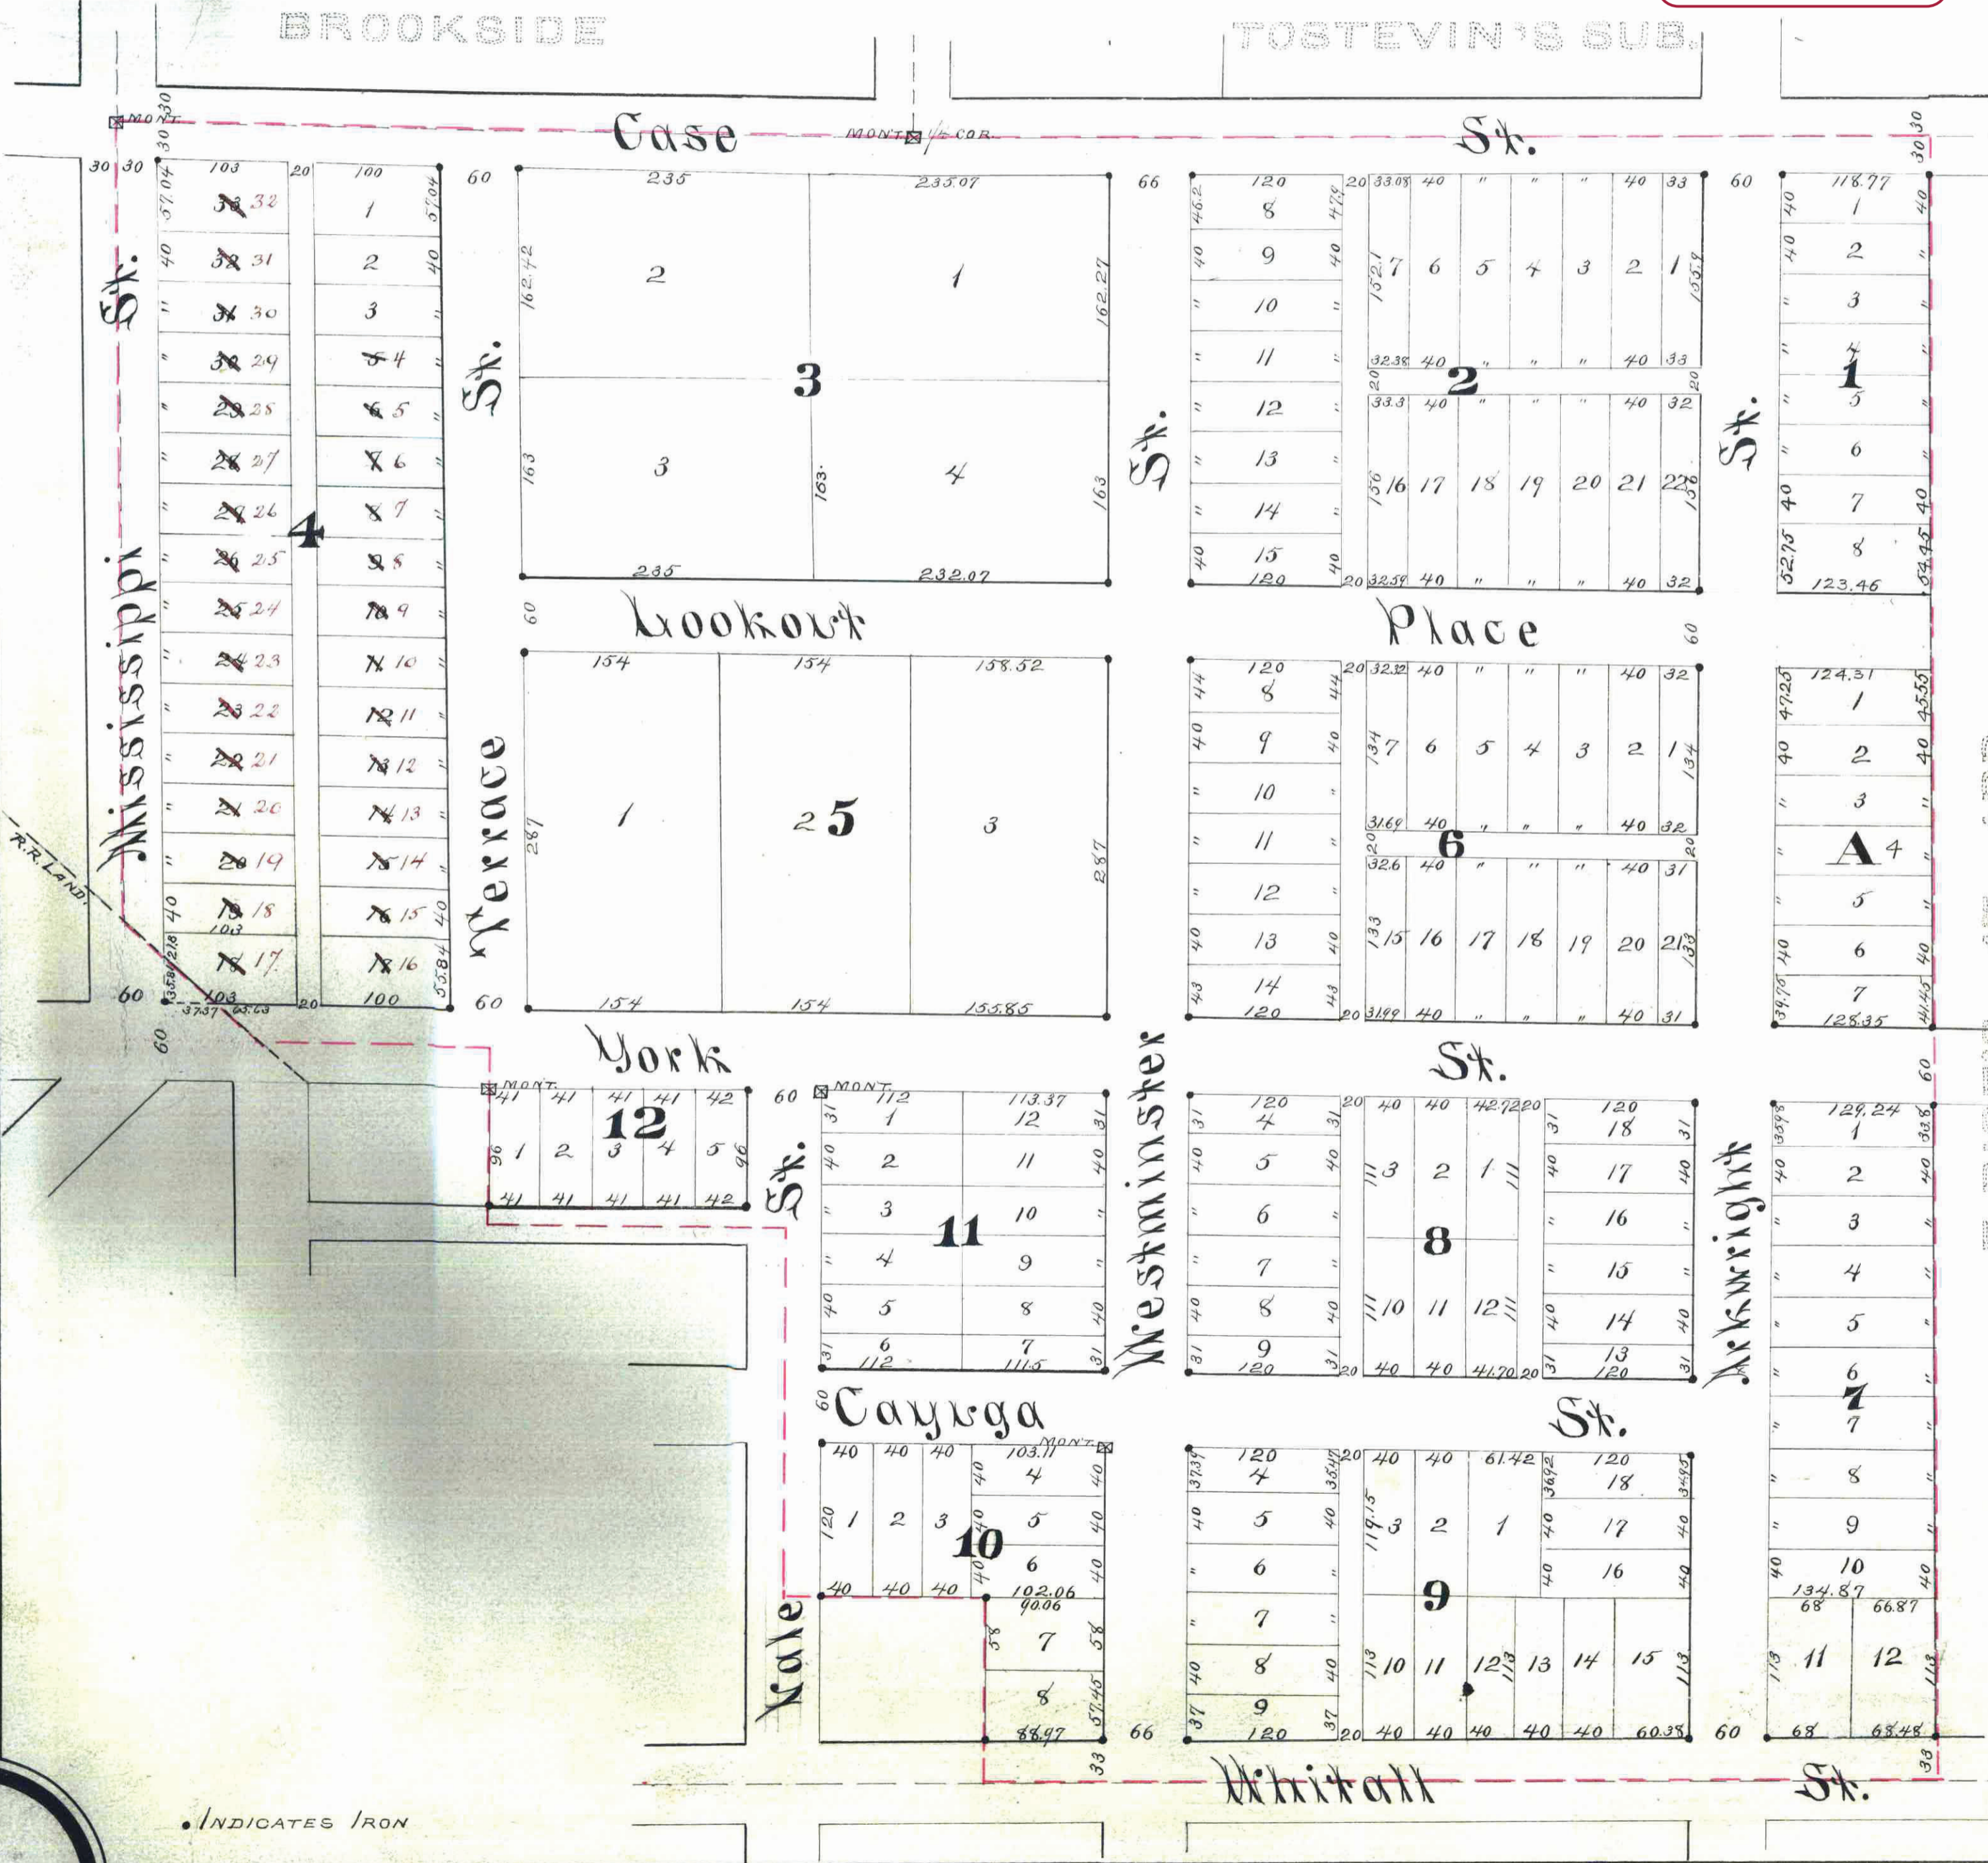

INDICATES IRON

DRAWN BY LOUISE M. BURGESS