

HAMILTON GREENS NO. 2

VILLAGE OF NEW BRIGHTON, RAMSEY COUNTY, MINNESOTA



Bearings are assumed

MILNER W. CARLEY & ASSOC.
SURVEYORS - ENGINEERS

• Denotes Iron Monument

SCALE: 1" = 50'

This is to certify that Keith A. Hamilton and Joyce E. Hamilton, husband and wife, owners of; and Soo Line Credit Union, a Minnesota Corporation, mortgagee of: The West 1/2 of the West 1/2 of the South 1/2 of the Southwest 1/4 of the Southeast 1/4 of Section 18, Town 30 N, Range 23 W, Ramsey County, Minnesota; have caused the same to be surveyed and platted and hereafter known as HAMILTON GREENS NO. 2, as shown by this plat, and hereby dedicate to the public and for the public use forever all roads and courts as shown; subject to easements as shown.

Witness our hands and seal this 15th day of AUGUST 1969 A.D.

In presence of:

Vincent J. Delle
Anna M. Dahle
R. J. Downey
P. M. Logrethow

Keith A. Hamilton Keith A. Hamilton - 635-
Joyce E. Hamilton Joyce E. Hamilton
SOO LINE CREDIT UNION
R. F. Blacic SECY.
W. W. Stabrow, TREAS.

STATE OF MINNESOTA } SS
COUNTY OF RAMSEY }

On this 15th day of AUGUST 1969 A.D. before me, the undersigned, personally appeared Keith A. Hamilton and Joyce E. Hamilton, husband and wife, to me known to be the persons described in and who executed the foregoing instrument and acknowledged that they executed the same as their free act and deed.

Vincent J. Delle
Notary Public, Ramsey County, Minnesota
My Commission expires March 5, 1971

STATE OF MINNESOTA } SS
COUNTY OF RAMSEY }

On this 15 day of AUGUST 1969 A.D. before me, the undersigned, personally appeared R. F. Blacic and W. W. Stabrow, who each being duly sworn did say that they are the SECRETARY and TREASURER respectively of SOO LINE CREDIT UNION, a Minnesota Corporation, the corporation named in the foregoing instrument and said instrument was signed in behalf of said corporation by authority of its Board of Directors, and said SECRETARY and TREASURER acknowledged that said instrument to be the free act and deed of said corporation.

Edward H. Etkin
Notary Public, Hennepin County, Minnesota
My Commission expires December 13, 1971

I hereby certify to having surveyed the property described on this plat as HAMILTON GREENS NO. 2 and have placed iron monuments at the corners as shown and the same is correct. There is no low wet ground nor any traveled road or easement on or across same except as shown.

Donald F. Meyer
Registered Surveyor, Minn. Cert. No. 3051

STATE OF MINNESOTA } SS
COUNTY OF RAMSEY }

On this 29th day of July 1969 A.D. before me, the undersigned, personally appeared Donald F. Meyer to me known to be the person described in and who executed the foregoing instrument and acknowledged that he executed the same as his free act and deed.

Daune Cronquist
Notary Public, Ramsey County, Minnesota
My Commission Expires April 29, 1970


ACCEPTED AND APPROVED THIS 27th DAY OF August 1969 A.D.

Walter J. Bremer)
Sy. Roberts) Plat Commission
Robert F. Cutler) Commissioner of Public Works

Accepted and approved by the Village Council, Village of New Brighton this 12 day of August 1969 A.D.

Vernon Pederson
Village Clerk, Village of New Brighton Abstract #1757000

Recorded August 27, 1969

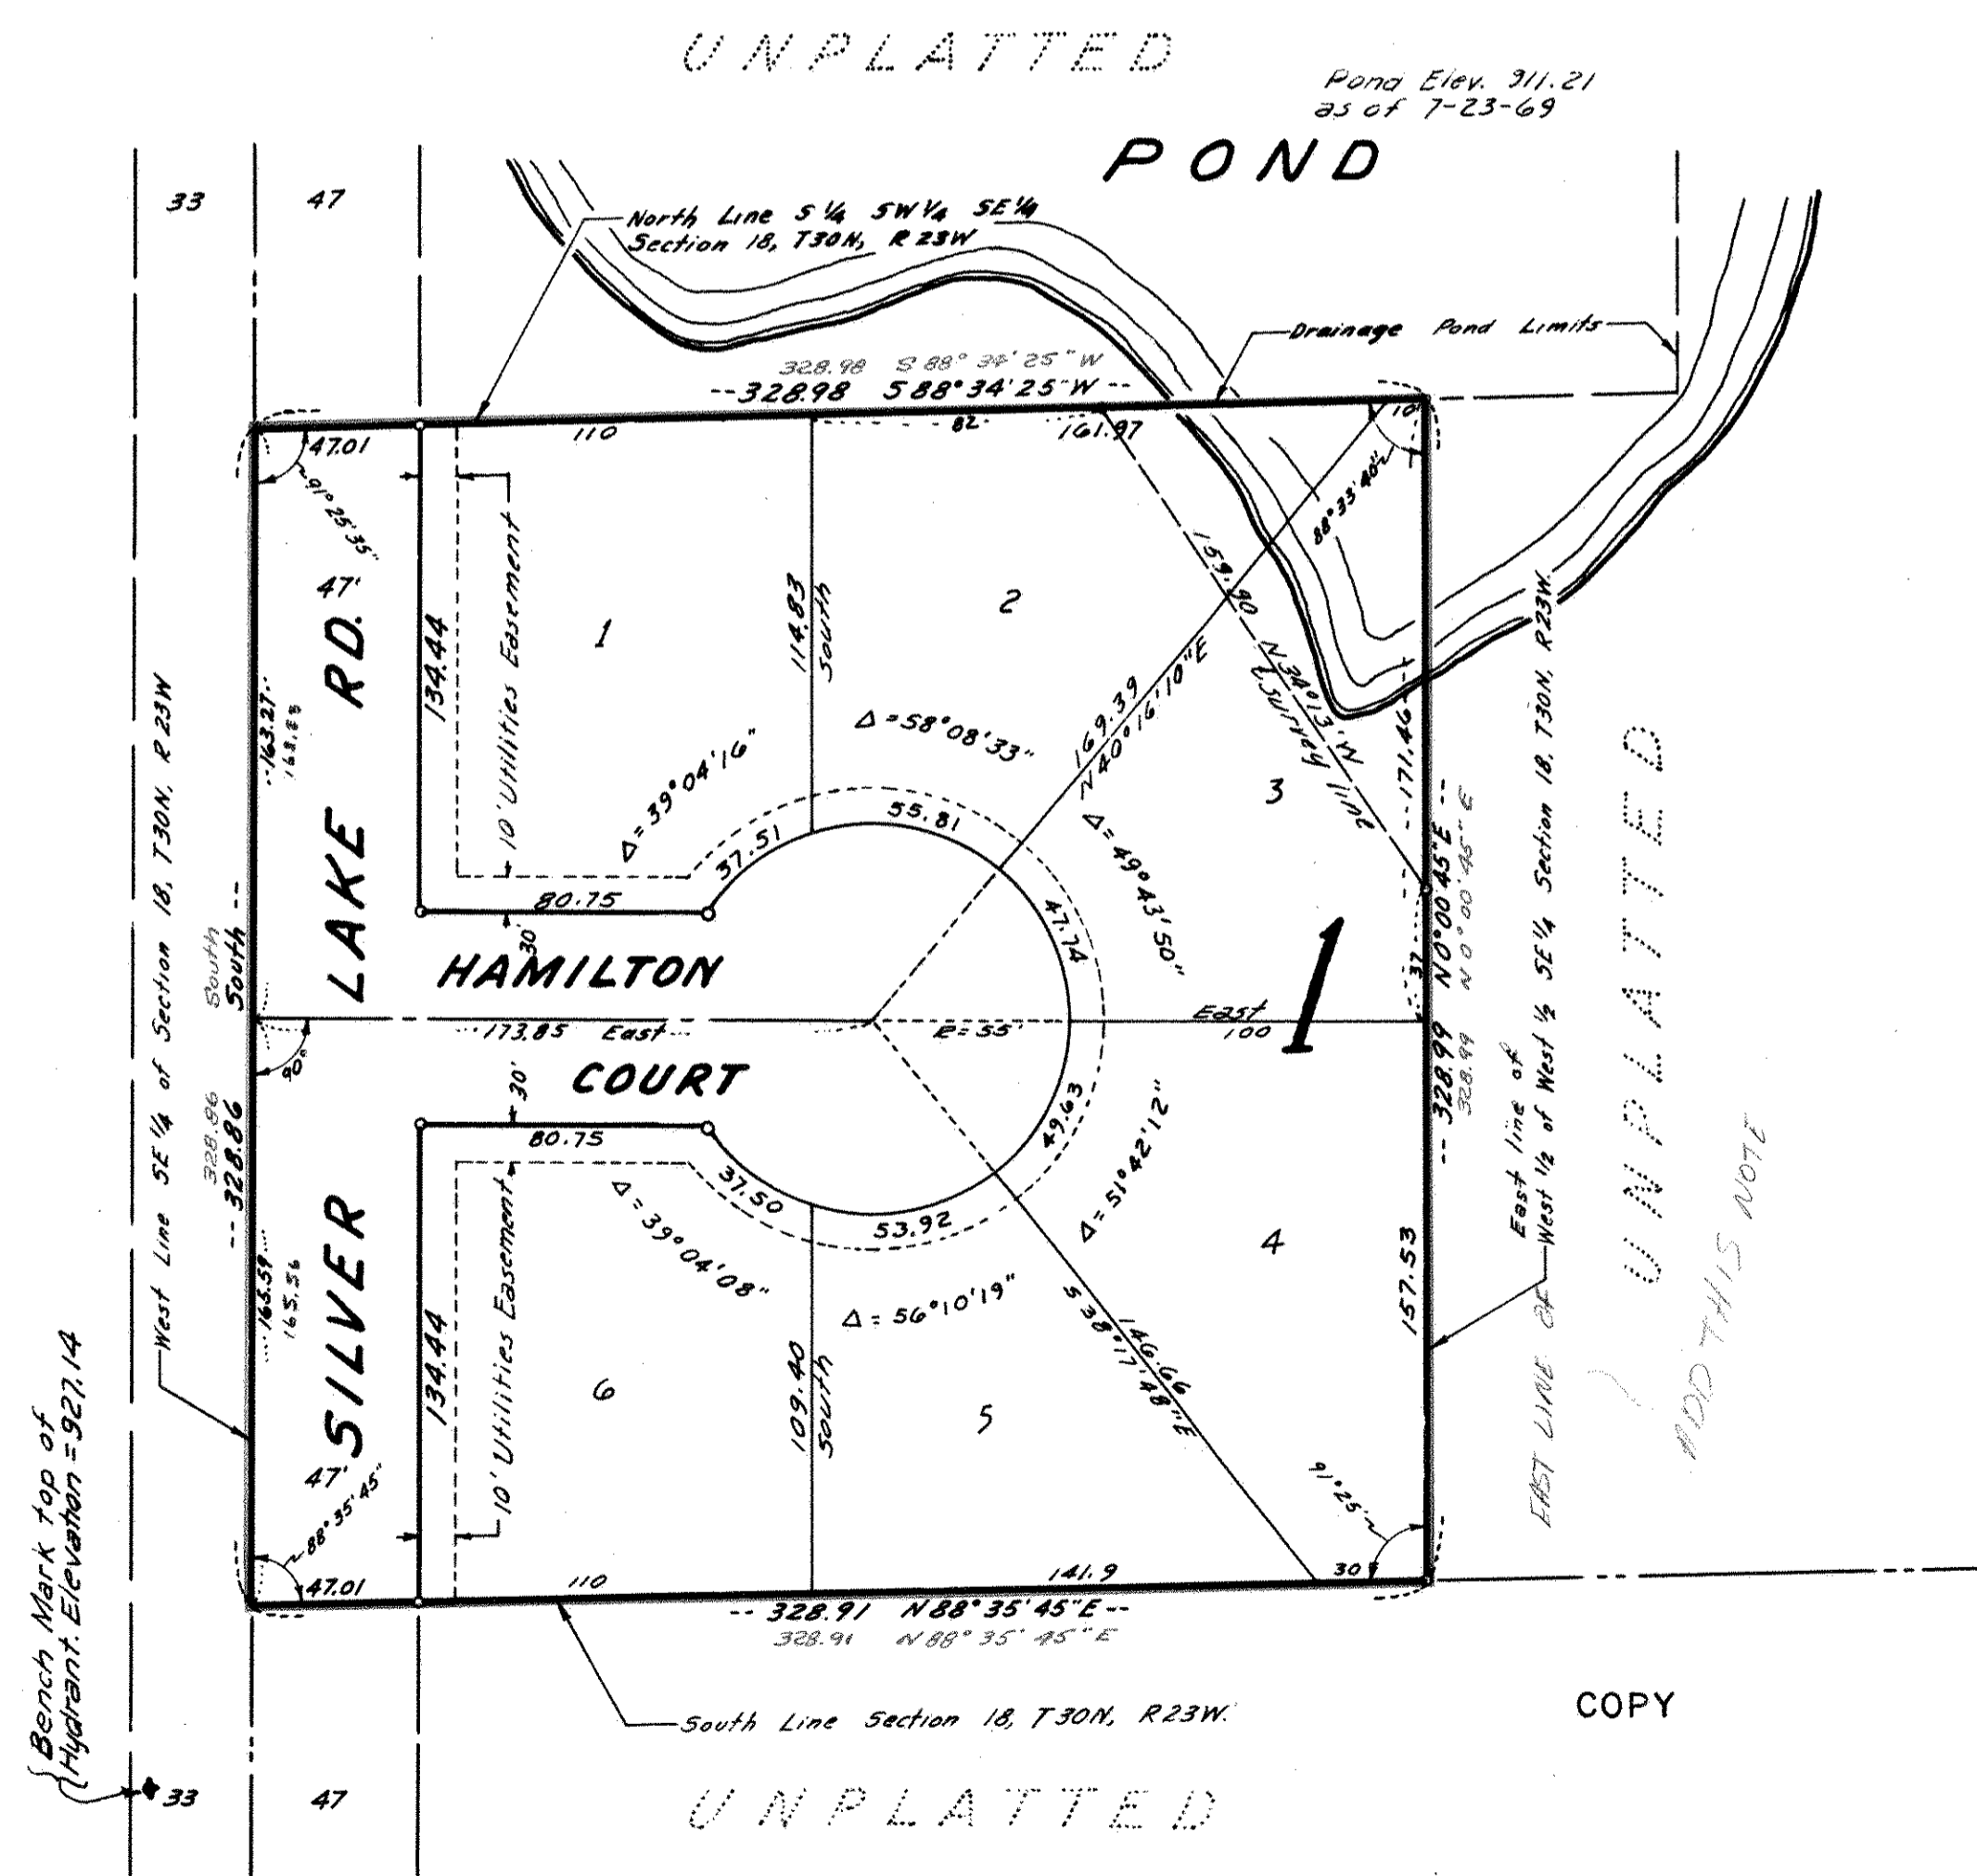

COPY