


# Cole's Rearrangement

OF BLOCK I AND BLOCK 2.

and  
Subdivision and Enlargement of Block No 3  
of this

RANDOLPH STREET AND PLEASANT AVENUE  
ADDITION TO ST PAUL

SCALE 100 FT. = ONE INCH.

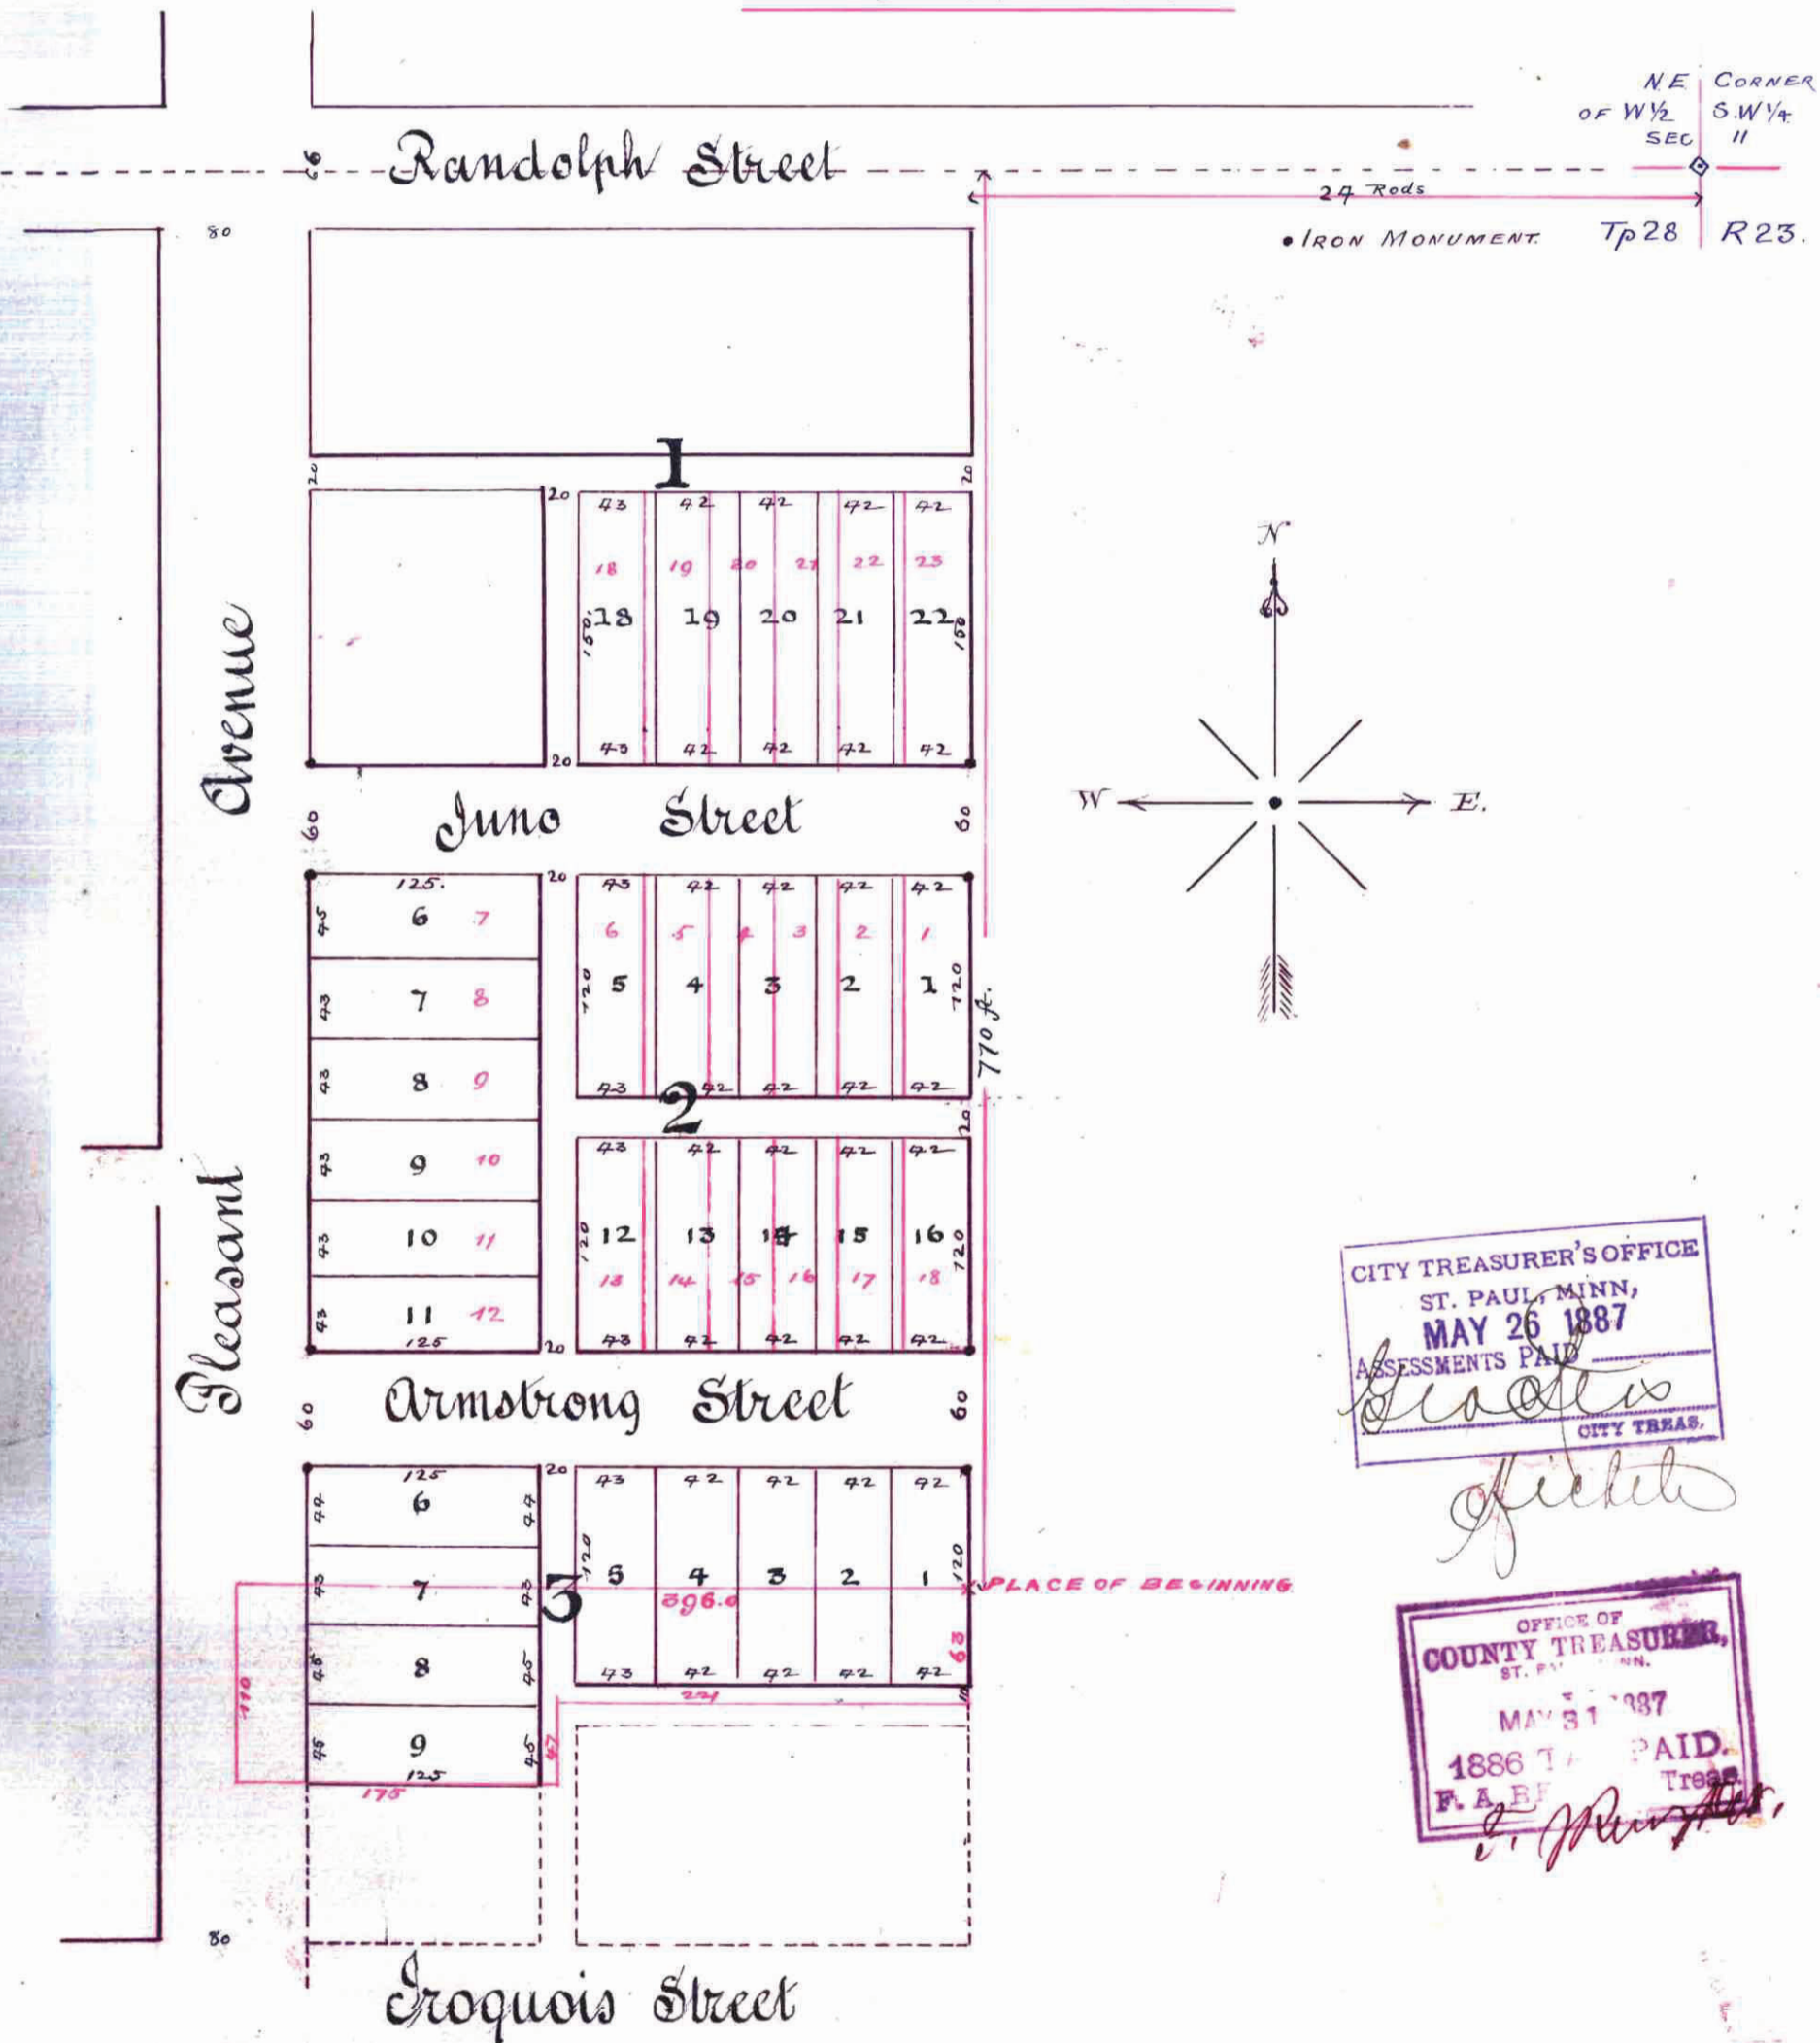

CITY TREASURER'S OFFICE  
ST. PAUL, MINN.  
MAY 26 1887  
ASSESSMENTS PAID  
*[Signature]*  
CITY TREAS.

OFFICE OF  
COUNTY TREASURER  
ST. PAUL, MINN.  
MAY 31 1887  
1886 TAX PAID  
F. J. [Signature]  
Treas.

This plat document is an UNOFFICIAL copy of a Subdivision Plat or Registered Land Survey and is made available for information purposes only.

To obtain an official copy please contact the Ramsey County Recorder's Office.



27

We hereby Certify to having surveyed and platted the property as described on this map as Cole's rearrangement of block 1 and block 2 and subdivision and enlargement of block 3 of his Randolph Street and Pleasant Avenue addition to Saint Paul and have placed iron monuments at the corners of each and every block as shown on this map and the same is correct.

*[Signature]*  
Richard H. Skuse  
Surveyors.

State of Minnesota

County of Ramsey } On this 20<sup>th</sup> day of May A. D. 1887 personally appeared before me the undersigned J. F. Gravel and Richard H. Skuse to me well known and acknowledged that they executed the foregoing Certificate as their own free act and deed.

J. F. Gravel  
Notary Public, Ramsey Co. Minn.

This is to certify that Myron W. Cole and Catherine V. Cole his wife proprietors of Cole's Randolph Street and Pleasant Avenue Addition to the City of St Paul and of an enlargement thereof beginning at the S.E. corner of said addition and running thence and parallel to the north line of section 11 T<sup>28</sup> R<sup>23</sup> three hundred and ninety six 396 feet thence south and parallel to the west line of said section 11. One hundred and ten feet (110) thence east and parallel to the north line of said section 11. One hundred and seventy five feet thence north and parallel to the west line of said section 11. forty seven (47) feet thence east and parallel with the north line of said section 11. 221 feet two hundred and twenty one feet thence north and parallel with the west line of said section 11. Sixty three (63) feet to the place of beginning. Have caused the same to be re surveyed and hereafter know as Cole's rearrangement of block 1 and block 2 and subdivision and enlargement of block 3 of his Randolph St and Pleasant Avenue Addition to St Paul as shown by this plat and hereby dedicate to the public and for the public use forever, all the streets and alleys as herein indicated.

Witness our hands and seals this 20<sup>th</sup> day of May A. D. 1887.

In the presence of  
*[Signature]*  
J. F. Gravel

*[Signature]* Myron W. Cole  
*[Signature]* Catherine V. Cole

State of Minnesota

County of Ramsey } On this 20<sup>th</sup> day of May A. D. 1887 personally came before me the undersigned Myron W. Cole and Catherine V. Cole his wife to me well known and they acknowledged that they executed the foregoing Certificate for the uses and purposes therein expressed.

J. F. Gravel  
Notary Public, Ramsey Co. Minn.

Accepted and approved this 23<sup>rd</sup> day of May A. D. 1887.

*[Signature]* S. P. Folsom  
*[Signature]* J. A. Startay  
*[Signature]* Wm. A. Knudsen  
Plat Commissioners

Accepted by the Common Council of the City of St Paul, on the 25<sup>th</sup> day of June 1887.

Taxes paid & transfer entered June 1, 1887  
*[Signature]* M. J. Kain  
City Clerk.

County Auditor Ramsey Co. Minn.  
*[Signature]* P. C. Harrow

STATE OF MINNESOTA }  
County of Ramsey }  
Office of the Register of Deeds.  
This is to certify that the within instrument was filed for Record in this Office, at St. Paul, on the 12<sup>th</sup> day of June A. D. 1887 at 2:25 of P. M. and that the same was duly recorded in Book... of... pages...  
*[Signature]*  
By: \_\_\_\_\_