


FAIRCHILD & HOWARD'S

REARRANGEMENT of part of TRACY'S OUTLOTS.

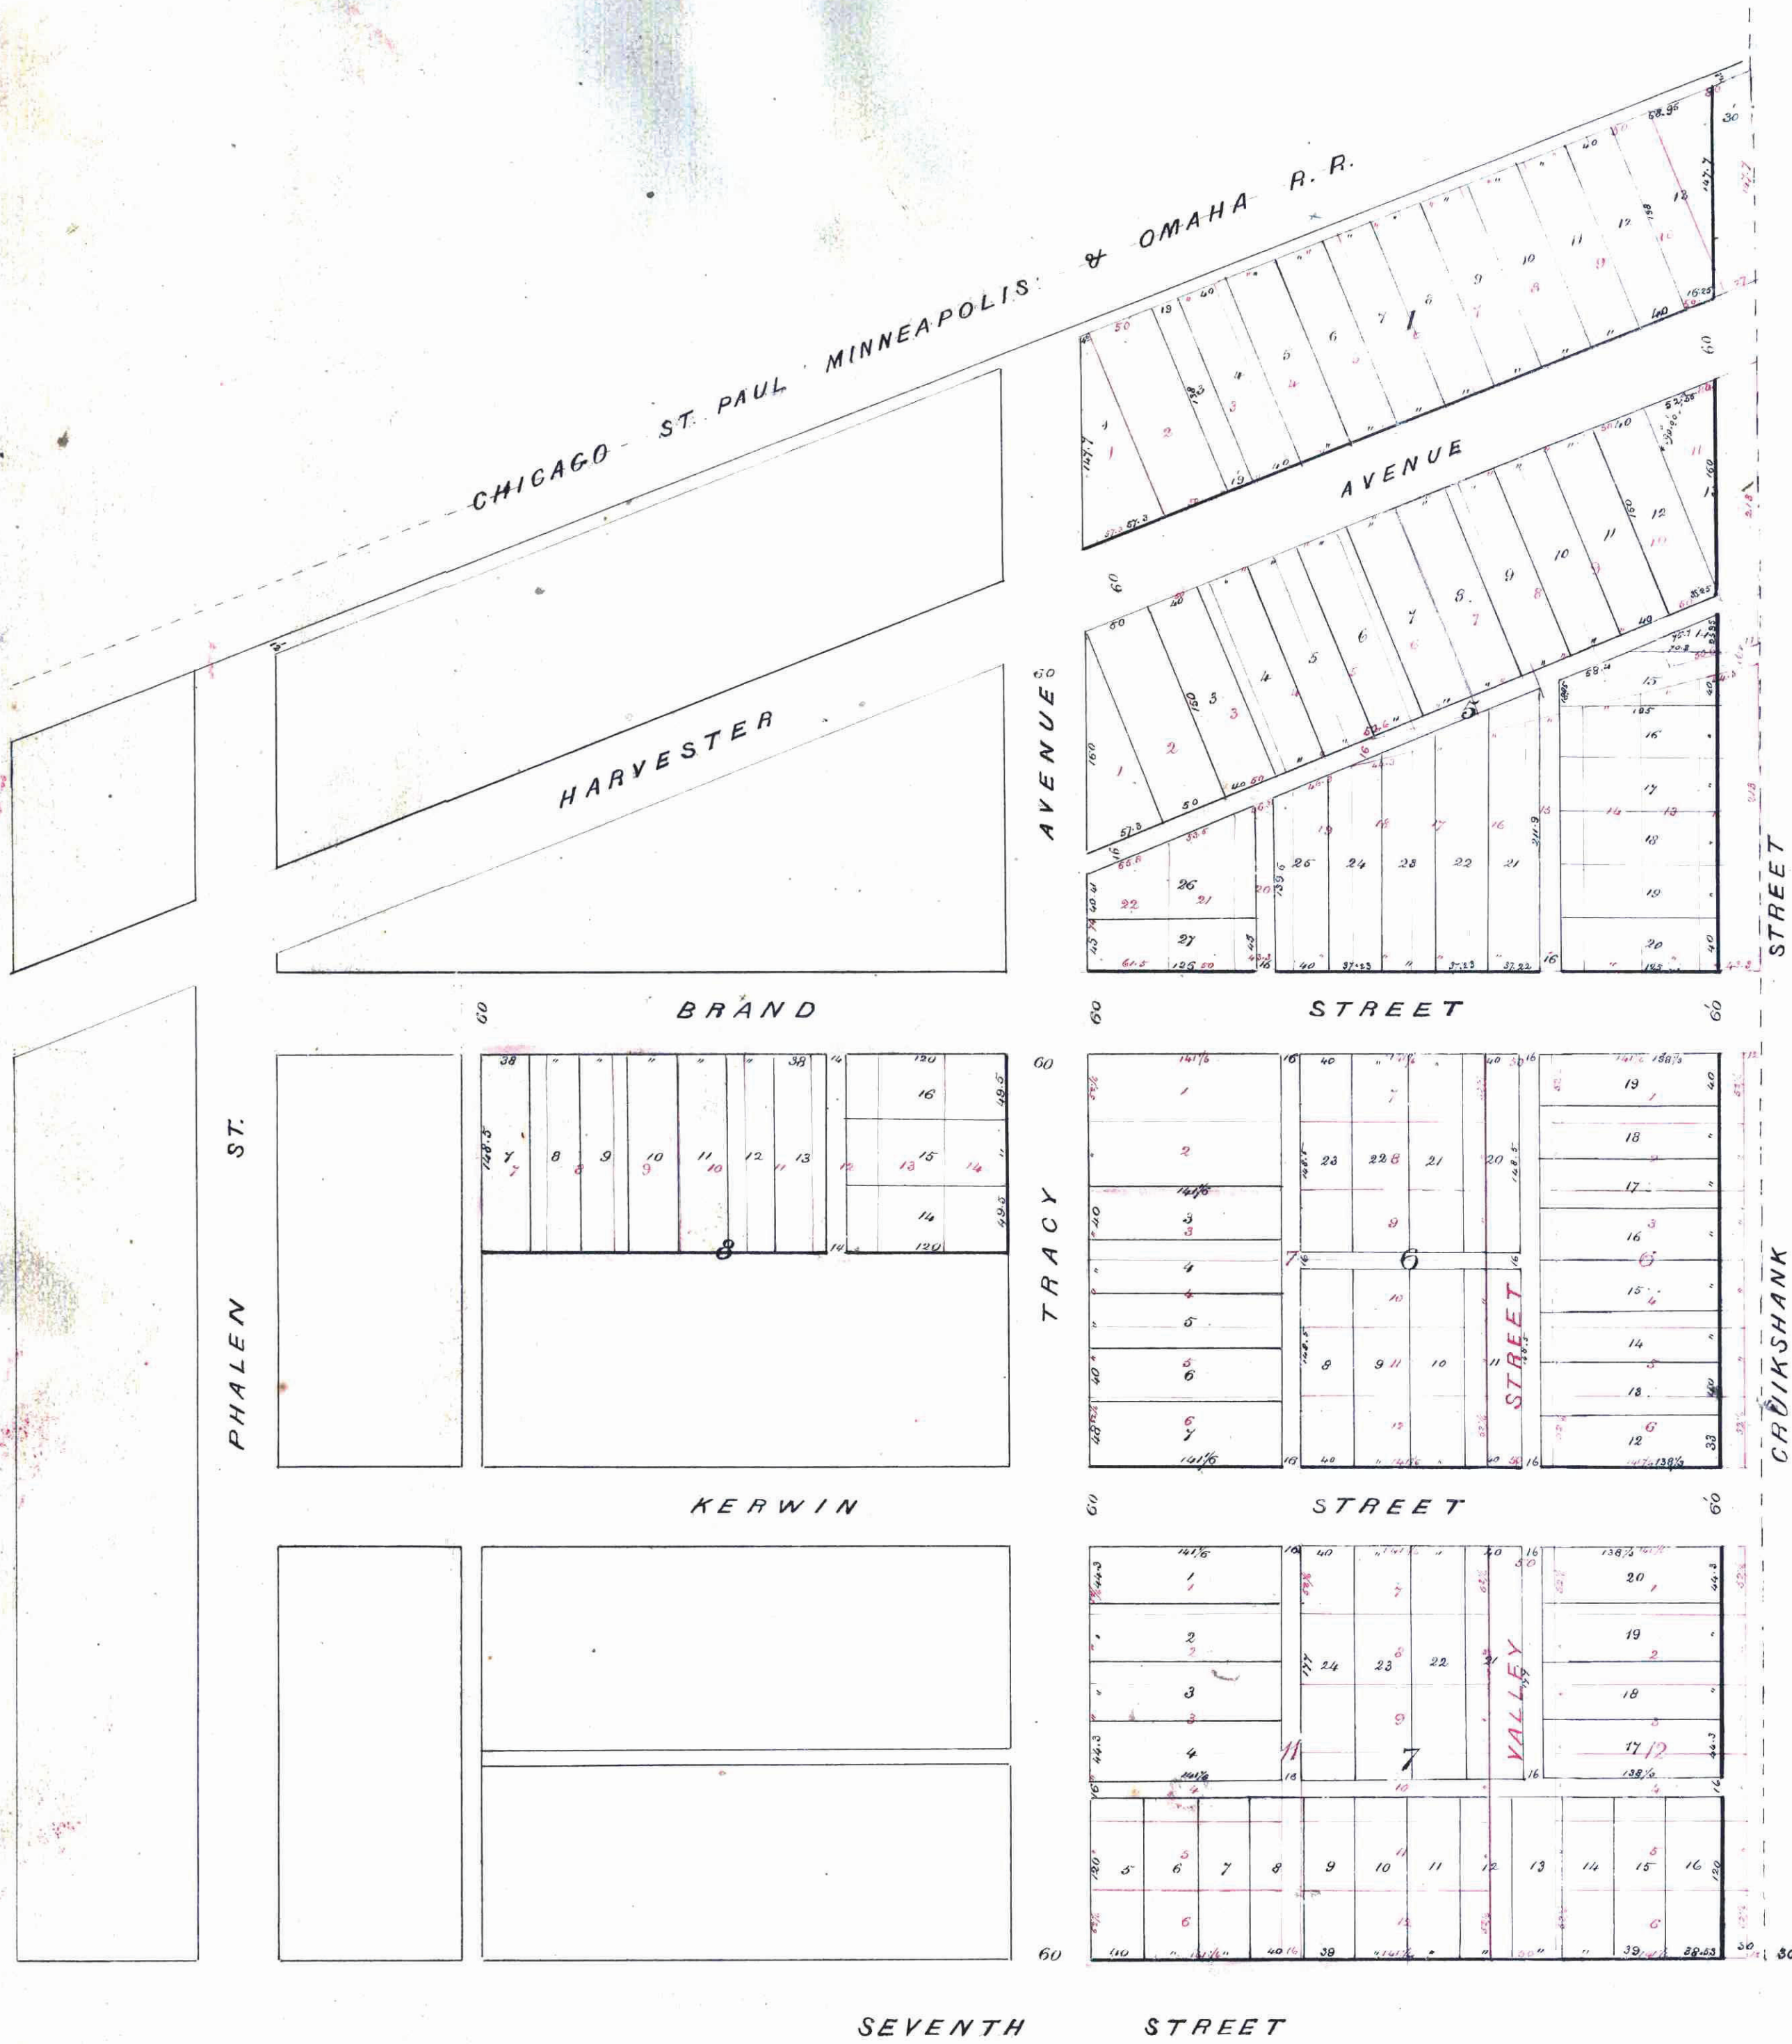

We hereby certify to having surveyed and platted the property as described on this map as Fairchild and Howard's rearrangement of part of Tracy's outlots; and the same is correct.

Wm. J. Nichols & Son
Surveyors

State of Minnesota
County of Ramsey

On this 23rd day of November A.D. 1886 personally appeared before me the undersigned Thomas J. Nichols, one of the firm of J. F. Nichols & Son to me well known and acknowledged that they executed the foregoing certificate as their own free act and deed.

Charles C. Fairchild
Notary Public
Ramsey County Minnesota

This is to certify that Henry J. Fairchild and Elizabeth M. Fairchild his wife and Wilbur H. Howard and Ada S. Howard his wife, all of the City of St. Paul, Ramsey County, Minnesota, Proprietors of Block One (1) except Lots One (1) & Two (2); Block Six (6) except Lots One (1) & Two (2); Block Seven (7) except Lots One (1) and Two (2); Part of Block Eight (8) consisting of Lots Seven (7), Six (6) & Four (4) inclusive; and Blocks Eleven (11) and Twelve (12) of Tracy's Outlots City of St. Paul, Ramsey County, Minnesota which comprise Fairchild & Howard's rearrangement of part of Tracy Outlots as shown by this Plat, hereby dedicate to the public and for the public use for ever all the streets, avenues & alleys as herein indicated.

Witness our hands and seals this 23rd day of November 1886

In presence of

Henry J. Fairchild
Elizabeth M. Fairchild
Wilbur H. Howard
Ada S. Howard

State of Minnesota
County of Ramsey

On this 23rd day of November A.D. 1886 personally came before me the undersigned Henry J. Fairchild & Elizabeth M. Fairchild his wife and Wilbur H. Howard and Ada S. Howard his wife to me well known and who acknowledged that they executed the foregoing certificate for the uses & purposes therein expressed and as their own free act and deed.

Charles C. Fairchild
Notary Public
Ramsey County Minnesota

I hereby recommend the acceptance of the within plat by the Common Council

L. W. Rundlett
City Engineer

Accepted by the Common Council of the City of St. Paul on this 17th day of May 1887

Wm. A. Henderson
City Clerk

Accepted and approved this 27th day of November A.D. 1886

Wm. A. Henderson
Plat Commissioner

Taxes - Paid June 3rd 1887
M. A. Kain
County Auditor
Ramsey County Minnesota

Assessments
CITY TREASURER'S OFFICE
ST. PAUL, MINN.
MAY 19 1887
ASSESSMENTS PAID
Wm. A. Henderson
City Treasurer
St. Paul.

OFFICE OF COUNTY TREASURER, ST. PAUL, MINN.
JUN 3 1887
1886 TAX PAID.
F. A. RENZ, Co. Treas.

This plat document is an UNOFFICIAL copy of a Subdivision Plat or Registered Land Survey and is made available for information purposes only.

To obtain an official copy please contact the Ramsey County Recorder's Office.

STATE OF MINNESOTA,)
County of Ramsey,) ss.
Office of the Register of Deeds.
This is to certify that the within instrument was filed for Record in this Office, at St. Paul, on the ... day of ... A. D. 1887, at ... o'clock ... M., and that the same was duly recorded in Book ... of ... of ... plat pages ...

Wm. A. Henderson
Register of Deeds.